



**ADDENDUM NO. 1**  
**10/29/2025**

**PROJECT: HAMILTON ISD**  
**ROCK GYM & JH GYM RENOVATION**

**BID DATE: 11/04/2025**



The following changes and/or additions shall be made to the Plans, Specifications, and Contract Documents for the above referenced project. Bidder shall acknowledge receipt of this Addendum on the Construction Costs Form.

**GENERAL**

- Item #G1** Pre-Bid Sign-in Sheet
- Item #G2** Hamilton ISD Logo - .PNG file (emailed with Addendum and can be downloaded at
- Item #G3** [www.jacobmartin.com](http://www.jacobmartin.com))
- Item #G4** Substitution Request – Approved Aacer Sports Flooring Substitution Request – Approved Elite Storage Products

**SPECIFICATIONS**

- Item #S1** 00 42 00 - Proposal Form - Added ALTERNATE FOUR SCHEDULE
- Item #S2** 01 10 00 – Summary – Added Section 1.6 WORK SEQUENCE
- Item #S3** 01 21 00 – Allowance – Revised Section 1.5 ALLOWANCES
- Item #S4** 01 23 00 – Alternates – Added ALTERNATE FOUR
- Item #S5** 07 95 13 – Expansion Joint Covers Assemblies – Added
- Item #S6** 11 66 23 – Gymnasium Equipment - Added

**DRAWINGS** A2.1 – ENLARGED DEMO FLOOR PLAN – ROCK GYM

- Item #D1** Added Note: “DO NOT DRIVE/ OPERATE EQUIPMENT ON EXISTING WOOD STRUCTURE/ FLOOR”
- Alternate 4 Added



- Item #D2**      A2.4 – FLOOR PLAN – ROCK GYM
- Added Details 2 & 3 – Interior Elevations Rock Gym
- Alternate 4 Added
- Item #D3**      A2.5 – UPPER PLAN – ROCK GYM
- Added Note: “DO NOT DRIVE/ OPERATE EQUIPMENT ON EXISTING WOOD STRUCTURE/ FLOOR”
- Alternate 4 Added
- Added PT-05 to Finish Legend
- Added Details 2 & 3 – Interior Elevations Rock Gym
- Item #D4**      A2.6 – ENLARGED FLOOR PLANS – JH GYM
- Added Section Mark – Expansion Joint Detail
- Locker Room Names: Clarification
- Item #D5**      A2.8 – FINISH SCHEDULE & ENLARGED ALTERNATE FLOOR PLANS
- Revised Finish Schedule
- Added PT-05 to Finish
- Legend Alternate 4 Added
- Item #D6**      A2.9 – PARTITION TYPES
- Added Detail 10 – JH GYM EXPANSION JOINT
- Item #D7**      A4.1 – EXTERIOR ELEVATIONS – ROCK GYM
- Added missing upper window infills
- Item #D8**      A4.2 – EXTERIOR ELEVATIONS – JH GYM
- Added note and detail for Tilt Wall Panel joints – remove and replace existing caulk & backer rod.



- Item #D9** A8.0 – ROOF PLANS  
Revised ROOF PLAN GENERAL NOTES  
Added Roof Notes on Rock Gym Roof and JH Gym Roof
- Item #D10** S1.0 – DEMO PLAN – JH GYM – MODIFIED sheet name. MODIFIED note at existing tilt wall to include shoring before demolition of slab
- Item #D11** S1.1 – ROCK GYM DEMO PLAN – MODIFIED demo notes to clarify that only the existing wood decking be removed and not the wood joists until EOR inspection. MODIFIED demo notes clarifying to demo wood decking back to the closest adjacent existing joist to the court floor at locations where the demo boundary runs parallel to the existing joists.
- Item #D12** S1.2 – JH GYM FOUNDATION PLAN – MODIFIED sheet name. ADDED detail 9/S3.0 at the boundary of existing slab on grade and new suspended slab. ADDED note to replace existing x-bracing at PEMB frames that was previously cut.
- Item #D13** S1.3 – ROCK GYM FOUNDATION PLAN – MODIFIED new joists to be 2x12 to match existing joists. ADDED detail 11/S4.0 at locations where the demo boundary runs parallel to the existing joists.
- Item #D14** S2.0 – MEZZANINE FRAMING PLAN – JH GYM – MODIFIED sheet name. ADDED note to provide small openings in composite deck where existing braced frame cables that have been cut will be replaced. Provided clarification to where existing reinforced beam details apply at the existing weightroom roof with new RTU's.
- Item #D15** S3.0 – FOUNDATION DETAILS – ADDED detail 9/S3.0 for boundary connection between existing slab on grade and the new suspended slab. MODIFIED detail 8/S3.0 to dowel new grade beam into the existing tilt wall. MODIFIED detail 6/S3.0 to dowel new grade beam into the existing tilt wall.
- Item #D16** S4.0 – FRAMING DETAILS – ADDED detail 11/S4.0 for boundary condition between new gym flooring and existing gym flooring. ADDED note to 9/S4.0 for joist attachment to sill plate.
- Item #D17** S5.0 – TYPICAL 8" CMU DETAILS – ADDED detail 7/S5.0 for new channel connection to the existing CMU wall at the weightroom

## **QUESTIONS**

- Item #Q1** Question 001 - LAVS 104 & 109 and BOY'S TOILETS 105 & GIRL'S TOILETS 108 show to be LVT-01 on the Room Finish Legend however on the Room Finish Schedule these are called to be RES-01. Can you please clarify which flooring will be going in these areas?



Response: Refer to revised sheet A2.8 FINISH SCHEDULE AND ALTERNATE ENLARGED FLOOR PLANS, in this Addendum.

**Item #Q2** QUESTION 002 - Can you please provide the artwork for the Bulldog logo in the Jr. High Gym?

Response: .PNG File is provided in this Addendum.

**Item #Q3** QUESTION 003 - On page A2.2 there is an opening on the west side that needs to be cut in the existing wall for door 117D, is this part of allowance 02 41 00 or is this opening to be in base bid?

Response: The Allowance is for the enlargement and infill for the construction access opening. Doors 117C and 117D are in Base Bid.

**Item #Q4** QUESTION 004 - Where do details 6 and 8 from sheet S4.0 occur at? For detail 6 how many beams are there and what is their length?

Response: See Addendum 1 sheet S2.0 for clarified drawings of existing roof structure that will be reinforced per details 6,8/S4.0. There are 3 beams that are approximately 48' long.

**Item #Q5** QUESTION 005 - Hello, I'm trying to find the specs for any athletic flooring on this project. Any information is appreciated!

Response: Please refer to the Program Manual Section 09 64 66 – Wood Athletic Flooring.

**Item #Q6** QUESTION 006 - Can the existing fire extinguishers be recharged or do they all need to be replaced?

Response: The existing fire extinguishers were recertified this year (2025) and will be reused.

**Item #Q7** QUESTION 007 - Is there an existing fire suppression system that is to remain or will this need to be all new?

Response: There is not an existing fire suppression system. According to the 2018 Existing Building Code this renovation does not require a fire suppression system to be added.





**Item #Q8** QUESTION 008 - At the pre bid conference it was mentioned that construction will need to be completed in phasing and timing to accommodate scheduled school tournaments. Can you please provide your intentions for phasing and completion dates for each building?

Response: Refer to the revised spec Section 01 10 00 SUMMARY in this Addendum. Added Section 1.6 "Work Sequence".

**Item #Q9** QUESTION 009 - Per sheet A1.0 Site General Note E does the school district already have a surveyor they are using or will we need to include a surveyor in our proposal?

Response: Survey is provided by Jacob & Martin.

**Item #Q10** QUESTION 010 - Is the existing fire alarm system a Carehawk system? If not, what is the manufacture of the existing system?

Response: Existing Fire Alarm System - Gamewell by Honeywell.

**Item #Q11** QUESTION 011 - On page A2.6 there is a note on each end of the gym that says 20' 8" of wall pads are these reinstalled from A2.2 note 11? If not please provide information.

Response: No, the existing Wall Pads will not be reused. Please refer to Spec Section 11 66 23 Gymnasium Equipment included in this Addendum.

**Item #Q12** QUESTION 012 - 1) Do you have any details of the existing structural slab at the JR High Gym? We can't seem to find any information on the size and depth and reinforcing of the existing slab and foundation 2) In sheet S3.0/Det 6 it shows to remove slab. What is the design to support column for PEMB while we remove the slab & foundation under?

Response: The existing slab is 4" thick with #3 @ 18" o.c.e.w.

**Item #Q13** QUESTION 013 - 1. What type of material will go behind the lockers? FRP? Paint? 2. For quoting purposes when would the lockers need to be on site? 3. Looking at Page A2.7 Boys Toilets 120A. Marking #3 is a Sanitary Napkin Disposal....Do they really want those in the Boys Restroom? 4. Will there be any type of virtual bid opening link for those who can't be there in person? If not will a bid tabulation be provided? 5. Sheet A6.0 indicates an HISD logo please confirm if the logo is to be painted directly onto the surface or should the logo be furnished and installed as a separate applied graphic or vinyl decal? If it is a vinyl or applied graphic please confirm required material color and approved manufacturer.

Response: 1. Refer to Sheet A2.7 for Partition Types behind lockers  
2. Refer to Revised Section 01 10 00 SUMMARY included in this Addendum.  
3. Yes, Sanitary Disposal in 120A, Locker Room will be used as Visitor Girls



Locker Room during JH Girls basketball games.

4. No virtual bid opening. Yes, Bid tabulations will be provided as requested.
5. Logo Graphic to be painted directly onto the surface.

**Item #Q14** QUESTION 014 - Reaching out to inquire about some additional information for the Hamilton ISD Rock Gym Sheet S1.1. To what extent does the wood decking need to be exposed just where the red dash lines make a U shape of Sheet S1.1? The red dash lines technically go all the way around the gym flooring that is to remain on that sheet.

Response: The floor decking around the boundary of the court floor was previously redone and there is a joint on the court floor at that location all the way around the court. The floor decking will be demolished from this joint out to the surrounding walls of the rock gym around the entire court. See Addendum 1 S1.1 for further clarification.

**Item #Q15** QUESTION 015 - Please provide additional information clarifying the scope of work concerning the existing roof penetrations at both gyms. Are the roof vents to remain or should they be removed and the roof be patched? Please provide the roof material and manufacturer for both gyms.

Response: Refer to revised sheet A8.0 ROOF PLAN, included in this Addendum

**Item #Q16** QUESTION 016 - In sheet S3.0/Det 6 it shows to remove slab. What is the design to support column for PEMB while we remove the slab & foundation under?

Response: The existing slab will be removed but the existing pilasters and piers supporting the PEMB frames are to remain.

**END OF ADDENDUM 1**

**HAMILTON ISD  
ROCK GYM AND JUNIOR HIGH GYM RENOVATIONS  
SIGN-IN SHEET  
OCTOBER 21, 2025 / 10:30 AM**

Name	Company	Email Address	Telephone #
1. Tim Hopkins, AIA, NCARB	Jacob & Martin, LLC	thopkins@jacobmartin.com	325-695-1070
2. Justin Cozby	COZBY ELECTRIC	justincozby@yahoo.com	254-688-0127
3. Ken Maynard	Maynard const service	Ken@maynardcs.com	512-924-5279
4. <del>LENNY B.</del> Lenny B.			
5. Jimmy Cardona	reserved		
6. Sean James	HMC		216-380-7053
7. Terri Haskell	HCS	bits@hcs-gc.com	254-829-3200 325-695-0427
8. Steve Justice	Justice Construction	steve@justiceconstruction.com	
9. DAN JOHNSON	RKJ Const. Inc, GC.	djohnson@rkjco.com	512-556-3684
10. Nathan Radabaugh	Radabaugh Plumbing	RadabaughPlumbing@gmail.com	512-525-5834
Ron Norman	Bounds Commercial Construct	norman@boundsec.com	
Jesse Pera	Texas Construction	jesse@texasconstruction.com	972-741-7110
DAVID WALKER pg. 1	STEPHENVILLE HEAT AND AIR	DAVID@STEPHENVILLEHEATANDAIR.COM	469-258-5021 254-965-4644
Trey Anvenshine	IronHorse Plumbing	ironhorse-mps@yahoo.com	1-254-965-6789
Kevin Biasioli	WALDROP CONSTRUCTION	kevin@waldropconstruction.com	325-998-3015

<u>Name</u>	<u>Company</u>	<u>Telephone #</u>
11. MEL PERERA	DALLAS MECHANICAL Group	214-912- <sup>4209</sup> <del>7269</del>
12. COLBY DAUENHAUER	NAE CONTRACTING	817 384 7170
13. MIKE KELLEY	NAE CONTRACTING	817 991-6040
14. David Rios	CWS ELEC/HVAC	254-931-0077
15. DAVID WALKER	STEPHENVILLE HEAT AND AIR	254-965-4644
16. Freddy PUGANA	RYMAR Construction	512-971-4186
17. EVAN BOPELLO	RYMAR Construction	<del>512</del> -713-4615
18. Ron Norman	Bounds Commercial Construction	972-741-7110
19. Jesse Penn	Texas Construction	469 258 5021
20. Witt Holloway	Tenert Construction	325 640 6538
21. Bryan Knox	James Lane Fire Protection	940 923 9065
22. Kevin Evans	James Lane FP	817-271-1933
Justin Bostich	AML Environmental	325-261-1155
Michael Rogers	AML Environmental	325-721-0430
Corey Robertson	Montgomery Roofing	254-216-9881
Justin Ketchum	Texas Cutting & Coring	512-627-9346
PG. 2 Keaton Trikke	keaton@SCS-TX.com	254-434-2324
Hunter Hillingsworth	Sullivan Contracting	254-434-2324
PAT MAWONE	ACDI Contractors	469 657 5929

**SECTION 00 43 25 - SUBSTITUTION REQUEST FORM**

**TO: JACOB|MARTIN**

PROJECT:  
Wood Athletic Flooring

SPECIFIED ITEM:  
Bio-Cushion Classic

Section Page Paragraph Description

The Undersigned requests consideration of the following:

**PROPOSED SUBSTITUTION:** AcerFlex by Acer Sports Flooring

Attached data includes product description, specifications, drawings, photographs, performance and test data adequate for evaluation of the request; applicable portions of the data are clearly identified.

Attached data also includes description of changes to Contract Documents which proposed substitution will require for its proper installation.

The undersigned states that the following paragraphs, unless modified on attachments, are correct:

1. The proposed substitution does not affect dimensions shown on Drawings.
2. The undersigned will pay for changes to the building design, including engineering design, detailing and construction costs caused by the requested substitution.
3. The proposed substitution will have no adverse effect on other trades, the construction schedule, or specified warranty requirements.
4. Maintenance and service parts will be locally available for the proposed substitution.

The undersigned further states that the function, appearance and quality of the proposed substitution are equivalent or superior to the specified item.

Submitted by:

Signature: Suzanne Hansen

Firm: Acer Sports Flooring

Address : 701 E. Elm St  
Crandon, WI 54520

Date: 10/23/25

Telephone: (920) 716-6678

FAX: \_\_\_\_\_

**For use by Architect**

<input type="radio"/> Accepted	<input checked="" type="radio"/> Accepted as noted
<input type="radio"/> Not Accepted	<input type="radio"/> Received to late
By: <u>Tim Hopkins</u>	
Date: <u>10/23/25</u>	
Remarks: <u>Be aware of existing conditions: floor structure is 2x wood framing</u> <u>and not concrete with recessed area for court floor. Adjust</u> <u>proposed court floor system accordingly.</u>	



**SECTION 00 43 25 - SUBSTITUTION REQUEST FORM**

**TO: JACOB|MARTIN**

PROJECT: Hamilton ISD - Rock Gym & JH Gym Renovations

SPECIFIED ITEM:

10 51 00- Lockers                      Metal, Phenolic and HDPE Lockers

Section    Page    Paragraph    Description

The Undersigned requests consideration of the following:

**PROPOSED SUBSTITUTION:** LockersMFG All Welded, Phenolic and HDPE lockers

Attached data includes product description, specifications, drawings, photographs, performance and test data adequate for evaluation of the request; applicable portions of the data are clearly identified.

Attached data also includes description of changes to Contract Documents which proposed substitution will require for its proper installation.

The undersigned states that the following paragraphs, unless modified on attachments, are correct:

1. The proposed substitution does not affect dimensions shown on Drawings.
2. The undersigned will pay for changes to the building design, including engineering design, detailing and construction costs caused by the requested substitution.
3. The proposed substitution will have no adverse effect on other trades, the construction schedule, or specified warranty requirements.
4. Maintenance and service parts will be locally available for the proposed substitution.

The undersigned further states that the function, appearance and quality of the proposed substitution are equivalent or superior to the specified item.

Submitted by:

Signature: Christopher Ybos

Firm: Elite Storage Products

Address :

60 Front St. Rossville, TN 38066

Date: 10/22/2025

Telephone: 901-457-4430

FAX: \_\_\_\_\_

**For use by Architect**

<input checked="" type="radio"/> Accepted	<input type="radio"/> Accepted as noted
<input type="radio"/> Not Accepted	<input type="radio"/> Received to late
By: <u>Tim Hopkins</u>	
Date: <u>10/27/25</u>	
Remarks: _____	
_____	
_____	



## Locker Product Comparison

	<b>LockersMFG All-Welded Metal Locker Series</b>	<b>Art Metal Products Welded Lockers</b>
Top	16ga	16ga
Back	18ga	18ga
Side	16ga	16ga
Bottom	16ga	16ga
Door	14ga	14ga
Door Frame	14ga Spot Welded	14ga Spot Welded
Shelf	16ga	16ga
Handle	Recessed, Single Point	Recessed, Single Point
Lock Compatible	Yes	Yes
ADA Compliance	1T, 2T - Yes	1T, 2T - Yes
Ventilation	Meets Specs	Meets Specs
Interior Equipment	16ga	16ga
Rubber Silencers	Meets Specs	Meets Specs
Hinge	16ga Continuous Hinge or 7-Knuckle	16ga Continuous Hinge
Fillers	16ga	16ga
End Panels	16ga Boxed Style	16ga Boxed Style
Sloped Tops	16ga	16ga
Z-Base	14ga Galvanealed - 2mil N/C	14ga
Pedestals	10ga	11ga
Bench Tops	Hardwood, Lacquered	Hardwood, Lacquered
Finish	2-3 mil Powder Coat	1 mil Powder Coat
Material	Cold Rolled Steel	Cold Rolled Steel
Colors	20 Standard + Custom Colors	21
Warranty	Lifetime	Lifetime
Construction	Welded	Welded
Steel Surcharges	None	12%
Lead Time	8-10 Weeks	10-14 Weeks

Highlights Demonstrate Increase Quality Items

PO Box 208 Como, MS 38619

(662) 338-4340



MANUFACTURING any design. any material. any technology.

## Locker Product Comparison

	<b>LockersMFG Phenolic Locker Series</b>	<b>Hollman Model B1 Phenolic Lockers</b>
Top	3/4 Inch	3/4 Inch
Back	3/4 Inch	3/4 Inch
Side	3/4 Inch	3/4 Inch
Bottom	3/4 Inch	3/4 Inch
Door	3/4 Inch	3/4 Inch
Door Frame	3/4 Inch	3/4 Inch
Shelf	3/4 Inch	3/4 Inch
Door Type	Full Overlay or Z-Style	Full Overlay or Z-Style
Latch	Continuous Latch	Continuous Latch
Lock Compatible	Yes	Yes
ADA Compliance	1T, 2T - Yes	1T, 2T - Yes
Ventilation	Meets Specs	Meets Specs
Interior Equipment	Meets Specs	Meets Specs
Hinge	Concealed Cabinetwork Style	Concealed Cabinetwork Style
Fillers	3/4 Inch	3/4 Inch
End Panels	3/4 Inch	3/4 Inch
Toe Kick Panels	3/4 Inch	3/4 Inch
Sloped Tops	3/4 Inch	3/4 Inch
Size	WxDxH Meets Specs	WxDxH Meets Specs
Material	Solid Phenolic	Solid Phenolic
Hardware	Tamperproof	Tamperproof
Warranty	Lifetime	20 Years
Lead Time	12-16 Weeks	26-32 Weeks

Highlights Demonstrate Increase Quality Items

PO Box 208 Como, MS 38619

(662) 338-4340





## Metal Locker Product Comparison

	LockersMFG HDPE	Bradley HDPE
Top	3/8 Inch	3/8 Inch
Back	3/8 Inch	3/8 Inch
Side	3/8 Inch	3/8 Inch
Bottom	3/8 Inch	3/8 Inch
Door	1/2 Inch	1/2 Inch
Handle for 1T, 2T, 3T	Recessed, multi-point latch	Recessed, multi-point latch
Handle for 6T, 7T, 8T	Door Pull, single point latch	Door Pull, single point latch
Lock Compatible	Yes	Yes
ADA	1T, 2T - Yes	1T, 2T – Yes
Compliance	Meets spec	Meets spec
Door Frame	1/2 Inch	1/2 Inch
Ventilation	Meets spec	Meets spec
Interior Equipment	3/8 Inch	3/8 Inch
Rubber Silencers	Meets spec	Meets spec
Shelf	3/8 Inch	3/8 Inch
Hinge	Continuous HDPE	Continuous HDPE
Fillers	1/2 Inch	1/2 Inch
Z-Base	1/2 Inch	1/2 Inch
Pedestals	10	10
Bench Tops	Hardwood, lacquered	Hardwood, lacquered
Material	HDPE	HDPE
Warranty	Lifetime	Lifetime
Construction	meets spec	meets spec
Size	WxHxD meets spec	WxHxD meets spec
Lead Time	12-16 Weeks	26-32 Weeks

Highlights Demonstrate Increase Quality Items


PO Box 208 Como, MS 38619

(662) 338-4340


The All Welded lockers are a good choice when you need superior resistance to hard use and abuse. All of the components are welded into a single rigid unit to resist damage for the life of the product. It comes with a standard 2 mil thick powder coat, available in 20 colors as well as any custom color.



**1, 2 & 3 TIER**

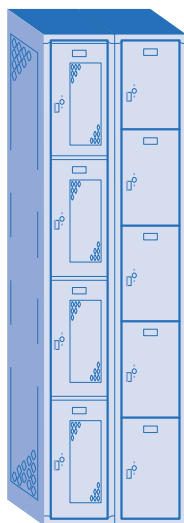

**4 & 5 TIER**

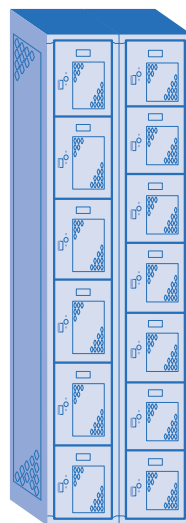

**6 & 8 TIER**



**9 TIER**

## GAUGE REFERENCE

Top	Back	Side	Base	Door	Door Frame	Shelf
16	18	16	16	14	16	16

## HIGH-END FEATURES

- 2 mil thick powder coat baked to cure finish
- Standard recessed handle on 1, 2 and 3 tier and half height locker for added safety and security
- Standard 16 gauge continuous piano type hinges riveted to frame and welded to door
- Continuous door strike has rubber bumpers to reduce noise
- Door frame is spot welded construction
- Standard 14 gauge door with reinforcement hat channel/door stiffener
- Standard 16 gauge bottom
- Single Point Latch with no moving parts, low maintenance, tamper resistant

## VENTILATION

- Diamond Perforations (standard)
- Solid
- Standard Louvers
- Mini Louvers
- Rectangular Perforations

## DOOR HANDLE OPTIONS

- Recessed Handle Multi-Point Latch
- Recessed Handle Single Point Latch
- Door Pull (standard for box lockers)

PRODUCT FEATURES	
Handle :	Continuous Latch W/ Finger Lift
Hinge :	Continuous Plastic Hinge, Full Length Of Door And Body
Bottom :	Solid Phenolic Core, 3/4" Thick
PRODUCT INFORMATION	
Material :	Phenolic
Finish :	Slightly Textured To Reduce Marring
Construction :	Factory-Assembled Flush Overlay Units
Door :	Solid Phenolic Core, 1/2" Thick
Door Stiffener/Reinforcement :	None
Door Frame :	Solid Phenolic Core, 1/2" Thick
Door Ventilation :	Solid
Door Latching :	Spring-Loaded Positive Latch
Top :	Solid Phenolic Core, 3/4" Thick
Side :	Solid Phenolic Core, 3/4" Thick
Back :	Solid Phenolic Core, 1/2" Thick
Shelf :	Solid Phenolic Core, 1/2" Thick
Interior Equipment :	(2) DBL Prong Wall Hooks Per Opening
Number Plate :	Polished Aluminum Plate
Assembly :	Secured By Plastic Welds
ACCESSORY INFORMATION	
Slope Hood :	Slope Hoods
Lock :	None Provided
Legs :	None Provided
Base :	3" Continuous
Recess Trim :	None Provided
Comments:	
Color : Please Advise Within Reasonable Variation	
<div>SAMPLE</div>	

JOB INFORMATION				
Locker Area :	Men's LR 024	Women's 028	B&G LR 041	ENG LR 039
Frame/Openings :	28/28	5/5	5/5	5/5
Product Line :	Phenolic SGL Tier Locker			
Size :	15x15x72"			
Original : 03/05/2025	<div> <div>LOCKERS</div> <div>MANUFACTURING any design. any material. any technology.</div> </div> <div>File: ORD0012183.dwg</div>			
Revised :				
Drawn By : LMK				
Reviewed By : DS				
Page : 1 of 7	Location :	PO# : LOI		

<div> <div>Phenolic</div> <div>Single Tier Locker</div> <div>15 x 15 x 72"</div> <div>L1</div> </div>	
ELEVATION	SECTION
PLEASE BE ADVISED: Lockers Are Square And Measured Based On Square Walls. If Walls Are Not Square, Adjustments To Bases Will Need To Be Made At The Expense Of The Customer To Make Allowances For The Locker Sizes As Specified In The Shop Drawings.	
Tolerances in Manufacturing Understood: Fractions $\pm \frac{1}{16}$ , Decimals $\pm .02$ , Degrees $\pm 20^\circ$	
NOTICE: All Rights Reserved, © 2025. These Drawings Of Products Described Are Subject To All Patents And Copyrights Held By Lockers Manufacturing.	
PLEASE BE ADVISED: Shop Drawings Are To Ensure We Understand Your Request. Your Approval Of These Shop Drawings Overrides Any Other Specifications Or Documentation. Please Check And Approve As We Are Going To Manufacture Material As Shown On These Drawings.	

PRODUCT FEATURES	
Handle :	Continuous Latch W/ Finger Lift
Hinge :	Continuous Plastic Hinge, Full Length Of Door And Body
Bottom :	Solid Phenolic Core, 3/4" Thick
PRODUCT INFORMATION	
Material :	Phenolic
Finish :	Slightly Textured To Reduce Marring
Construction :	Factory-Assembled Flush Overlay Units
Door :	Solid Phenolic Core, 1/2" Thick
Door Stiffener/Reinforcement :	None
Door Frame :	Solid Phenolic Core, 1/2" Thick
Door Ventilation :	Solid
Door Latching :	Spring-Loaded Positive Latch
Top :	Solid Phenolic Core, 3/4" Thick
Side :	Solid Phenolic Core, 3/4" Thick
Back :	Solid Phenolic Core, 1/2" Thick
Shelf :	Solid Phenolic Core, 1/2" Thick
Interior Equipment :	(2) DBL Prong Wall Hooks Per Opening
Number Plate :	Polished Aluminum Plate
Assembly :	Secured By Plastic Welds
ACCESSORY INFORMATION	
Slope Hood :	Slope Hoods
Lock :	None Provided
Legs :	None Provided
Base :	3" Continuous
Recess Trim :	None Provided
Comments:	
Color : Please Advise Within Reasonable Variation	
<div>SAMPLE</div>	

JOB INFORMATION				
Locker Area :	Men's LR 024	Women's 028	B&G LR 041	ENG LR 039
Frame/Openings :	1/2	1/2	1/2	1/2
Product Line :	Phenolic SGL Tier Locker			
Size :	15x15x72"			
Original : 03/05/2025	<div> <div>LOCKERS</div> <div>MANUFACTURING any design. any material. any technology.</div> </div> <div>           Dealer :            Installer :            Contractor :            Job ID :              Location :            PO# : LOI         </div> <div>           File: ORD0012183.dwg         </div>			
Revised :				
Drawn By : LMK				
Reviewed By : DS				
Page : 2 of 7				

<div> <div>Phenolic</div> <div>Double Tier Locker</div> <div>15 x 15 x 36/72"</div> <div>L2</div> </div>	
ELEVATION	SECTION
PLEASE BE ADVISED: Lockers Are Square And Measured Based On Square Walls. If Walls Are Not Square, Adjustments To Bases Will Need To Be Made At The Expense Of The Customer To Make Allowances For The Locker Sizes As Specified In The Shop Drawings.	
Tolerances in Manufacturing Understood: Fractions $\pm \frac{1}{16}$ , Decimals $\pm .02$ , Degrees $\pm 20^\circ$	
NOTICE: All Rights Reserved, ©2025. These Drawings Of Products Described Are Subject To All Patents And Copyrights Held By Lockers Manufacturing.	
PLEASE BE ADVISED: Shop Drawings Are To Ensure We Understand Your Request. Your Approval Of These Shop Drawings Overrides Any Other Specifications Or Documentation. Please Check And Approve As We Are Going To Manufacture Material As Shown On These Drawings.	

PRODUCT FEATURES	
Security Box :	None Provided
Foot Locker:	None Provided
Handle :	Continuous Latch W/ Finger Lift
Hinge :	Continuous Plastic Hinge, Full Length Of Door And Body
Bottom :	Solid Plastic Components, 3/8" Thick
PRODUCT INFORMATION	
Material :	Phenolic
Construction :	1/2" Thick Solid Plastic
Door :	Solid Plastic Components, 1/2" Thick
Door Ventilation :	Solid Plastic
Door Latching :	Spring-Loaded Positive Latch
Top :	Solid Plastic Components, 3/8" Thick
Side :	Solid Plastic Components, 3/8" Thick
Back :	Solid Plastic Components, 3/8" Thick
Interior Equipment :	(2) SGL Prong Wall Hooks, (1) Coat Rod Per Opening
Number Plate :	Polished Aluminum Plate, Riveted
Assembly :	Secured By Plastic Welds
ACCESSORY INFORMATION	
Slope Hood :	Slope Hoods
Lock :	None Provided
Legs :	None Provided
Base :	3" Continuous Base
Recess Trim :	None Provided
Comments:	
Color : Please Advise Within Reasonable Variation	

Phenolic Openfront Series  
W/ Security Box & Foot Locker  
24 x 24 x 72"


# SAMPLE PHENOLIC CUTSHEET

PLEASE BE ADVISED: Lockers Are Square And Measured Based On Square Walls. If Walls Are Not Square, Adjustments To Bases Will Need To Be Made At The Expense Of The Customer To Make Allowances For The Locker Sizes As Specified In The Shop Drawings.

NOTICE: All Rights Reserved, © 2024. These Drawings Of Products Described Are Subject To All Patents And Copyrights Held By Lockers Manufacturing.

PRODUCT FEATURES	
Handle :	Built-In Combination Lock
Hinge :	Continuous Plastic Hinge, Full Length Of Door And Body
Bottom :	HDPE Solid Plastic, 3/8" Thick
PRODUCT INFORMATION	
Material :	HDPE
Finish :	Slightly Textured To Reduce Marring
Construction :	Sides & Backs – Plastic One-Piece Unit & Door Frame – Plastic Welded
Door :	HDPE Solid Plastic, 1/2" Thick
Door Stiffener/Reinforcement :	None
Door Frame :	HDPE Solid Plastic, 1/2" Thick
Door Ventilation :	Concealed/Perimeter Ventilation
Door Latching :	Spring-Loaded Positive Latch
Top :	HDPE Solid Plastic, 3/8" Thick
Side :	HDPE Solid Plastic, 3/8" Thick
Back :	HDPE Solid Plastic, 3/8" Thick
Shelf :	None
Interior Equipment :	(1) SGL Prong Wall Hook Per Opening
Number Plate :	Polished Aluminum Plate
Assembly :	Secured By Plastic Welds
ACCESSORY INFORMATION	
Slope Hood :	Slope Hoods
Lock :	#1630 Built-In Combination
Legs :	No
Base :	16" High x 32" Deep Concrete Base By Other
Recess Trim :	No
Comments:	
Color : Please Advise Within Reasonable Variation	
<div>SAMPLE</div>	
JOB INFORMATION	
Locker Area :	Locker Room 0105
Frame/Openings :	16/48
Product Line :	HDPE 3-Tier Locker
Size :	18x16x24/72"
Original : 03/18/2025	<div> <div>LOCKERS</div> <div>MANUFACTURING any design. any material. any technology.</div> </div>
Revised :	
Drawn By : LMK	
Reviewed By : DS	
Page : 2 of 5	<div> <div>Location :</div> <div>PO# : LOI</div> <div>File: ORD0013211.dwg</div> </div>

# HDPE 3-Tier Locker 18 x 16 x 24/72"

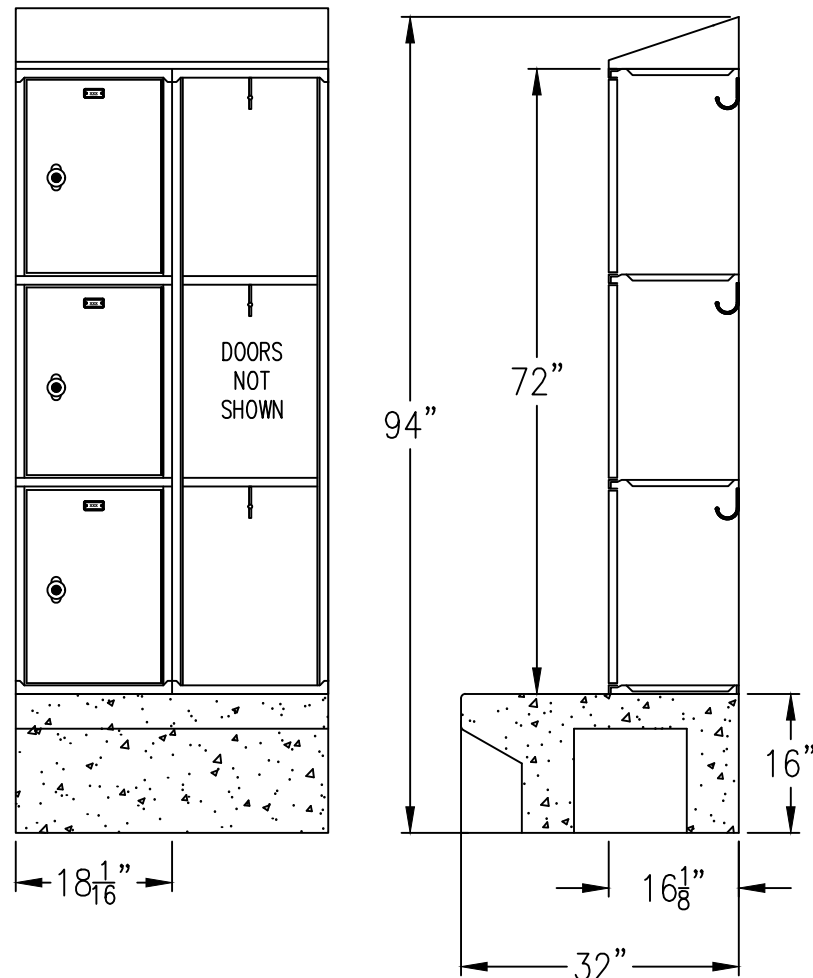

PLEASE BE ADVISED: Lockers Are Square And Measured Based On Square Walls. If Walls Are Not Square, Adjustments To Bases Will Need To Be Made At The Expense Of The Customer To Make Allowances For The Locker Sizes As Specified In The Shop Drawings.

Tolerances in Manufacturing Understood: Fractions  $\pm \frac{1}{16}$ , Decimals  $\pm .02$ , Degrees  $\pm 20^\circ$

NOTICE: All Rights Reserved, © 2025. These Drawings Of Products Described Are Subject To All Patents And Copyrights Held By Lockers Manufacturing.


PLEASE BE ADVISED:  
Shop Drawings Are To Ensure We Understand Your Request. Your Approval Of These Shop Drawings Overrides Any Other Specifications Or Documentation. Please Check And Approve As We Are Going To Manufacture Material As Shown On These Drawings.

PRODUCT FEATURES	
Handle :	Continuous Latch W/ Finger Lift
Hinge :	Extruded Aluminum
Bottom :	Solid Plastic Components, 3/8" Thick
PRODUCT INFORMATION	
Material :	Solid Plastic
Finish :	Slightly Textured To Reduce Marring
Construction :	Sides & Backs – Plastic One-Piece Unit & Door Frame – Plastic Welded
Door :	Solid Plastic Components, 1/2" Thick
Door Stiffener/Reinforcement :	None
Door Frame :	Solid Plastic Components, 1/2" Thick
Door Ventilation :	Solid Plastic Components, 1/2" Thick
Door Latching :	Spring-Loaded Positive Latch
Top :	Solid Plastic Components, 3/8" Thick
Side :	Solid Plastic Components, 3/8" Thick
Back :	Solid Plastic Components, 3/8" Thick
Shelf :	None
Interior Equipment :	(2) SGL Prong Wall Hooks And (1) Coat Rod Per Opening
Number Plate :	Polished Aluminum Plate
Assembly :	Solid Plastic Compents That Slide Together
ACCESSORY INFORMATION	
Slope Hood :	3/8" HDPE Continuous Slope Hood
Lock :	No
Legs :	No
Base :	4" High Concrete Base By Other
Recess Trim :	No
Comments:	
Color : Please Advise Within Reasonable Variation	
<div>SAMPLE</div>	

JOB INFORMATION	
Locker Area :	SP/Search E1200
Frame/Openings :	7/14
Product Line :	HDPE "Z" Style Locker
Size :	18x12x72"
Original : 11/20/2024	<div> <div> <div>Dealer :</div> <div>Installer :</div> <div>Contractor :</div> <div>Job ID :</div> </div> <div> <div>LOCKERS</div> <div>MANUFACTURING</div> <div>any design. any material. any technology.</div> </div> </div>
Revised :	
Drawn By : LMK	
Reviewed By : DS	
Page : 1 of 2	<div>Location :</div> <div>PO# : LOI</div> <div>File: ORD009150.dwg</div>

<div> <div>HDPE Series</div> <div>"Z" Locker</div> <div>18 x 12 x 72"</div> </div> <div> <div> <div> <div> <div>48"</div> <div>18<sup>1</sup>/<sub>16</sub>"</div> </div> <div> <div>ELEVATION</div> </div> </div> <div> <div> <div> <div>81"</div> <div>72"</div> </div> <div> <div>SECTION</div> </div> </div> </div> </div></div>	
<div> <div>PLEASE BE ADVISED: Lockers Are Square And Measured Based On Square Walls. If Walls Are Not Square, Adjustments To Bases Will Need To Be Made At The Expense Of The Customer To Make Allowances For The Locker Sizes As Specified In The Shop Drawings.</div> <div> <div>Tolerances in Manufacturing Understood: Fractions <math>\pm \frac{1}{16}</math>, Decimals <math>\pm .02</math>, Degrees <math>\pm 20^{\circ}</math></div> <div> <div>NOTICE: All Rights Reserved, © 2024. These Drawings Of Products Described Are Subject To All Patents And Copyrights Held By Lockers Manufacturing.</div> <div> <div>PLEASE BE ADVISED:</div> <div>Shop Drawings Are To Ensure We Understand Your Request. Your Approval Of These Shop Drawings Overrides Any Other Specifications Or Documentation. Please Check And Approve As We Are Going To Manufacture Material As Shown On These Drawings.</div> </div> </div> </div> </div>	

PRODUCT FEATURES	
Security Box :	Solid Plastic With Lockable Door
Foot Locker:	Solid Plastic With Continuous Latch
Bottom :	HDPE Solid Plastic, 3/8" Thick
PRODUCT INFORMATION	
Material :	HDPE
Construction :	1/2" Thick HDPE Solid Plastic
Finish :	Smooth Orange Peel
Door Ventilation :	Open Front
Top :	HDPE Solid Plastic, 3/8" Thick
Side :	HDPE Solid Plastic, 1/2" Thick
Back :	HDPE Solid Plastic, 3/8" Thick
Shelf :	HDPE Solid Plastic, 3/8" Thick
Interior Equipment :	(4) SGL Prong Wall Hooks Per Opening
Number Plate :	Polished Aluminum Plate, Riveted
Assembly :	Secured By Plastic Welds
ACCESSORY INFORMATION	
Slope Hood :	Slope Hoods
Lock :	None Provided
Legs :	None Provided
Base :	4" High Black Plastic Base
Recess Trim :	None Provided
Comments:	
Color : Please Advise Within Reasonable Variation	
<div style="text-align: center; color: red; font-size: 48px; font-weight: bold;">SAMPLE</div>	

JOB INFORMATION		
Locker Area :	Locker Rooms	
Frame/Opening :	10/10	
Product Line :	Heavy Duty SGL Tier Locker	
Size :	12x12x72"	
Original : 01/16/2025	Dealer :	 <b>LOCKERS</b> <sup>TM</sup> MANUFACTURING any design. any material. any technology.
Revised :	Installer :	
Drawn By : LMK	Contractor :	
Reviewed By : BR	Job ID :	
	Location :	
Page : 3 of 4	PO# : LOI	File: ORD0013128.dwg

HDPE Openfront Series  
W/ Security Box & Foot Locker  
18 x 24 x 72"

PLEASE BE ADVISED: Lockers Are Square And Measured Based On Square Walls. If Walls Are Not Square, Adjustments To Bases Will Need To Be Made At The Expense Of The Customer To Make Allowances For The Locker Sizes As Specified In The Shop Drawings.





**Two-Tone:** Two tone finish is available upon request with an additional fee.

**Standard Finish:** Provides a durable, uniform finish, offering excellent resistance to corrosion, chemicals, and abrasion. Industry leading 2-3 mils standard. Available for all color options

**Custom Colors:** Custom colors empower a customer to find the exact color that fits their projects needs. This is ideal for matching new lockers to existing lockers, or finding the perfect color to bring a space together.

**Hammertone Finish:** A textured finish that offers a unique look while adding enhanced durability. Industry leading 2-3 mils standard. Hammertone color chart available upon request.

**Antimicrobial Finish:** Our antimicrobial powder coating inhibits the growth of bacteria, mold, and other microbes. Industry leading 2-3 mils standard. Available for all color options.

**Anti-Graffiti Finish:** Provides a protective layer that allows for easy removal of graffiti and stains, preserving the finish of the product. Industry leading 2-3 mils standard. Available for all color options.

Colors shown are an approximate printed representation of the actual colors and may vary. Actual color samples are available upon request.

Lockers Manufacturing retains the right of reasonable color variation from samples presented.


**CONTACT US**




**662-338-4340**



**WWW.LOCKERSMFG.COM**

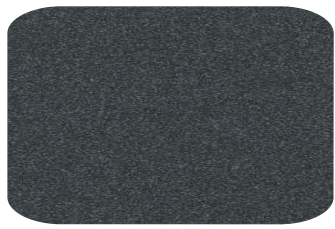


4623 Midnight Cosmos

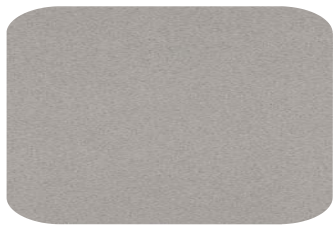

SL4142 Frosted Slate




SL7022 Nature's Textile

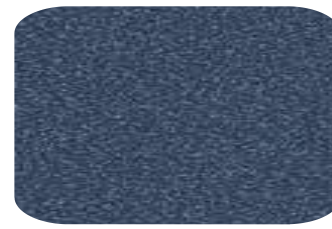

SL7018 Midnight Blueprint



SL3687 Maple Slate

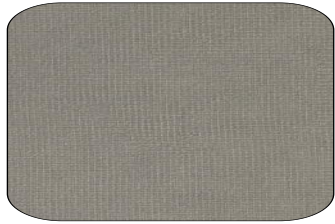


SL4878 Silver Grid




SL7921 Walnut Wonder



SL4674 Shadowed Savannah

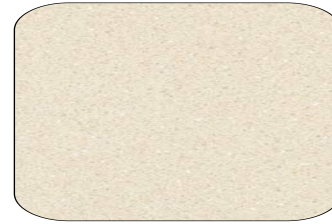

SLD97 Vapor Veil

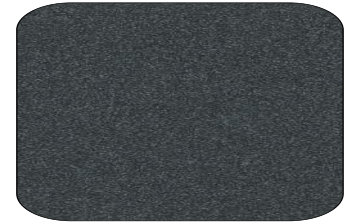


SL4623 Carbon Galaxy




SL1595 Black



SL1573 Frosty White

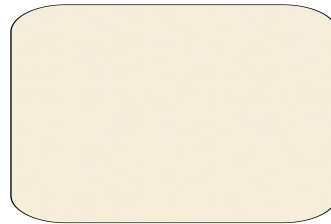

SLD30 Natural Almond

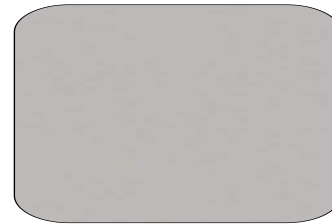

D381 Fashion Grey



SL837 Graphite

Colors representation may vary from final product. Please view material samples prior to selection. Multi-color projects require minimum quantities.

# Phenolic - Quick Ship Color Chart

**LOCKERS™**  
MANUFACTURING any design. any material. any technology.

P.O. Box 208  
Como, MS 38619  
662-338-4340  
[www.lockersmfg.com](http://www.lockersmfg.com)

## MULTI-POINT RECESSED HANDLE



This stainless steel handle is designed for safety, eliminating protrusion from the front of the locker. Can be used with a built-in combination lock or portable padlock. We provide several innovative features to provide “Quiet Locker” features on our multi-point latch:

- Rubber bumpers on doors frames
- Virgin nylon glides over latches.
- Plastic “spider” in latch channel.

Latch channel attached with plastic buttons, not metal flanges.

Additionally, the multi-point latch channel is powder coated before assembly, therefore preventing corrosion and latch channel sticking.



## SINGLE-POINT RECESSED HANDLE

This stainless steel handle has no moving parts, which requires low maintenance — equipped with Anti Pry Latch for added security. This 20 gauge stamped cup can be supplied with a built-in lock or a padlock for security.

## DOOR PULL




The door pull featuring a padlock hasp stands as the handle choice for all box lockers, offering both functionality and security. This standard option provides users with a reliable and familiar method for securing their belongings, ensuring peace of mind and ease of access.




## CREMONE TURN HANDLE


Discover enhanced durability with our unbreakable steel handle, securely bolted to a sturdy three-point latching system. The 3/8” latching rod engages effortlessly at the top and bottom of the door frame, while the 1/8” thick center latch ensures a reliable lock at the door’s center to the frame.

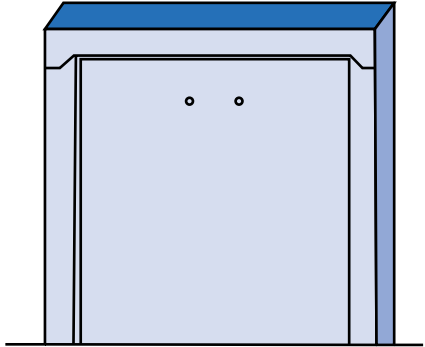


**SOLID LOUVERS**

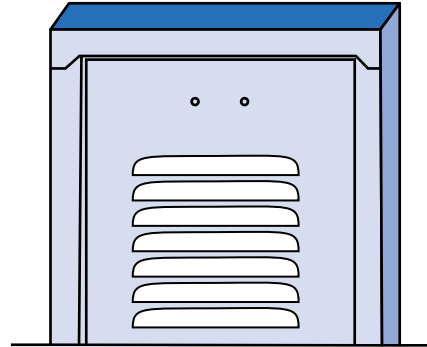


**FULL LOUVERS**

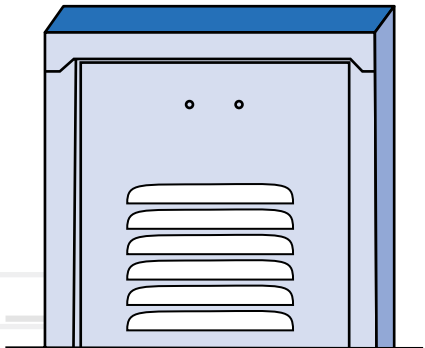


**STANDARD LOUVERS**

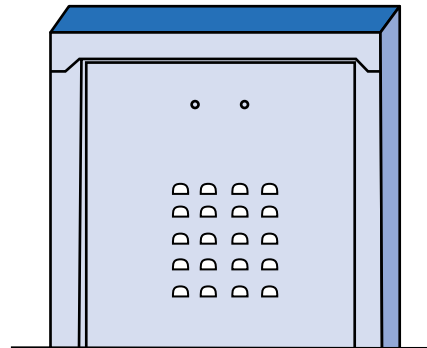

**MINI LOUVERS**

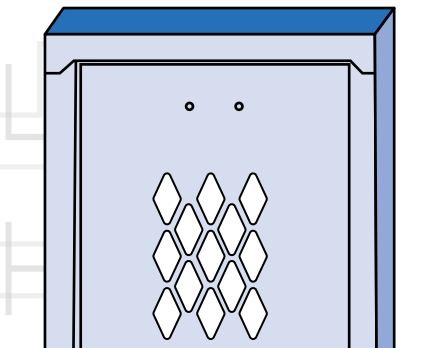


**DIAMOND PERFORATIONS**

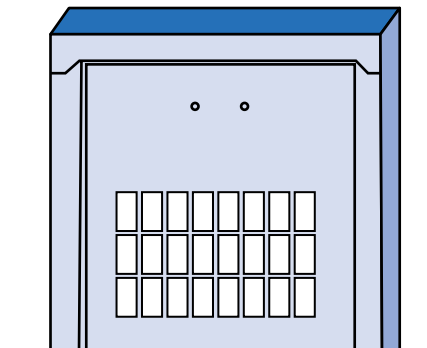

**RECTANGULAR PERFORATIONS**

Slope tops are frequently preferred over flat tops to prevent the buildup of dust and debris and deter using locker tops for storage. Three variations of slope construction are available: Unit slope tops, Slope hoods and Slope top kits (Stock converter for Knock Down Series).

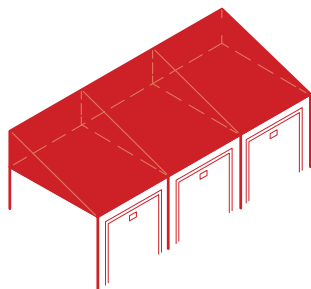

## UNIT SLOPE TOPS


Unit Slope Tops cover the width of one locker frame only. Lockers with Unit Slope Tops have sides with mitered top ends with a rise equal to 1/3 of the locker depth, plus longer backs that meet the rear edge of the slope top, Unit Slope Tops are used in place of the standard flat tops. (Not for use on Heavy Duty Series, Open Front Series or All Welded Series.)

Unit Slope Tops are available in the following width and depth:

9x12, 9x15, 9x18, 12x12, 12x15, 12x18, 12x21, 15x12, 15x15, 15x18, 15x21, 18x18, 18x21, 18x24, 24x18, 24x21 and 24x24.

Slope Top Kits are available in the following width, depth and height:

12x12x4, 12x15x4, 12x18x6, 15x15x5, 15x18x6 and 18x18x6.

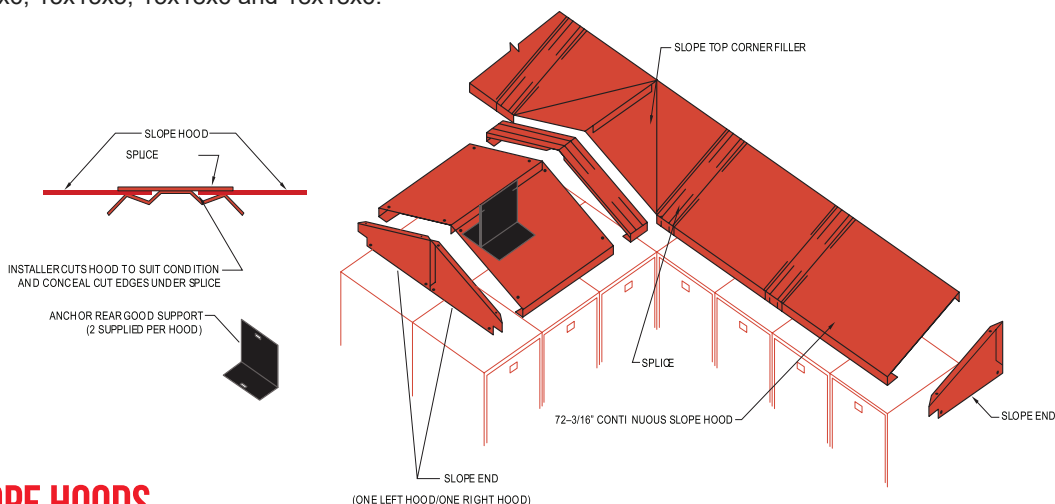

## CONTINUOUS SLOPE HOODS


Continuous Slope Hoods fit on top of flat top lockers. They can be used on new lockers, or on a retrofit basis. All hoods are furnished in 72" lengths and must be cut to length during installation. Intermediate splices, ends and rear supports (2 per hood) complete the installation, and must be ordered separately.

Slope Hoods are available in the following width, depths and heights: 72x12x5, 72x15x6, 72x18x7, 72x21x8, and 72x24x9.


Slope Ends and Hood Splice available in the following depths and heights: 12x5, 15x6, 18x7, 21x8 and 24x9.

Recess Trim is 3" wide and bridges the gap between lockers and the wall and/or soffits when the lockers are recessed into a wall. Lockers must be anchored to base (base and wood to be completed by a general contractor.)


## SIDE VIEW OF BASE & ANCHORS

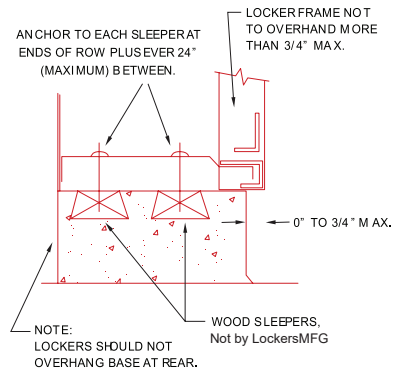


## SIDE VIEW OF TOP RECESSED TRIM

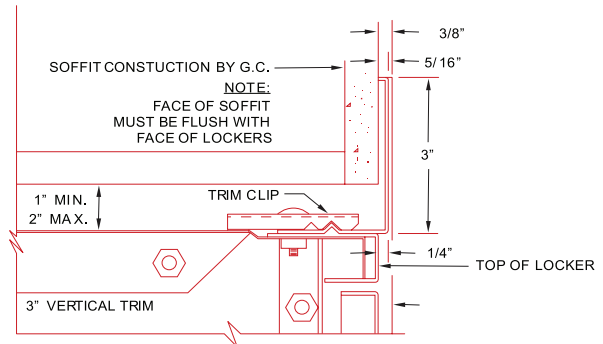


## TOP VIEW OF A RECESSED LOCKER GROUPING

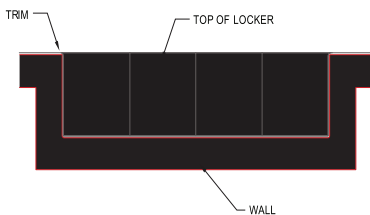

## TOP VIEW OF 3" VERTICAL TRIM R.H.

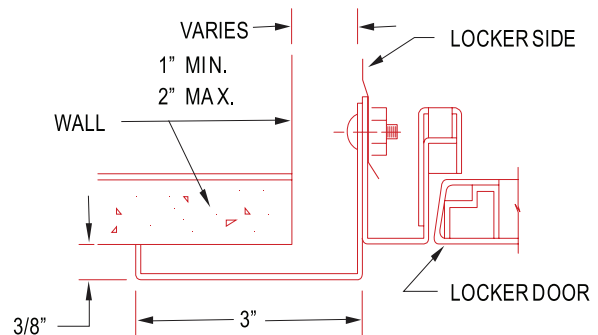


## FRONT VIEW OF LOCKER WITH RECESSED TRIM

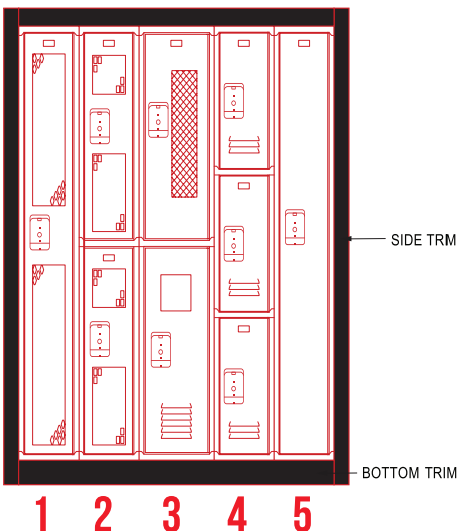

1. COMPETITIVE 1 - TIER WITH DIAMOND PERFORATIONS
2. DURABLE 2 - TIER WITH VISUAL PERFORATIONS
3. FIRE EXTINGUISHER / WASTE BIN
4. DURABLE 3 - TIER WITH LOUVERS
5. DURABLE PLUS 1 - TIER WITH SOLID DOORS

Introducing our locker bases, available in two versatile options: individual closed bases and zee bases. Our individual closed bases offer sturdy support for each locker unit, ensuring stability and durability. Alternatively, our zee bases provide a sleek and modern aesthetic while maximizing airflow and ease of cleaning. Whether you prefer individual closed bases for a traditional look or zee bases for contemporary appeal, our bases are designed to complement any locker setup.

## INDIVIDUAL CLOSED BASES

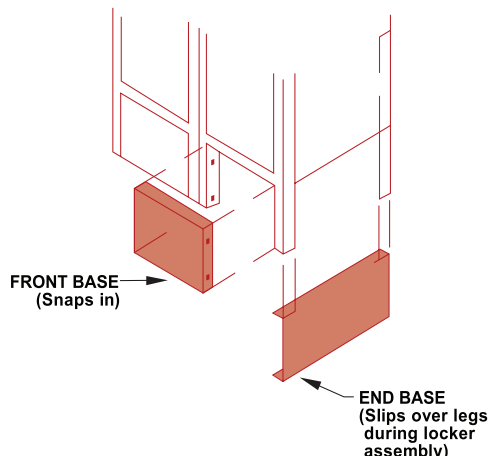

Front and End bases are designed to fit between standard Lockers Manufacturing 6" legs. They present a clean flush appearance and prevent the accumulation of dust and dirt under the lockers. (Not for use on All Welded lockers). Front base snaps in. End base slips over legs during locker assembly.

Closed bases are available in the following widths and heights: 9x6, 12x6, 15x6, 18x6 and 24x6

End bases single row are available in the following depths and heights: 12x6, 15x6, 18x6, 21x6 and 24x6

End bases double row are available in the following depths and heights: 24x6, 30x6 and 36x6

## ZEE BASES

Zee bases raise lockers without 4" legs off the floor when there is no concrete or wood base. They provide a toe space in the front and a concealed flange for floor anchoring at the rear. A special 4" high rear leg can be ordered to simplify installation. Also available for 6" high zee bases.


Zee bases are available only in 72" lengths, and may need to be cut to fit at the time of installation. Splices/End Bases are used at end of rows, and where the front sections join. (Not for use on All Welded lockers).

Front zee base is available in 72 x 4.

Splice/End Base Single Row is available in the following depths and heights: 2x4, 25x4, 18x4, 21x4 and 24x4


Splice/End Base Double Row is available in the following depths and heights: 30x4, 24x4 and 36x4

Zee Base Filler is available in a 4" height.  
Rear leg for Zee Base is available in a 4" height.

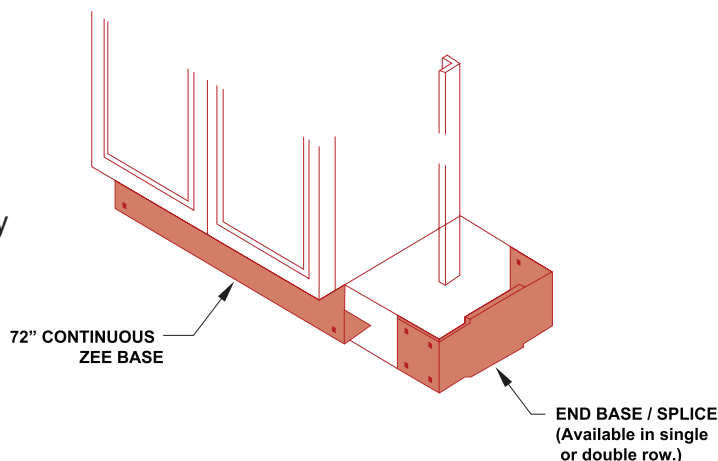



Lockers Manufacturing provides standard fillers to adapt lockers to a wide range of field conditions and provide a professional, finish appearance. Fillers can be used to cover columns, pipes or other obstacles in a row of lockers, or fill the gap between the lockers and a wall.

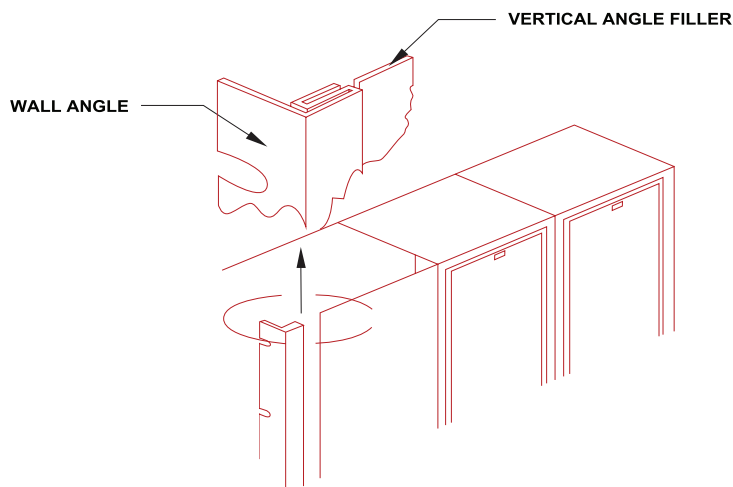

## VERTICAL FILLERS

These come in two widths and are designed to be used in conjunction with Wall Angle Slip Joints for a solid fit and smooth finish. The slip joint conceals any raw edges caused by field cutting.

## TOP FILLERS

Top filler cover gaps between tops of lockers. They overlap the locker tops and can be field cut to allow for pipes, etc. There are separate designs for flat top vs. slope top, and in-line vs. corner applications.

Vertical Angle Fillers are available in the following widths and heights: 5x60, 5x72, 9x60, 9x72, 9x78, 12x60, 12x72 and 12x78.


Wall Angle Slip Joints are available in the following heights: 60, 72 and 78.

Flat Top Fillers are available in the following widths and depths: 15x12, 15x15 and 15x18.


Slope Top Fillers are available in the following widths and depths: 15x12, 15x15 and 15x18

Flat Top Corner Fillers are available in the following widths and depths: 12x12, 15x15 and 18x18


Slope Top Corner Fillers are available in the following widths and depths: 15x12, 15x15 and 15x18

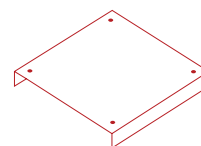


FLAT TOP FILLER

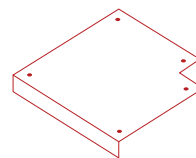

FLAT TOP CORNER FILLER

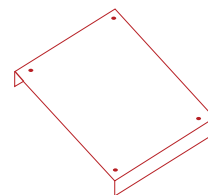

SLOPE TOP FILLER

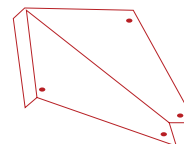

SLOPE TOP CORNER FILLER




Explore our cushion options designed to provide comfort and support. Choose the single bottom cushion for a sleek and minimalist design, ideal for short periods of sitting. Opt for the bottom and back cushion for added lumbar support, perfect for longer durations. Available in multiple colors, our cushions enhance the usability and comfort of your locker spaces.

## BOX STYLE CONSTRUCTION (BOTTOM ONLY)




- Same height boxing around cushion
- 1" to 3" foam
- 1/2" or 3/4" plywood
- Velcro fasteners attached
- Monogram option available
- T-Nuts can be installed with customer provided CAD drawing
- 100% customizable to fit your specifications
- Multiple color options available (*can match almost any PanTone Color; contact a sales rep for more info*)

## BOX STYLE CONSTRUCTION (BACK & BOTTOM)

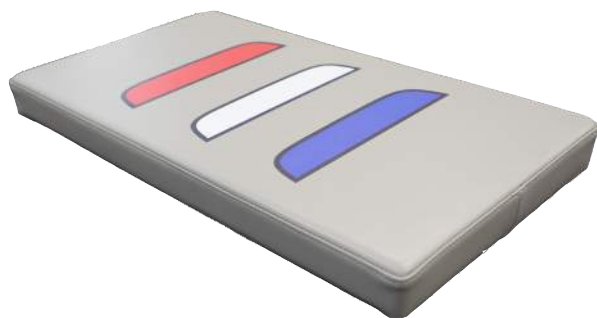

Elevating both comfort and organization, our locker benches seamlessly integrate into any floor plan. These benches provide the perfect blend of durability and aesthetic appeal. With painted or stainless steel pedestals for sturdy support, they are an essential addition to any locker room.

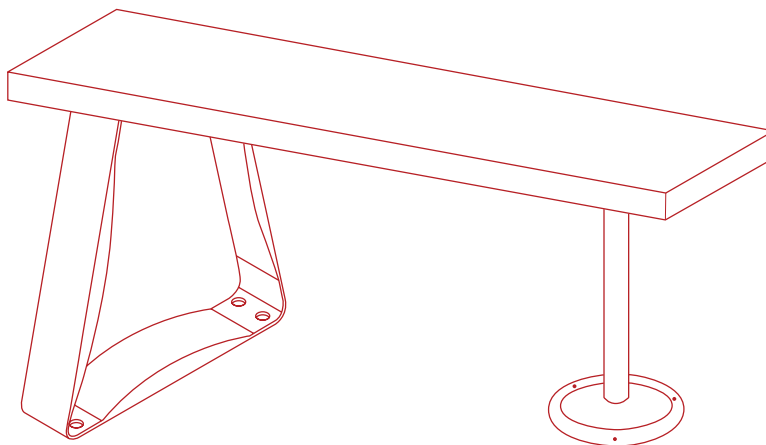

## STAINLESS STEEL

Our stainless steel bench tops measure 9-1/2" deep x 1-1/4" thick, while ADA-compliant options are available in depths of 12" or 24". Pedestals can be ordered separately for your convenience.

## WOOD TOPS

Our solid butcher block bench tops are made of edge-grain maple, are coated with DURAKRYL 102®, a robust urethane-based finish resistant to sweat and stains. Standard bench tops measure 9-1/2" deep x 1-1/4" thick, while ADA-compliant options are available in depths of 12" or 24". Pedestals can be ordered separately for your convenience.

## HDPE TOPS

Our HDPE bench tops measure 9-1/2" deep x 1-1/2" thick, while ADA-compliant options are available in depths of 12" or 24". Pedestals can be ordered separately for your convenience.

## ALUMINUM TOPS


Our aluminum bench tops measure 9-1/2" deep x 1-1/4" thick, while ADA-compliant options are available in depths of 12" or 24". Pedestals can be ordered separately for your convenience.

## ADA OPTIONS

Benches that are required to be ADA specifications are available. Contact a Lockers Manufacturing Representative for more information.


Elevating both comfort and organization, our locker pedestals seamlessly integrate into any floor plan. With high-quality painted or stainless steel options, our pedestals provide sturdy support for our premium hardwood maple benches, making them an essential addition to any locker room.

Select from two distinct pedestal styles: the robust Heavy Duty Pedestal or the sleek Stainless Steel Pedestal. For benches measuring 96" long or less, opt for two pedestals; for those exceeding 96" in

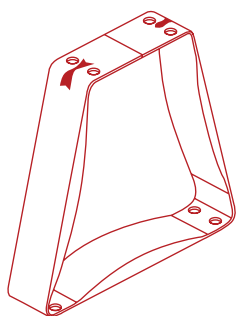


## STAINLESS STEEL PEDESTAL

Featuring a 14" wide base, this pedestal offers versatility for freestanding use. Holes at the bottom enable optional floor anchoring or the attachment of non-skid bumpers (refer to the section below for details). Hardware is included for fastening to the bench top. \*Stainless steel is typically not painted.

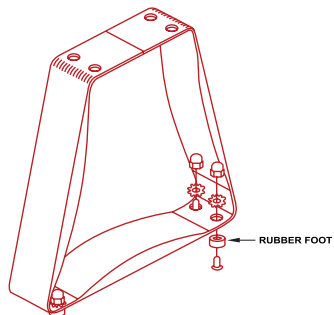

## NON-SKID PEDESTAL KIT

Protect your floors with ease using rubber non-skid bumpers, designed to prevent damage. Each kit includes four non-marking rubber feet and the necessary fastening hardware. Ensure to order one kit per pedestal, exclusively for use with Stainless Steel Pedestals.

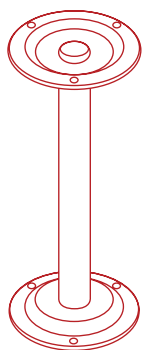

## HEAVY DUTY PEDESTAL

Standing at a height of 16-1/4", this pedestal is constructed with a durable steel tube welded to top and bottom flanges, ensuring stability and strength. Hardware for securing to the bench is provided for your convenience, and floor anchoring is necessary for stability. Multiple pedestals are recommended per bench. Choose from all 24 available colors to complement your space effortlessly.


## ADA OPTIONS

Benches that meet all ADA guidelines are AVAILABLE ADA BRACKETS DOUBLE REVERSED - contact a Lockers Manufacturing Representative for more information.

Please use this table as a guide only. Master Lock recommends trying your selected lock on your specific application prior to any purchase. Contact your lock distributor or Master Lock for assistance.

1690/1790 locks are recommended for single point latch lockers.

\*Note: Single point latch lockers transitioned from horizontal latching (1652 or 1670) to rotating latching (Wrap Around Latch™) in 2008. Lockers built before 2008 will use horizontal latch locks. Please check with the locker manufacturer to confirm latch type used for lock built in 2008 or after.

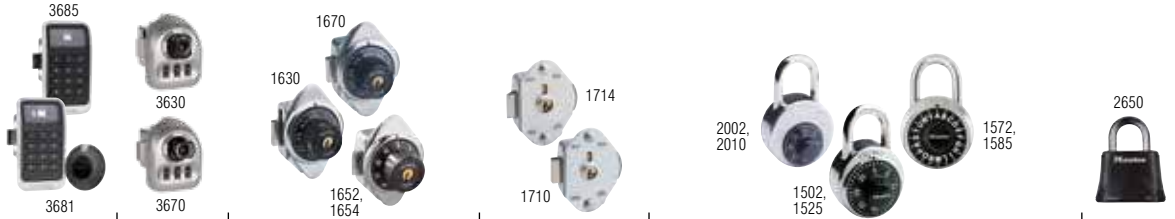

Locker Selection	Lock Selection	Electronic Built-In Locks	Multi-User Locks	Built-In Combination Locks			Built-In Keyed Locks		Combination Portable Padlocks				Keyed Portable Padlocks
	Handle/Latch Type			General Security	Higher Security	General Security	Higher Security	Key Controlled		Not Key Controlled			
								General Security	Higher Security	General Security	Higher Security		
Knock Down Series	Recessed handle, single point		3670		1652	1670	1714	1710	1525, 1585	2010, 2010S	1502, 1572	2002S	2650
Knock Down Series	Recessed handle, multi point		3670	1630, 1631 (L)		1670		1710	1525, 1585	2010, 2010S	1502, 1572	2002S	2650
Knock Down Series	Door Pull	3685	3670		1652	1670	1714	1710	1525, 1585	2010, 2010S	1502, 1572	2002S	2650
Knock Down Series	Cremona Turn Handle				1652	1670	1714	1710	1525, 1585	2010, 2010S	1502, 1572	2002S	2650
Knock Down Plus Series	Recessed handle, single point		3670		1652	1670	1714	1710	1525, 1585	2010, 2010S	1502, 1572	2002S	2650
Knock Down Plus Series	Recessed handle, multi point		3670	1630, 1631 (L)		1670		1710	1525, 1585	2010, 2010S	1502, 1572	2002S	2650
Knock Down Plus Series	Door Pull	3685	3670		1652	1670	1714	1710	1525, 1585	2010, 2010S	1502, 1572	2002S	2650
Knock Down Plus Series	Cremona Turn Handle				1652	1670	1714	1710	1525, 1585	2010, 2010S	1502, 1572	2002S	2650
Heavy Duty Series	Recessed handle, single point		3670		1652	1670	1714	1710	1525, 1585	2010, 2010S	1502, 1572	2002S	2650
Heavy Duty Series	Recessed handle, multi point		3670	1630, 1631 (L)		1670		1710	1525, 1585	2010, 2010S	1502, 1572	2002S	2650
Heavy Duty Series	Door Pull	3685	3670		1652	1670	1714	1710	1525, 1585	2010, 2010S	1502, 1572	2002S	2650
Heavy Duty Series	Cremona Turn Handle				1652	1670	1714	1710	1525, 1585	2010, 2010S	1502, 1572	2002S	2650
All Welded Series	Recessed handle, single point		3670		1652	1670	1714	1710	1525, 1585	2010, 2010S	1502, 1572	2002S	2650
All Welded Series	Recessed handle, multi point		3670	1630, 1631 (L)		1670		1710	1525, 1585	2010, 2010S	1502, 1572	2002S	2650
All Welded Series	Door Pull	3685	3670		1652	1670	1714	1710	1525, 1585	2010, 2010S	1502, 1572	2002S	2650
All Welded Series	Cremona Turn Handle				1652	1670	1714	1710	1525, 1585	2010, 2010S	1502, 1572	2002S	2650
KD Open Front Series	Door Pull		3670		1652	1670	1714	1710	1525, 1585	2010, 2010S	1502, 1572	2002S	2650
All Welded Openfront Series	Door Pull		3670		1652	1670	1714	1710	1525, 1585	2010, 2010S	1502, 1572	2002S	2650
Athletic Footlocker Compartment	Padlock Loop		3670					1710	1525, 1585	2010, 2010S	1502, 1572	2002S	2650

Note: Models 1790, 1714 and 1710 are available with optional master keying. Add MK to product number when ordering. (ie: 1790 + Master Key = 1790MK)

- 1 Select Locker 2 Select Handle/Latch Style 3 Select Lock Style 4 Select Security Level 5 For Built-Ins- Select Left or Right Hand Opening Door 6 Select ADA Lock Options
- S = short shackle, 1/2" decrease  
All options are right handed unless (L) designated for left-handed lockers  
Recommended for lockers with pockets

www.masterlock.com

Master Lock Company LLC, Milwaukee, WI 53154 U.S.A. | 800-308-9244  
Master Lock Canada, Mississauga, Ontario L5L 5Z9 | 800-227-9599  
© 2018 Master Lock Company | All Rights Reserved

LM - LLCP MO PDF 11/18



## ADA Compliant Lock Options

Designed to meet 28CFR Part 36 Federal Standards

3681, 1630 = 1636MKADA, 1670 = 1676MKADA, 1690 = 1695MKADA,  
1790 = 1790MKADA, 1710 = 1710MKADA, 1714 = 1714MKADA



## Easy to Use Lock Options

1525 = 1525EZRC, 2650





P.O. Box 208  
Como, MS 38619  
Phone: (662)-338-4340  
Email: sales@lockersmfg.com

## Lifetime Warranty

Date:  
To:  
Re:

The Lockers provided by Lockers Manufacturing for this project have an original purchaser Lifetime Warranty against defects in material and workmanship. This warranty is in effect from the date of substantial completion and excludes locks, or any other product not manufactured by LockersMFG.

Rapid deterioration of the finish will be covered. The warranty will NOT cover the following:

- Finished surfaces exposed to high humidity, chlorine salts, abrasives, acids, or other harmful chemicals.
- Improper use or abuse. Improper use or abuse includes, but is not limited to, damage from mishandling of the product, damage from excessive heat or uneven exposure to weather conditions, physical or chemical abuse and damage from improper care and maintenance.
- Modifications or attachments to the product that are not approved by LockersMFG.
- Products that were not installed, used or maintained in accordance with product instructions and warnings.
- Impact of foreign objects, fire, earthquake, flood, hurricane, tornado or any other casualty.

Any replacement or repair of material under this warranty shall be performed only after written authorization by LockersMFG and will constitute the buyers sole and exclusive remedy. In no event should LockersMFG be held responsible for any special, direct, indirect, incidental or consequential damages.



## Maintenance and Care

### 1. Routine Cleaning

- The high-quality powder coat finish of LockersMFG metal lockers is very durable and resistant to most chemicals and cleaners. However, care should be taken to avoid damaging the finish.
  - Acceptable cleaners:
    - Household cleaners such as Lysol, Mr. Clean, Pine Sol.
    - Mild soap and detergents such as Dawn, Palmolive, Gain, Tide
    - Mild solvents such as mineral spirits (no acetone or harsh solvents)
    - Household solvent-based cleaners such as Goof Off or Goo Gone
  - Un-acceptable cleaners:
    - Acidic cleaners such as Lime Away, any acid compound
    - Any cleaner containing hydrogen peroxide.
    - Alkaline cleaners such as toilet bowl cleaners.
    - Strong solvents such as acetone, MEK, xylene, etc.
    - Abrasive cleaners include SOS, Comet, Soft Scrub, and any polishing compound.
- After using a cleaning compound, rinse with water and dry with a soft towel or microfiber towel.
- Touch up any scratches immediately to prevent corrosion. Factory-matched touch-up paints are available from LockersMFG. Contact LockersMFG at 662-338-4340 or [info@lockersmfg.com](mailto:info@lockersmfg.com) to get information on matching touch-up paints.

### 2. Annual Maintenance

- Inspect each door for ease of opening and closing
- Note any loose or missing hardware (nuts & bolts, rivets) or accessories (hooks, shelves)
- Ensure latch hooks are centered in latch opening in door and not rubbing. Use pliers to bend into correct position.
- Lubricate latch hooks on door frame.
- Lubricate the latching bar (if applicable) in the door.
- Clean interior and exterior of locker with non-ammonia containing mild cleanser.
- Use a product such as "Goof-Off" or WD-40 to remove any ink or other stains from finish.

### 3. Replacement Parts

- If damage or missing parts are noted and replacements needed, contact LockersMFG at 662-338-4340 or email [info@lockersmfg.com](mailto:info@lockersmfg.com).



PO Box 208 Como, MS 38619

## Build America, Buy America Act Certificate

- (a) LockersMFG certifies that each “end product”, except those listed in paragraph (b) of this provision, is a domestic “end product” and that for other than COTS items, and has considered components of unknown origin to have been mined, produced, or manufactured outside the United States. LockersMFG lockers are produced domestically and shall list as foreign “end products” those “end products” manufactured in the United States that do not qualify as domestic “end products”, i.e., an end product that is not a COTS item and does not meet the component test in paragraph (2) of the definition of “domestic end product.” The terms “commercially available off-the-shelf (COTS) item,” “component,” “domestic end product,” “end product,” “foreign end product,” and “United States” are defined in the clause of this solicitation entitled “Buy American Act—Supplies.”

A manufactured product qualifies as a domestic end product if it is manufactured in the US; and the cost of its components mined, produced, or manufactured in the US exceeds 65% of the cost of all of its components (48 C.F.R. § 25.101(a) as amended per Fed.Reg.)

Due to the shortage or non-existent domestic supply, some or all of the following materials may be sourced from international markets when not practicably available domestically.

- (b) Foreign End Products:

Line Item	Country of Origin
Combination Locks	Varies
Channel Glides	Varies
Hooks	Varies
Pedestals	Varies

LockersMFG complies with the updated provisions of the Public Law 117-58 (as enacted March 9, 2024) applying graduating levels for the Buy American Act 41 U.S.C.A. 10 (2009) et. seq. and appreciates your interest in our products.

Sincerely, Lockers Manufacturing, LLC

As a bidder or offeror, we hereby certify that we will comply with the requirements of 49 U.S.C. 5323(j)(1), and the applicable regulations in 49 CFR part 661.

Date: \_\_\_\_\_  
Signature: \_\_\_\_\_  
Company: \_\_\_\_\_  
Name: \_\_\_\_\_  
Title: \_\_\_\_\_



Year 2024

Re: ASTM Compliance

This letter serves to certify that Lockers Manufacturing has complies with the ASTM standards for the fabricated cold rolled metal used in its all-welded locker fabrication. Below are the ASTM standards we comply with:

ASTM INTERNATIONAL (ASTM)

- **ASTM A1008/A1008M** Standard Specification for Steel, Sheet, Cold-Rolled, Carbon, Structural, High-Strength Low-Alloy and High-Strength Low-Alloy with Improved Formability, Solution Hardened, and Bake Hardened
- **ASTM A568/A568M** Standard Specifications for Steel, Sheet, Carbon, Structural, and High-Strength, Low-Alloy, Hot-Rolled and Cold-Rolled.
- **ASTM A653/A653M** Standard Specification for Steel Sheet, Zinc-Coated (Galvanized) or Zinc-Iron Alloy-Coated (Gal annealed) by the Hot-Dip Process.
- **ASTM A924/A924M** Standard Specification for General Requirements for Steel Sheet, Metallic-Coated by the Hot-Dip Process.
- **ASTM B456** Standard Specification for Electrodeposited Coatings of Copper Plus Nickel Plus Chromium and Nickel Plus Chromium.
- **ASTM D6386** Standard Practice for Preparation of Zinc (Hot-Dip Galvanized) Coated Iron and Steel Product and Hardware Surfaces for Painting.

Should you need additional documentation or information please contact me at any time.

Sincerely,

Keith Dunham  
President



## QUALITY MANAGEMENT SYSTEM CERTIFICATE

This certifies that the quality system of

# Lockers Manufacturing

209 Pearson Street, Batesville, MS 38606, USA

is registered by IAPMO SCB in recognition of a  
Quality Management System, which fulfills the requirements of

### ISO 9001:2015

Scope of Registration

Design and manufacturer of storage lockers

Certificate No: 1118025

Certificate Decision/Re-Issue Date:	02/02/2024
Certificate Issue Date:	02/02/2024
Certificate Expiry:	02/01/2027
Site Structure:	Single Site



**SHIRLEY DEWI**, SR. VICE PRESIDENT OF  
MANAGEMENT SYSTEM REGISTRATION SERVICES

909.230.5526 | [WWW.IAPMOSCB.ORG](http://WWW.IAPMOSCB.ORG)  
5001 E. PHILADELPHIA ST, ONTARIO, CA 91761-2816



# CERTIFICATE OF COMPLIANCE



## Lockers Manufacturing All Welded

142840-420

Certificate Number

11 Oct 2019 - 10 Oct 2025

Certificate Period

Certified

Status

UL 2818 - 2022 Gold Standard for Chemical Emissions for Building Materials, Finishes and Furnishings

Classroom furniture and furnishings are modeled to the classroom environment with a room volume of 231 m<sup>3</sup> and 0.82 air changes per hour (ACH) accommodating 27 students.

Product tested in accordance with UL 2821 test method to show compliance to emission limits on UL 2818. Section 7.1 and 7.2.



UL investigated representative samples of the identified Product(s) to the identified Standard(s) or other requirements in accordance with the agreements and any applicable program service terms in place between UL and the Certificate Holder (collectively "Agreement"). The Certificate Holder is authorized to use the UL Mark for the identified Product(s) manufactured at the production site(s) covered by the UL Test Report, in accordance with the terms of the Agreement. This Certificate is valid for the identified dates unless there is non-compliance with the Agreement.



## GREENGUARD Gold Certification Criteria for Individual Office Furniture Products

Criteria	CAS Number	Maximum Allowable Emission Factor		Units
		Open Plan	Private Office	
TVOC <sup>(A)</sup>	-	152	306	µg/m²*hr
Formaldehyde	50-00-0	6.2	12.5	µg/m²*hr
Total Aldehydes <sup>(B)</sup>	-	1.2	2.4	µmol/m²*hr
4-Phenylcyclohexene	4994-16-5	4.5	9.0	µg/m²*hr
1-Methyl-2-pyrrolidinone <sup>(C)</sup>	872-50-4	110	223	µg/m²*hr
Individual VOCs <sup>(D)</sup>	-	1/2 CREL or 1/100th TLV	1/2 CREL or 1/100th TLV	-

<sup>(A)</sup> Defined to be the total response of measured VOCs falling within the C<sub>6</sub> – C<sub>16</sub> range, with responses calibrated to a toluene surrogate.

<sup>(B)</sup> The sum of all measured normal aldehydes from formaldehyde through nonanal, plus benzaldehyde, individually calibrated to a compound specific standard. Heptanal through nonanal are measured via TD/GC/MS analysis and the remaining aldehydes are measured using HPLC/UV analysis.

<sup>(C)</sup> Based on the CA Prop 65 Maximum Allowable Dose Level for inhalation of 3,200 µg/day and an inhalation rate of 20 m³/day.

<sup>(D)</sup> Allowable levels for chemicals not listed are derived from the lower of 1/2 the California Office of Environmental Health Hazard Assessment (OEHHA) Chronic Reference Exposure Level (CREL) as required per the CDPH/EHLB/Standard Method v1.2 and BIFMA level credit 7.6.2 and 1/100th of the Threshold Limit Value (TLV) industrial work place standard (Reference: American Conference of Government Industrial Hygienists, 6500 Glenway, Building D-7, and Cincinnati, OH 45211-4438).



UL investigated representative samples of the identified Product(s) to the identified Standard(s) or other requirements in accordance with the agreements and any applicable program service terms in place between UL and the Certificate Holder (collectively "Agreement"). The Certificate Holder is authorized to use the UL Mark for the identified Product(s) manufactured at the production site(s) covered by the UL Test Report, in accordance with the terms of the Agreement. This Certificate is valid for the identified dates unless there is non-compliance with the Agreement.

SCS Global Services does hereby certify that an independent assessment has been conducted on behalf of:

## Lockers Manufacturing

209 Pearson St, Batesville, Mississippi 38606, United States

For the following product(s):

### Storage:

All Welded, Angle Iron, Knock Down, Knock Down Heavy Duty, Knock Down Plus, Open Front  
All Welded, Open Front Knock Down

The product(s) meet(s) all of the necessary qualifications to be certified for the following claim(s):

### Indoor Advantage™ Gold

Indoor Air Quality Certified to SCS-105 v4.2

Conforms to the ANSI/BIFMA Furniture Emissions Standard (M7.1/X7.1-2011 R2021 and ANSI/BIFMA e.3-2019 (Credits 7.6.1, 7.6.2, 7.6.3) for the open plan and private office workstation parameters.<sup>1</sup> Also, conforms to the CDPH/EHLB Standard Method (CA 01350) v1.2-2017 for the open plan and school classroom parameters.<sup>1</sup>

<sup>1</sup>Modeled as Individual Furniture Components

Registration # SCS-IAQ-05906


Valid from: January 06, 2025 to January 05, 2026



A handwritten signature in black ink, appearing to read "D. Phillips".

Diana Kirsanova Phillips, Chief Assurance  
Officer,  
SCS Global Services

# MIDWEST REFERENCE LIST

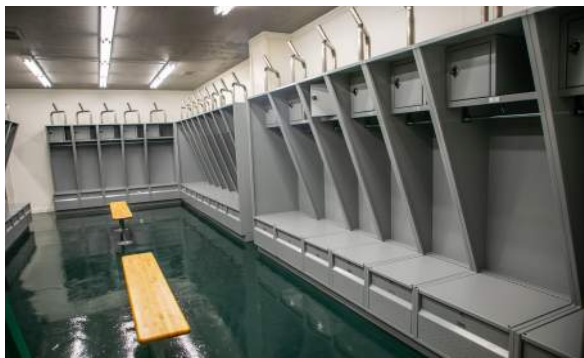

**Project:** Batesville Community School Corporation - High School Stadium Building Renovation

**Address:** 1 Bulldog Blvd. W. Batesville, IN 47006

**Price:** \$67,799.60

**GC:** Bruns-Gutzlizer

**Contact Information:** Tony Gutzwiller C. 812-363-3308

tonyg@bruns-gutzwiller.com

**Architect:** Fanning Howay

**Contact Information:** 317-848-0966

**Owner:** Batesville community school corporation

**Project:** Construction of Spring Hill Middle School

**Address:** 301 South St, Spring Hill, KS 66083

**Price:** \$120,283.40

**GC:** Zimmerman Construction

**Contact Information:** Jack Zimmerman C. 913-927-2255

jack@zimmerman-construction.com

**Architect:** DLR Group

**Contact Information:** 651-977-2814

**Owner:** Spring Hill School District

**Project:** UAMC UPPER ARLINGTON

**Address:** 3600 Tremont Road Upper Arlington, OH 43221

**Price:** \$53,448.34

**GC:** Elford INC

**Contact Information:** Tim Brown C. 614-202-1810

O. 614-545-3039 tibrown@elford.com

**Architect:** Legat Architects

**Contact Information:** 614-228-7758

**Owner:** UAMC

DISCLAIMER\* Pictures shown are not representations of the projects listed.

**CONTACT US**



**662-338-4340**



**WWW.LOCKERSMFG.COM**



## Section 10 51 13

### LockersMFG All-Welded Locker

#### SECTION 10 51 13 – METAL LOCKERS

##### PART 1 - GENERAL

##### 1.01 RELATED DOCUMENTS

- A. Drawings and general provisions of the Contract, including General and Supplementary Conditions and Division 01 Specification Sections, apply to this Section.

##### 1.02 SUMMARY

- A. Section Includes:
  - 1. Welded Lockers.
  - 2. Locker Benches.

##### 1.03 SUBMITTALS

- A. Shop Drawings: Dimensioned drawings, including plans, elevations, and sections to show locker locations and interfaces with adjacent substrates.
- B. Color Samples: Manufacturer's color samples showing the full range of colors available.
- C. Product Data:
  - 1. Preparation instructions and recommendations.
  - 2. Storage and handling requirements and recommendations.
  - 3. Installation methods
- D. Field Dimensions: Verify that drawings with the actual dimensions of the areas receiving the lockers must be submitted to the manufacturer prior to fabrication of the lockers and accessories.

##### 1.04 QUALITY ASSURANCE

- A. Regulatory Requirements: Where metal lockers are indicated to comply with accessibility requirements, comply with the U.S. Architectural & Transportation Barriers Compliance Board's "Americans with Disabilities Act (ADA) and Architectural Barriers Act (ABA) Accessibility Guidelines for Buildings and Facilities" and ICC/ANSI A117.1.
- B. Source Limitations: Provide lockers and benches from a single manufacturer to ensure uniformity.

##### 1.05 DELIVERY, STORAGE, AND HANDLING

- A. Store products in the manufacturer's unopened packaging until ready for installation to protect the locker finish and adjacent surfaces from damage.





## 1.06 WARRANTY

- A. Manufacturer's Standard Limited Lifetime Warranty against defective parts and workmanship, excluding vandalism and improper installation and use.

## 1.07 CONSTRUCTION REQUIREMENTS

- A. All lockers shall be powder-coated steel as designed and manufactured by Lockers Manufacturing. Lockers Manufacturing will furnish all labor and materials for the completion of work in this section, as shown in the approved drawings and specifications.

## PART 2 - PRODUCTS

### 2.01 MANUFACTURER

- A. Lockers Manufacturing, located at 209 Pearson Steet, Batesville, MS 38606: Phone: 662-338-4340; Email: [sales@lockersmfg.com](mailto:sales@lockersmfg.com); Website: [www.lockersmfg.com](http://www.lockersmfg.com).
- B. Request for substitutions will be evaluated only if they are submitted with supporting documents to show that they are equal to or better than these specification standards.

### 2.02 PERFORMANCE AND DESIGN REQUIREMENTS

- A. Lockers shall be GREENGUARD Gold Certified by UL Environment through the GREENGUARD Certification Program.
- B. Lockers shall be SCS Global Services Indoor Advantage Gold Certified through the SCS Indoor Advantage Certification Program.

### 2.03 MATERIAL

- A. Steel parts shall be mild cold-rolled commercial quality steel, capable of taking a high-grade enamel finish.

### 2.04 WELDED LOCKERS

- A. Basis of Design: All Welded Series by LockersMFG. Diamond perforations on doors and sides. Non-riveted.
  - 1. Tier:
  - 2. Width:
  - 3. Depth:
  - 4. Height:
  - 5. Dimensions:
- B. Door Frames: Shall be 16-guage (0.0598-inch) formed in a channel shape with continuous vertical door strike.



- C. Door: 14-gauge (0.0747-inch) steel formations are full channel shape on the lock side adequate depth to fully conceal the lock bar, channel formation on the hinge side, and right-angle formations across the top and bottom.
1. Doors over 15" wide and 30" high: Provide with 3" wide 16-gauge (0.0598-inch) fill height reinforcing pan, welded to inside face of door at 6" centers.
- D. Ventilation: All sides and doors 20" or higher shall be perforated with diamond-shaped perforations. Optional solid doors and sides. Optional ventilation patterns available upon request. (Full louvers, standard louvers, mini louvers, solid, rectangular perforations).
- E. Body: Steel specially formed for added strength and rigidity and to ensure tight joints at fastening points.
1. Bottoms: 16-gauge (0.0598-inch) sheet steel, notched and formed sheet; one continuous bottom for each group of lockers.
  2. Tops: 16-gauge (0.0598-inch) sheet steel, notched and formed sheet.
  3. Sides: 16-gauge (0.0598-inch) sheet steel.
  4. Backs: 18-gauge (0.0478-inch) sheet steel.
  5. Shelves: 16-gauge (0.0598-inch) sheet steel, flanged four sides with additional return flange on front edge to increase strength.
- F. Base: Integral Metal Base: 4" or 6" high 16-gauge (0.0598-inch) steel channel, welded to the locker bottom.
1. Legs (option): Furnish each group of lockers with 4" or 6" high 14-gauge (0.0747-inch) steel legs welded to locker bottom.
  2. No base (option).
- G. Door Handle: Handles shall be recessed in the door.
1. Drawn pocket shall be 20-gauge (0.0359-inch) brushed stainless steel securely fastened to the door with two tabs plus a positive tamper resistant fastener. The pocket shall be of sufficient depth for a combination padlock, built-in combination lock or key lock from protruding beyond the face of the door.
- H. Latching: Shall be multi-point latch.
1. A lock hole cover plate shall be provided for use with padlocks.
  2. The lifting piece shall be 14-gauge (0.0747-inch) formed steel, attached to the latching channel with one concealed retaining lug and one rivet
  3. The handle finger lift shall have a padlock eye for use with a 9-32" diameter padlock shackle. It shall have a sound-deadening molded comfortable finger lift.
  4. Doors to have latch clip engaging the door frame at three points on doors over 42" high and two points on all other doors.
  5. Locking device to be positive, automatic type, whereby locker door may be locked when opened, then closed without unlocking.
  6. One rubber silencer shall be firmly secured in the frame at each latch hook.
  7. Latch hooks on diamond perforated lockers shall have tamper guards.

- I. Hinges: Shall be 16-gauge (0.0598-inch) continuous piano-type hinge welded to the door and riveted to the frame for the full height of the door. Optional 2" high, double spun, full loop tight pin, five knuckle butt hinge welded to the frame and riveted to door.
- J. Box Lockers: Door shall be 14-gauge (0.0747-inch) steel, punched for built-in lock or padlock. Equip doors for use with padlocks with an 18-gauge (0.0478-inch) combination door pull, staple, and lock hole cover plate with integral friction.
- K. Interior Equipment: Full-width shelf, coat rod, and two single prong hooks.
  - 1. All hooks are zinc plated steel with ballpoint heads and are attached with two fasteners.
- L. Number Plates: Provide holes for attaching number plates. Each locker shall have a polished aluminum number plate riveted to door face with black numerals ½" high.
- M. Finish: All components shall have a hybrid epoxy/polyester powder, electrostatically applied to ensure a uniform finished and baked to cure.
  - 1. Powder-coat dry thickness is a minimum 2 mm thick.
  - 2. Color: As selected by Architect from manufacturer's full range.
  - 3. Special Color/Finish
    - a. Custom color
    - b. Anti-Graffiti
    - c. Anti-Microbial

## 2.05 ACCESSORIES (Optional)

- A. Continuous Sloped Hoods: 18-gauge (0.0478-inch) steel, slope rise equal to 1/3 of the locker depth. (18.5 degrees), plus a 1" vertical rise at front. Provide necessary end closures and finish to match lockers.
- B. Exposed End Panels: Minimum 16-gauge (0.0598-inch) steel formed to match locker depth and height. Punched with perimeter holes only.
- C. Finished Box End Panels: Minimum 16-gauge (0.0598-inch) steel formed to match locker depth and height, 1" edge dimension; finish to match lockers; install with concealed fasteners.
- D. Front Fillers: 20-gauge (0.0359-inch) steel formed in an angle shape, with 20-gauge (0.0359-inch) slip joint angles formed in an angle shape with a double bend on one leg forming a pocket to provide adjustable mating with angle filler. Attachment utilizing concealed fasteners finish to match lockers.
- E. Top Fillers: 20-gauge (0.0359-inch) steel.
- F. Recess Trim: 18-gauge (0.0478-inch) steel, 3" face dimension. Vertical and/or horizontal as required. Standard lengths as long as practical; attaches to lockers with concealed clips. Provide necessary finish caps and splices. Finish to match lockers.

- G. Benches: Laminated selected hardwood, 1-1/4" full finished thickness, corners rounded and sanded, surfaces finished with two coats of clear lacquer.
- H. Heavy Duty Bench Pedestals: Steel tubing with 10-gauge (0.1345-inch) steel flanges welded to each end, 16-1/4" high, and finish to match lockers.
- I. Stainless-Steel Free-Standing Bench Pedestal: 2" diameter brushed 16-gauge (0.0598-inch) stainless steel formed into a trapezoid, 14" wide bottom with two 5/16" diameter holes, top flange with four 5/16" diameter holes for fastening to bench.
- J. Locks:
  - 1. Built-in flat key locks; master key same to series.
  - 2. Built-in grooved key Locks (pin tumbler); master key to same series.
  - 3. Built-in three number dialing combination locks capable of at least five different combinations changes; provide master key, combination change key, and combination control charts.
  - 4. Padlocks: Master keyed three number dialing combination type padlocks; provide master key. Mechanism must be resistant to "shimming."

## 2.06 BUILT-IN STANDARD SUPERIOR QUIET LOCKER FEATURES

- A. The Design Specifications: Interior welded double strength plate welded to the door. Fabricated from 16-gauge (0.0598-inch) or 18-gauge (0.0478-inch) steel sheet; formed into channel shape with double a bend at vertical edges and with a single right-angle bend at the horizontal edges. The doors can be equipped with quiet handles and silencing latches.
- B. Quiet Handles: Stainless steel recessed handle with plastic-protected lifting trigger, designed to accept padlock or built-in locks.
- C. Silencing Latches: Nearly silent multi-point latching on heavy gauge frame hooks with rubber buffers that smoothly reduce noise and contact. There is a concealed quiet lock bar that is locked into place and restricts metal-to-metal noise contact by polyethylene glides.
- D. U-Shaped Channel Glide: The spider plastic component tops the inside of the galvanized latch channels, so there is no rattling within the latch bar cavity.
- E. Sound Dampening Panels: LockersMFG standard, designed to stiffen doors and reduce sound levels when doors are closed, of die-formed metal with full perimeter flange and sound-dampening design and material; welded to inner face of doors. Sound-dampening panels are attached horizontally or vertically depending upon the design of the locker.

## 2.07 FABRICATION

- A. Pre-assemble locker by welding into one-piece structures welds free of burrs; maximum width of groups to be 54".
  - 1. Fabricate locker square, rigid, without warp, with metal faces and free of distortion.
  - 2. No nuts, bolts, or rivets shall be used in the assembly of locker groups.



## PART 3 - EXECUTION

### 3.01 PREPARATION

- A. Verify that base is level. Do not begin installation until the base has been properly prepared. If bases or substrates are unsatisfactory, notify Architect immediately before proceeding.
  - 1. Clean surfaces thoroughly prior to installation.

### 3.02 INSTALLATION

- A. Lockers shall be installed in compliance with Lockers Manufacturing installation instructions and shall be level and plumb with flush surfaces and rigid attachment to anchoring surfaces.
  - 1. Bolt adjoining locker units together to provide rigid installation.
  - 2. Assembly by bolting is acceptable, Lockers Manufacturing recommends assembly by riveting.
  - 3. Install sloping tops and metal fillers using concealed fasteners. Provide flush hairline joints against adjacent surfaces.
  - 4. Install benches by fastening bench tops to pedestals and securely anchoring to the floor using appropriate anchors for the floor material.
- B. Anchor lockers to floor and wall
  - 1. Anchor lockers to floor and wall at 48 inches or less, as recommended by the manufacturer.
- C. With factory supplied paint and repair or replace damaged products before substantial completion.

### 3.03 ADJUST AND CLEAN

- A. Adjust doors and latches to operate without binding. Verify that latches are operating satisfactorily.
- B. Adjust built-in locks to prevent binding of dial or key and ensure smooth operation prior to substantial completion.

### 3.04 PROTECTION

- A. Protect installed products until completion of project.

## END OF SECTION

# PROPOSAL FORM

## Hamilton ISD

### Rock Gym & Junior High Gym Renovation

Name of Proposer:

---

The Undersigned, in compliance with Advertisement of Proposals, has received and examined Contract Documents and conditions regarding this project and, having examined site of this project, propose to:

1. Hold proposal valid for at least 60 days after submission date.
2. Enter into and execute a contract, if awarded on the basis of this proposal and to furnish required bonds and insurance coverage.
3. Accomplish Work in accordance with Contract Documents.
4. Complete Work by the time stipulated in Proposal and under conditions described in Contract documents.
5. Accept all the provisions, terms and conditions of this proposal.

#### ACKNOWLEDGEMENT OF ADDENDA:

- ☐ Proposer acknowledges receipt of Addenda Nos. \_\_\_\_\_ through \_\_\_\_\_ and that the Proposals contained herein are offered in after review and consideration of same.
- ☐ To the best of the Proposer's knowledge, no Addenda have been issued.

#### 1. BASE PROPOSAL (INCLUDING ALLOWANCES - FROM SECTION 01 21 00):

Numerical Dollars \_\_\_\_\_

Written in Words \_\_\_\_\_

#### 2. ADDITIVE ALTERNATE 1 (Junior High Gym - Boys and Girls Public Restroom Renovation):

Numerical Dollars \_\_\_\_\_

Written in Words \_\_\_\_\_

**3. ADDITIVE ALTERNATE 2 (Renovation of Entry Vestibules and Classroom):**

Numerical Dollars \_\_\_\_\_

Written in Words \_\_\_\_\_

**4. ADDITIVE ALTERNATE 3 (Add HVAC to Existing Weight Room):**

Numerical Dollars \_\_\_\_\_

Written in Words \_\_\_\_\_

**5. ADDITIVE ALTERNATE 4 (Add Clean, Prep & Paint Existing Wood Bleachers in Rock Gym):**

Numerical Dollars \_\_\_\_\_

Written in Words \_\_\_\_\_

**DEVIATION TO CONSTRUCTION DOCUMENTS:** Contractor shall list proposed deviations to the construction documents.

\_\_\_\_\_

**CONSTRUCTION DURATION :** The undersigned agrees to be Substantially Complete with all Work in \_\_\_\_\_ consecutive calendar days from Notice to Proceed.

**LIQUIDATED DAMAGES:** It is expressly agreed as a part of the consideration inducing the Owner to execute an Agreement that the Owner may deduct from any Payment made to the Contractor a sum equal to \$100.00 per day for each and every additional calendar day

beyond the agreed dates of Substantial Completion and Final Completion. It is also agreed that the Owner may deduct a sum equal to \$100.00 per calendar day from any Payment made to Contractor before or at Final payment; or, if sufficient funds are not available, then Contractor shall pay Owner, the amounts specified per day for each and every calendar day the breach continues after the deadline for Final Completion of the Work.

By signing this Execution of Offer, I do hereby declare that I have read the Request for Competitive Sealed Proposal, on which our Proposal is submitted and had made an investigation such that Proposer is fully informed of the conditions, facilities, difficulties, restrictions and requirements which Proposer will, or may encounter in the completion of the Project, and with full knowledge of the requirements, and does hereby agree to execute a contract for above work, for stated compensation. Undersigned further agrees, if awarded contract, to execute and deliver to Architect within 10 days after contract signing, a Performance Bond (if accepted by owner) and Labor and Material Payment Bond equal to 100% of contract sum in accordance with Proposal.

Name of Contracting Firm: \_\_\_\_\_

Address: \_\_\_\_\_

Authorized Signature: \_\_\_\_\_

Printed Name: \_\_\_\_\_

Title: \_\_\_\_\_

SEAL – If bid is by a corporation.



This page intentionally left blank



## **SECTION 01 10 00 - SUMMARY**

### **PART 1 GENERAL**

#### **1.1 PROJECT**

- A. Project Name: HAMILTON ISD - ROCK GYM AND JUNIOR HIGH GYM RENOVATION
- B. OWNER's Name: Hamilton Independent School District
- C. Architect's Name: Jacob & Martin, LLC
- D. The Project consists of the alteration of two existing Gyms; Rock Gym and Junior High School Gym.

#### **1.2 CONTRACT DESCRIPTION**

- A. Contract Type: A single prime contract based on a Stipulated Price as described in documents from Architect.

#### **1.3 DESCRIPTION OF ALTERATIONS WORK**

- A. Scope of demolition and removal work is indicated on drawings and specified in Section 02 41 00.
- B. Scope of alterations work is indicated on drawings.
- C. Renovate the following areas, complete including operational mechanical and electrical work, finishes, and structural foundation systems.:
  - 1. Rock Gym - Minor renovation to repair existing court floor structure, replace wood court flooring system and addition of HVAC equipment.
  - 2. Junior High School Gym - Renovation of the existing Gym foundation, locker rooms, mezzanine and addition of HVAC equipment.

#### **1.4 OWNER OCCUPANCY**

- A. OWNER intends to continue to occupy adjacent portions of the existing building during the entire construction period.
- B. Cooperate with OWNER to minimize conflict and to facilitate OWNER's operations.
- C. Schedule the Work to accommodate OWNER occupancy.

#### **1.5 CONTRACTOR USE OF SITE AND PREMISES**

- A. Construction Operations: Limited to areas noted on Drawings.
- B. Arrange use of site to allow:
  - 1. OWNER occupancy.
- C. Provide access to and from site as required by law and by OWNER:
  - 1. Emergency Building Exits During Construction: Keep all exits required by code open during construction period; provide temporary exit signs if exit routes are temporarily altered.
  - 2. Do not obstruct roadways, sidewalks, or other public ways without permit.
- D. Time Restrictions:
  - 1. Coordinate with Owner work schedule that conflicts with testing.
- E. Utility Outages and Shutdown:
  - 1. Limit disruption of utility services to hours the site is unoccupied.
  - 2. Do not disrupt or shut down life safety systems, including but not limited to fire sprinklers and fire alarm system, without 3 days notice to OWNER and authorities having jurisdiction.
  - 3. Prevent accidental disruption of utility services to other facilities.

#### **1.6 WORK SEQUENCE**

- A. Construct Work in stages during the construction period:

1. Stage 1: Rock Gym - Coordinate start of Work with HISD in mid-December 2025. Work must be completed and Rock Gym turned over for HISD use before starting Work on the Junior High Gym.
2. Stage 2: Junior High Gym - Work to comense when Rock Gym is completed and turned over to HISD for use. Work to be completed before Basketball season in November 2026.

**1.7 SPECIFICATION SECTIONS APPLICABLE TO ALL CONTRACTS**

- A. Unless otherwise noted, all provisions of the sections listed below apply to all contracts.  
Specific items of work listed under individual contract descriptions constitute exceptions.
- B. Section 01 20 00 - Price and Payment Procedures.
- C. Section 01 21 00 - Allowances.
- D. Section 01 23 00 - Alternates.
- E. Section 01 30 00 - Administrative Requirements.
- F. Section 01 32 16 - Construction Progress Schedule.
- G. Section 01 40 00 - Quality Requirements.
- H. Section 01 50 00 - Temporary Facilities and Controls.
- I. Section 01 51 00 - Temporary Utilities.
- J. Section 01 60 00 - Product Requirements.
- K. Section 01 70 00 - Execution and Closeout Requirements.
- L. Section 01 78 00 - Closeout Submittals.

**PART 2 PRODUCTS - NOT USED**

**PART 3 EXECUTION - NOT USED**

**END OF SECTION 01 10 00**



## **SECTION 01 21 00 - ALLOWANCES**

### **PART 1 GENERAL**

#### **1.1 SECTION INCLUDES**

- A. Cash allowances.
- B. Contingency allowance.
- C. Inspecting and testing allowances.
- D. Payment and modification procedures relating to allowances.

#### **1.2 RELATED REQUIREMENTS**

- A. Section 01 20 00 - Price and Payment Procedures: Additional payment and modification procedures.

#### **1.3 ALLOWANCES**

- A. The Allowances are to be used only as directed by Architect for Owner's purposes.
- B. Contractor's costs for products, delivery, installation, labor, insurance, payroll, taxes, bonding, equipment rental, overhead and profit will be included in Change Orders authorizing expenditure of funds from this Contingency Allowance.
- C. Costs not included in the Allowances: Contractor's costs for overhead, profit, bonds and insurance. These costs shall be included in the Contract Sum.
- D. Funds will be drawn from the Allowances only by Change Order.
- E. At closeout of Contract, funds remaining in Allowances will be credited to Owner by Change Order.

#### **1.4 INSPECTING AND TESTING ALLOWANCES**

- A. Costs Included in Inspecting and Testing Allowances: Cost of engaging an inspecting or testing agency; execution of inspecting and tests; and reporting results.
- B. Costs Not Included in the Inspecting and Testing Allowances:
  - 1. Costs of incidental labor and facilities required to assist inspecting or testing agency.
  - 2. Costs of testing services used by Contractor separate from Contract Document requirements.
  - 3. Costs of retesting upon failure of previous tests as determined by Architect.
- C. Payment Procedures:
  - 1. Submit one copy of the inspecting or testing firm's invoice with next application for payment.
  - 2. Pay invoice on approval by Architect.
- D. Differences in cost will be adjusted by Change Order.

#### **1.5 ALLOWANCES SCHEDULE**

- A. Section 02 41 00 - Demolition: Include the stipulated sum of Twenty Thousand Dollars (\$20,000.00) to cut a construction opening that is 10'-4" x 8'-6" on the south side of the Junior High Gym and then infill with concrete with exposed aggregate to match existing..
- B. Section 10 14 00 -Signage: Include the stipulated sum of Ten Thousand (\$10,000) for purchase and delivery of interior room signs.
- C. Owner Contingency: Include the sum of Two Hundred Thousand Dollars (\$200,000) as an adjustable allowance to be used at the discretion of the Owner for betterment decided upon as the work progresses.
- D. Inspecting and Testing Allowance: Include the sum of One Hundred Thousand (\$100,000) for payment of inspecting and testing services as specified in the Structural Documents.
- E. OMIT Allowance - Provide Testing, Balancing & Commissioning in Base Bid as specified in 23 99 00 & 26 08 00.

JACOB|MARTIN  
HAMILTON ISD - ROCK GYM AND JUNIOR HIGH  
GYM RENOVATION

01 21 00  
ALLOWANCES

- F. Owner Structural Contingency: Include the sum of One Hundred Thousand (\$100,000) for unknown conditions.

**PART 2 PRODUCTS - NOT USED**

**PART 3 EXECUTION - NOT USED**

**END OF SECTION 01 21 00**



## **SECTION 01 23 00 - ALTERNATES**

### **PART 1 GENERAL**

#### **1.1 SECTION INCLUDES**

- A. Description of Alternates.
- B. Procedures for pricing Alternates.

#### **1.2 RELATED REQUIREMENTS**

- A. Document 00 21 13 - Instructions to Bidders: Instructions for preparation of pricing for Alternates.
- B. Document 00 52 00 - Agreement Form: Incorporating monetary value of accepted Alternates.

#### **1.3 DEFINITIONS**

- A. Alternate: An amount proposed by bidders and stated on the Bid Form for certain work defined in the bidding requirements that may be added to or deducted from the base bid amount if Owner decides to accept a corresponding change either in the amount of construction to be completed or in the products, materials, equipment, systems, or installation methods described in the Contract Documents.
  - 1. Alternates described in this Section are part of the Work only if enumerated in the Agreement.
  - 2. The cost or credit for each alternate is the net addition to or deduction from the Contract Sum to incorporate alternate into the Work. No other adjustments are made to the Contract Sum.

#### **1.4 PROCEDURES**

- A. Coordination: Revise or adjust affected adjacent work as necessary to completely integrate work of the alternate into Project.
  - 1. Include as part of each alternate, miscellaneous devices, accessory objects, and similar items incidental to or required for a complete installation whether or not indicated as part of alternate.

#### **1.5 ACCEPTANCE OF ALTERNATES**

- A. Alternates quoted on Bid Forms will be reviewed and accepted or rejected at OWNER's option. Accepted Alternates will be identified in the Owner-Contractor Agreement.
- B. Coordinate related work and modify surrounding work to integrate the Work of each Alternate.

#### **1.6 SCHEDULE OF ALTERNATES**

- A. Alternate No. One - Junior High Gym - Boys and Girls public restroom renovation.:
  - 1. Increase Base Bid for Boys & Girls Toilets - 542 SF.
  - 2. Alternate Item: Drawing number A2.2 including MEP.
- B. Alternate No. Two - Renovation of Entry Vestibules and Classroom:
  - 1. Increase Base Bid for Interior Renovation of the Vestibules - 1,706 SF.
  - 2. Alternate Item: Drawing number A2.4 including MEP.
- C. Alternate No. Three - Add HVAC to Existing Weight Room:
  - 1. Existing Weight Room
  - 2. Alternate Item: Drawing number A2.2 including MEP.
- D. Alternate No. Four - Clean, Prep & Paint Existing Wood Bleachers in Rock Gym:
  - 1. Rock Gym.

### **PART 2 PRODUCTS - NOT USED**

### **PART 3 EXECUTION - NOT USED**

**END OF SECTION 01 23 00**

This page intentionally left blank





## **SECTION 07 95 13 - EXPANSION JOINT COVER ASSEMBLIES**

### **PART 1 GENERAL**

#### **1.1 SECTION INCLUDES**

- A. Expansion joint cover assemblies for floor surfaces.

#### **1.2 RELATED REQUIREMENTS**

- A. Section 03 10 00 - Concrete Forming and Accessories: Placement of joint cover assembly frames in formwork.

#### **1.3 REFERENCE STANDARDS**

- A. ASTM B221 - Standard Specification for Aluminum and Aluminum-Alloy Extruded Bars, Rods, Wire, Profiles, and Tubes; 2014.
- B. ASTM B221M - Standard Specification for Aluminum and Aluminum-Alloy Extruded Bars, Rods, Wire, Profiles, and Tubes (Metric); 2013.
- C. ASTM B308/B308M - Standard Specification for Aluminum-Alloy 6061-T6 Standard Structural Profiles; 2010.
- D. ASTM B455 - Standard Specification for Copper-Zinc-Lead Alloy (Leaded-Brass) Extruded Shapes; 2010 (Reapproved 2017).
- E. ITS (DIR) - Directory of Listed Products; current edition.
- F. UL (DIR) - Online Certifications Directory; current listings at database.ul.com.

#### **1.4 ADMINISTRATIVE REQUIREMENTS**

- A. Installation Templates: For frames and anchors to be embedded in concrete or masonry, furnish templates to relevant installers; include installation instructions and tolerances.

#### **1.5 SUBMITTALS**

- A. See Section 01 30 00 - Administrative Requirements, for submittal procedures.
- B. Product Data: Provide joint assembly profiles, profile dimensions, anchorage devices and available colors and finish.
- C. Shop Drawings: Indicate joint and splice locations, miters, layout of the work, affected adjacent construction and anchorage locations.
- D. Manufacturer's Installation Instructions: Indicate rough-in sizes and required tolerances for item placement.
- E. Maintenance Materials: Furnish the following for OWNER's use in maintenance of project.
  - 1. See Section 01 60 00 for additional provisions.

### **PART 2 PRODUCTS**

#### **2.1 MANUFACTURERS**

- A. Expansion Joint Cover Assemblies:
  - 1. Architectural Art Mfg, Inc; \_\_\_\_\_: [www.archart.com/#sle](http://www.archart.com/#sle).
  - 2. Construction Specialties, Inc; \_\_\_\_\_: [www.c-sgroup.com/#sle](http://www.c-sgroup.com/#sle).
  - 3. EMSEAL Joint Systems, Ltd; \_\_\_\_\_: [www.emseal.com/#sle](http://www.emseal.com/#sle).
  - 4. Inpro; \_\_\_\_\_: [www.inprocorp.com/#sle](http://www.inprocorp.com/#sle).
  - 5. MM Systems Corp; \_\_\_\_\_: [www.mmsystemscorp.com/#sle](http://www.mmsystemscorp.com/#sle).
  - 6. Nystrom, Inc; BASIS OF DESIGN: EJM-DTG-200: [www.nystrom.com/#sle](http://www.nystrom.com/#sle).
  - 7. Substitutions: See Section 01 60 00 - Product Requirements.

#### **2.2 EXPANSION JOINT COVER ASSEMBLIES**

- A. Expansion Joint Cover Assemblies - General: Factory-fabricated and assembled; designed to completely fill joint openings, sealed to prevent passage of air, dust, water, smoke; suitable for traffic expected.

EXPANSION JOINT COVER ASSEMBLIES

1. Joint Dimensions and Configurations: As indicated on drawings.
2. Joint Cover Sizes: Selected to suit joint width and configuration, based on manufacturer's published recommendations and limitations.
3. Joint Cover Styles: As indicated on drawings.
4. Joint Movement Capability: If not indicated, provide minimum plus/minus 25 percent joint movement capability.
5. Lengths: Provide covers in full lengths required; avoid splicing wherever possible.
6. Anchors, Fasteners, and Fittings: Provided by cover manufacturer.
- B. Floor Joint Covers: Coordinate with indicated floor coverings.
  1. If floor covering is not indicated, obtain instructions from Architect before proceeding.
  2. If style is not indicated, provide extruded aluminum frame both sides, resilient seals, and minimize exposed metal.
- C. Sliding Cover Plate Type Covers: Provide plate with beveled edges and neat fit that does not collect dirt.

**2.3 MATERIALS**

- A. Extruded Aluminum: ASTM B221 (ASTM B221M), 6063 alloy, T6 temper; or ASTM B308/B308M, 6061 alloy, T6 temper.
  1. Exposed Finish at Floors: Mill finish or natural anodized.
- B. Anchors and Fasteners: As recommended by cover manufacturer.
- C. Ferrous Metal Anchors: Galvanized where embedded in concrete or in contact with cementitious materials.
- D. Threaded Fasteners: Aluminum.
- E. Backing Paint for Aluminum Components in Contact with Cementitious Materials: Asphaltic type.

**PART 3 EXECUTION**

**3.1 EXAMINATION**

- A. Verify that joint preparation and dimensions are acceptable and in accordance with manufacturer's requirements.
- B. Verify that frames and anchors installed by others are in correct locations and suitable for installation of remainder of assembly.

**3.2 INSTALLATION**

- A. Install components and accessories in accordance with manufacturer's instructions.
- B. Align work plumb and level, flush with adjacent surfaces.
- C. Rigidly anchor to substrate to prevent misalignment.

**3.3 PROTECTION**

- A. Do not permit traffic over unprotected floor joint surfaces.
- B. Provide strippable coating to protect finish surface.

**END OF SECTION 07 95 13**

**SECTION 11 66 23 - GYMNASIUM EQUIPMENT**

**PART 1 GENERAL**

**1.1 SECTION INCLUDES**

- A. Wall mounted protection pads.

**1.2 RELATED REQUIREMENTS**

- A. Section 26 05 83 - Wiring Connections.

**1.3 REFERENCE STANDARDS**

- A. ASTM E84 - Standard Test Method for Surface Burning Characteristics of Building Materials; 2016.
- B. AWS D1.1/D1.1M - Structural Welding Code - Steel; 2015 (Errata 2016).
- C. NFPA 70 - National Electrical Code; Most Recent Edition Adopted by Authority Having Jurisdiction, Including All Applicable Amendments and Supplements.
- D. NFPA 101 - Life Safety Code; Most Recent Edition Adopted by Authority Having Jurisdiction, Including All Applicable Amendments and Supplements.
- E. NFPA 286 - Standard Methods of Fire Tests for Evaluating Contribution of Wall and Ceiling Interior Finish to Room Fire Growth; 2015.

**1.4 ADMINISTRATIVE REQUIREMENTS**

- A. Large Components: Ensure that large components can be moved into final position without damage to other construction.
- B. Electrically Operated Equipment: Coordinate location and electrical characteristics of service connection.

**1.5 SUBMITTALS**

- A. See Section 01 30 00 - Administrative Requirements, for submittal procedures.
- B. Product Data: Provide manufacturer's data showing configuration, sizes, materials, finishes, hardware, and accessories; include:
  - 1. Electrical characteristics and connection locations.
  - 2. Fire rating certifications.
  - 3. Structural steel welder certifications.
  - 4. Manufacturer's installation instructions.
- C. Shop Drawings: For custom fabricated equipment indicate, in large scale detail, construction methods; method of attachment or installation; type and gage of metal, hardware, and fittings; plan front elevation; elevations and dimensions; minimum one cross section; utility requirements as to types, sizes, and locations.
- D. Erection Drawings: Detailed dimensional requirements for proper location of equipment.
- E. Samples: Submit samples of wall pad coverings in manufacturer's available range of colors.
- F. Operating and maintenance data, for each operating equipment item.
- G. Warranty: Submit manufacturer warranty and ensure that forms have been completed in OWNER's name and registered with manufacturer.

**1.6 QUALITY ASSURANCE**

- A. Manufacturer Qualifications: Company specializing in manufacturing products specified in this section, with not less than three years of documented experience.
- B. Installer Qualifications: Company specializing in performing work of the type specified with minimum three years of experience.



## **1.7 DELIVERY, STORAGE, AND HANDLING**

- A. Deliver products to project site in manufacturer's original packaging with factory original labels attached.
- B. Store products indoors and elevated above floor; prevent warping, twisting, or sagging.
- C. Store products in accordance with manufacturer's instructions; protect from extremes of weather, temperature, moisture, and other damage.

## **1.8 WARRANTY**

- A. See Section 01 78 00 - Closeout Submittals, for additional warranty requirements.

# **PART 2 PRODUCTS**

## **2.1 GENERAL REQUIREMENTS**

- A. See drawings for sizes and locations, unless noted otherwise.
- B. Hardware: Heavy duty steel hardware, as recommended by manufacturer.

## **2.2 WALL PADDING**

- A. Wall Padding: Foam filling bonded to backing board, wrapped in covering; each panel fabricated in one piece.
  - 1. Performance: Panel shall meet the min. ASTM F2440 Standard Specification for impact performance requirements.
  - 2. Surface Burning Characteristics: Flame spread index (FSI) of 25 or less, smoke developed index (SDI) of 450 or less, Class A, when tested in accordance with ASTM E84 as a complete panel.
  - 3. Flammability: Comply with NFPA 286.
  - 4. Covering: Vinyl-coated polyester fabric, mildew and rot resistant; stapled to back of board
    - a. Color: As selected from manufacturer's standard range.
    - b. Texture: Embossed leather-look.
    - c. Custom Graphics: To be supplied by OWNER. Provide text and graphic art work as indicated on drawings.
    - d. Fabric Weight: 19 oz/sq yd.
  - 5. Foam Thickness: 2 inches.
  - 6. Backing Board: Oriented strand board.
    - a. Thickness: 7/16 inch.
    - b. Surface Burning Characteristics: Flame spread index (FSI) of 25 or less, smoke developed index (SDI) of 450 or less, Class A, when tested in accordance with ASTM E84.
  - 7. Panel Dimensions: 24 inches wide by 96 inches long, including nailing margins.
  - 8. Nailing Margins: 1 inch wide, covered by fabric covering.
  - 9. Mounting: Permanent; using screws.
  - 10. Basis of Design
    - a. Porter Athletic, Inc; 570 - SuperSafe FR Wall Pad, [www.porterathletic.com](http://www.porterathletic.com).
    - b. Other Acceptable Manufacturers:
      - 1) ADP Lemco, Inc: [www.adplemco.com/#sle](http://www.adplemco.com/#sle).
      - 2) Draper, Inc: [www.draperinc.com/#sle](http://www.draperinc.com/#sle).
      - 3) Grand Slam Safety, LLC: [www.grandslamsafety.com/#sle](http://www.grandslamsafety.com/#sle).
      - 4) IPI by Bison, Inc: [www.ipibybison.com/#sle](http://www.ipibybison.com/#sle).
      - 5) Substitutions: See Section 01 60 00 - Product Requirements.
- B. Specially Shaped Padding: Same construction as standard padding; custom fabricate to fit irregularly shaped members, areas, and protrusions in gymnasium as indicated; provide padding for:
  - 1. I-beams.
  - 2. Wall corners.

### **PART 3 EXECUTION**

#### **3.1 EXAMINATION**

- A. Take field measurements to ensure proper fitting of work. If taking field measurements before fabrication will delay work, allow for adjustments within recommended tolerances.
- B. Inspect areas and conditions before installation, and notify Architect in writing of unsatisfactory or detrimental conditions.
- C. Do not proceed with this work until conditions have been corrected; commencing installation constitutes acceptance of work site conditions.
- D. Verify that electrical services are correctly located and have proper characteristics.

#### **3.2 INSTALLATION**

- A. Install in accordance with contract documents and manufacturer's instructions.
- B. Coordinate installation of inserts and anchors that must be built in to flooring or subflooring.
- C. Install equipment rigid, straight, plumb, and level.
- D. Secure equipment with manufacturer's recommended anchoring devices.
- E. Install wall padding securely, with edges tight to wall and without wrinkles in fabric covering.
- F. Separate dissimilar metals to prevent electrolytic corrosion.

#### **3.3 ADJUSTING**

- A. Verify proper placement of equipment.
- B. Verify proper placement of equipment anchors and sleeves, and use actual movable equipment to be anchored if available.
- C. Adjust operating equipment for proper operation; remove and replace equipment causing noise or vibration; lubricate equipment as recommended by manufacturer.

#### **3.4 CLEANING**



- A. Remove masking or protective covering from finished surfaces.
- B. Clean equipment in accordance with manufacturer's recommendations.

#### **3.5 PROTECTION**

- A. Protect installed products until Date of Substantial Completion.
- B. Replace damaged products before Date of Substantial Completion.

**END OF SECTION 11 66 23**

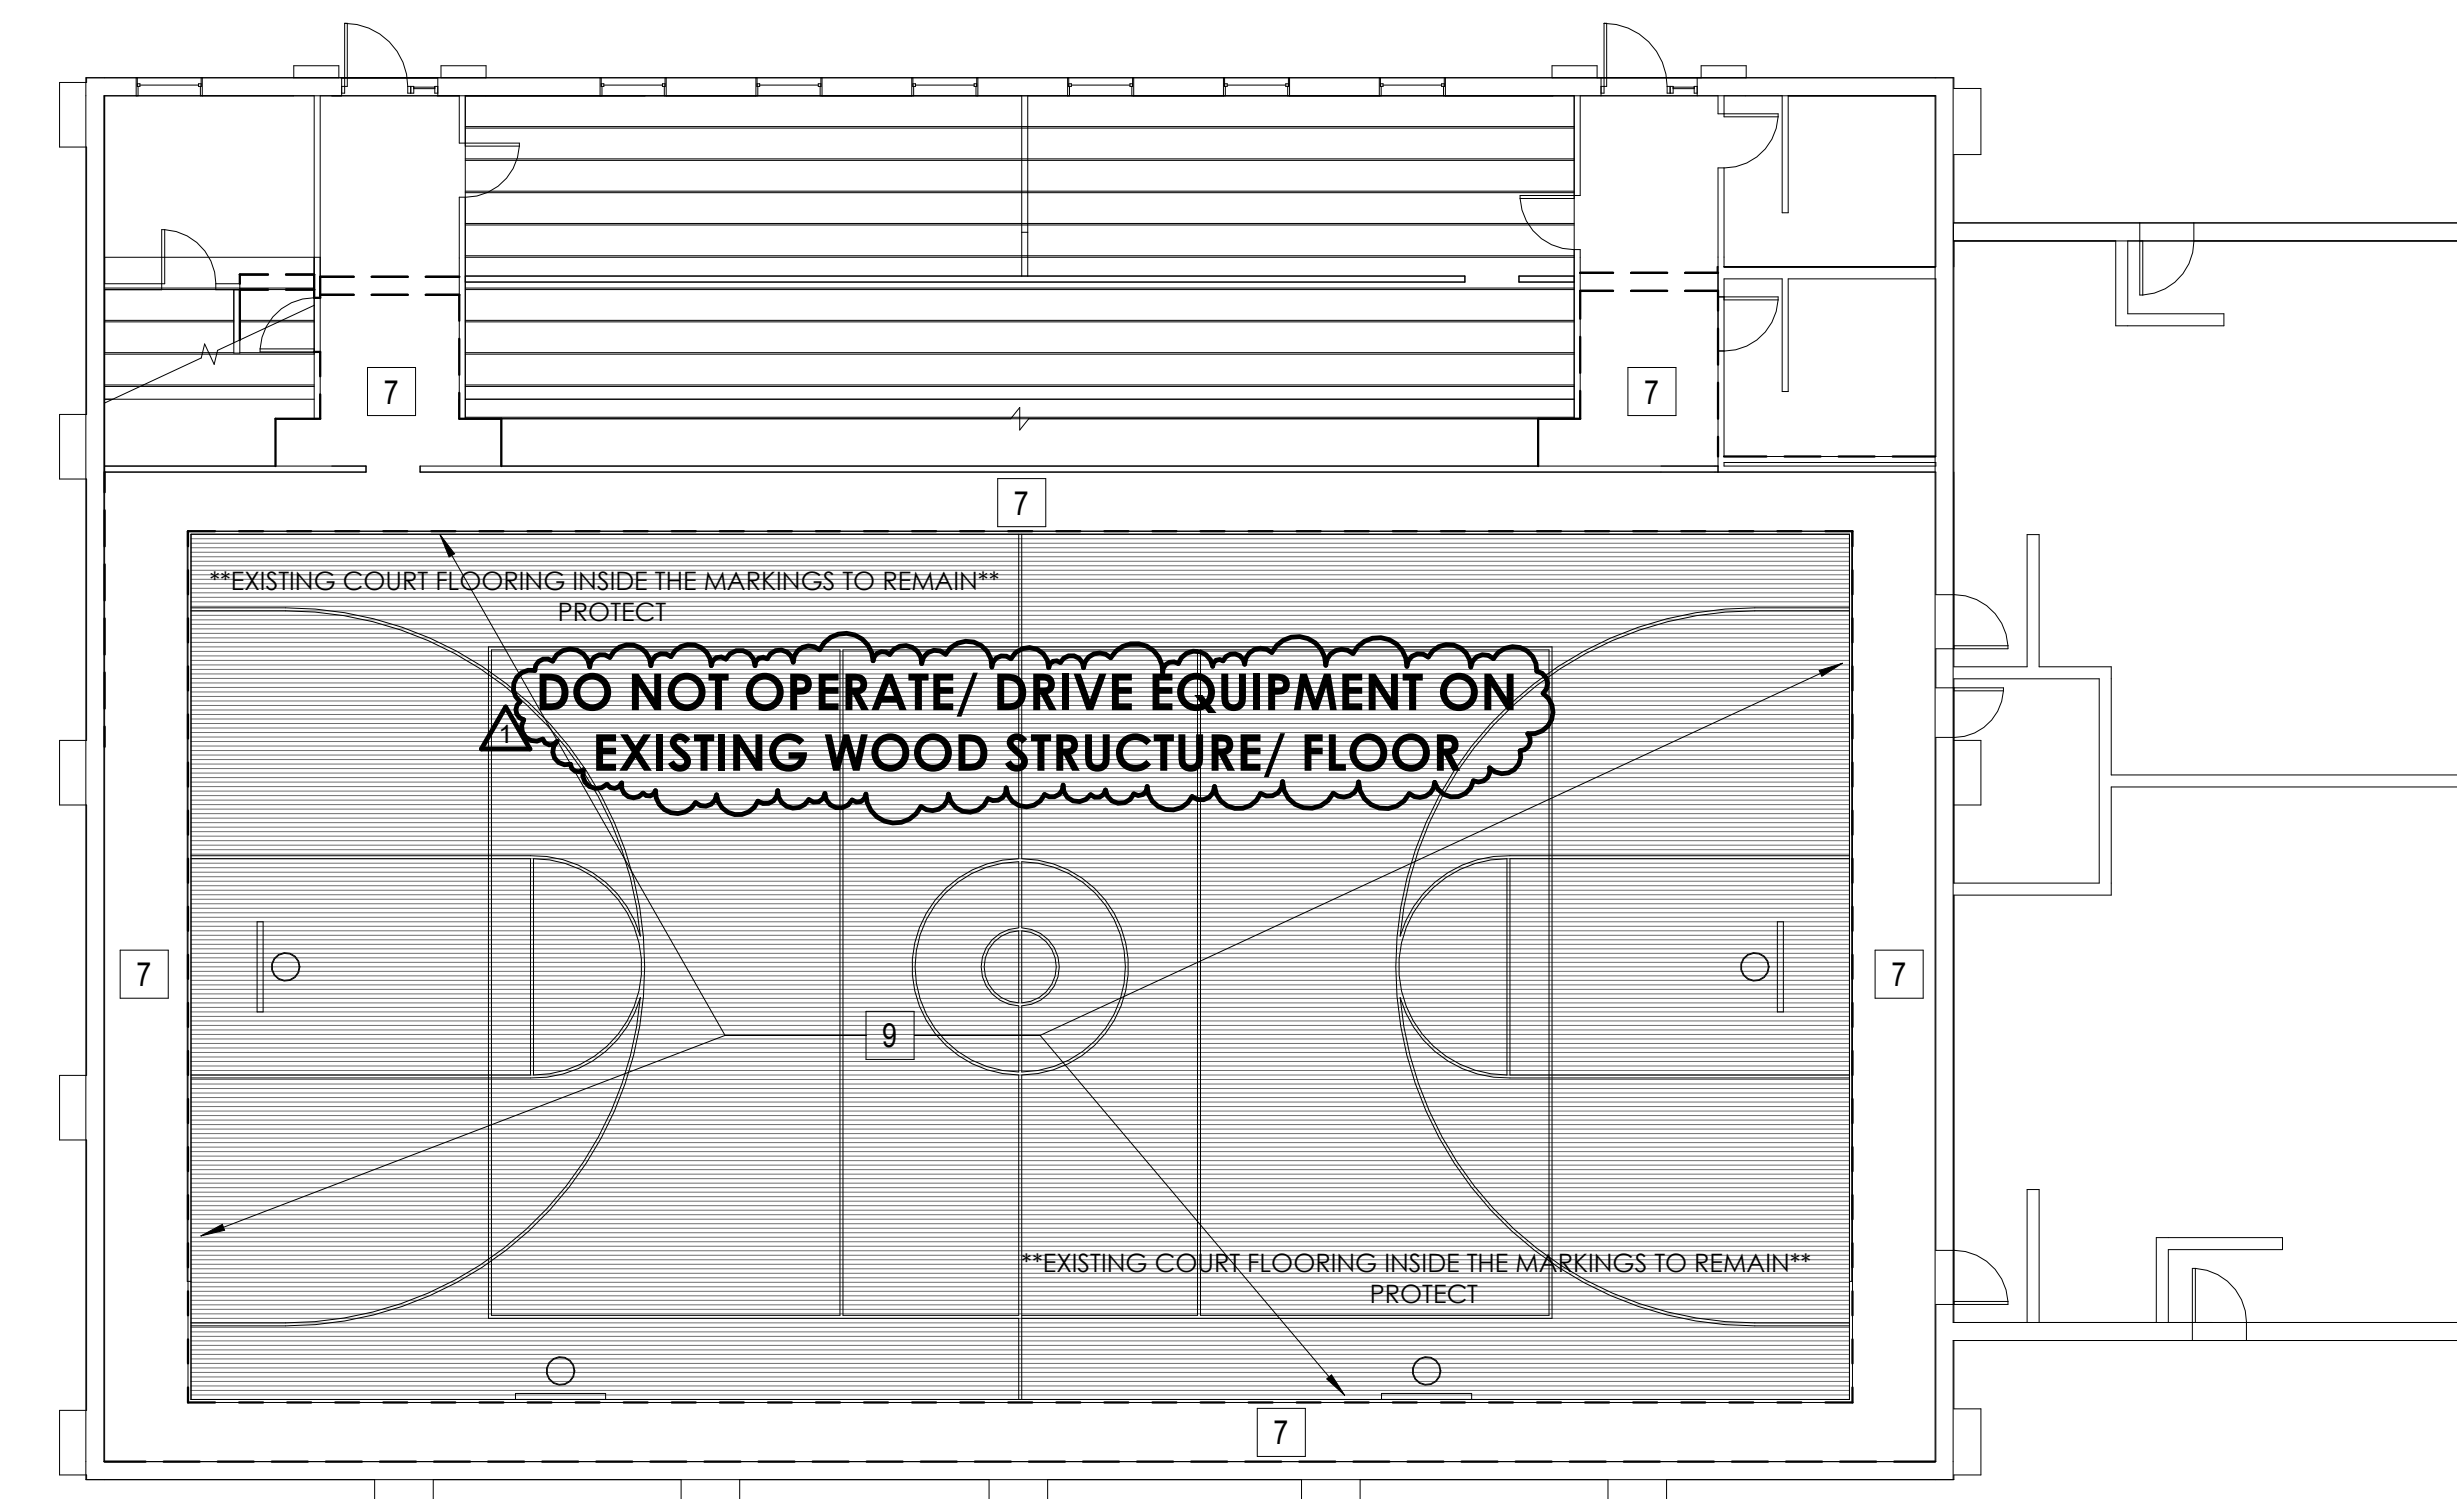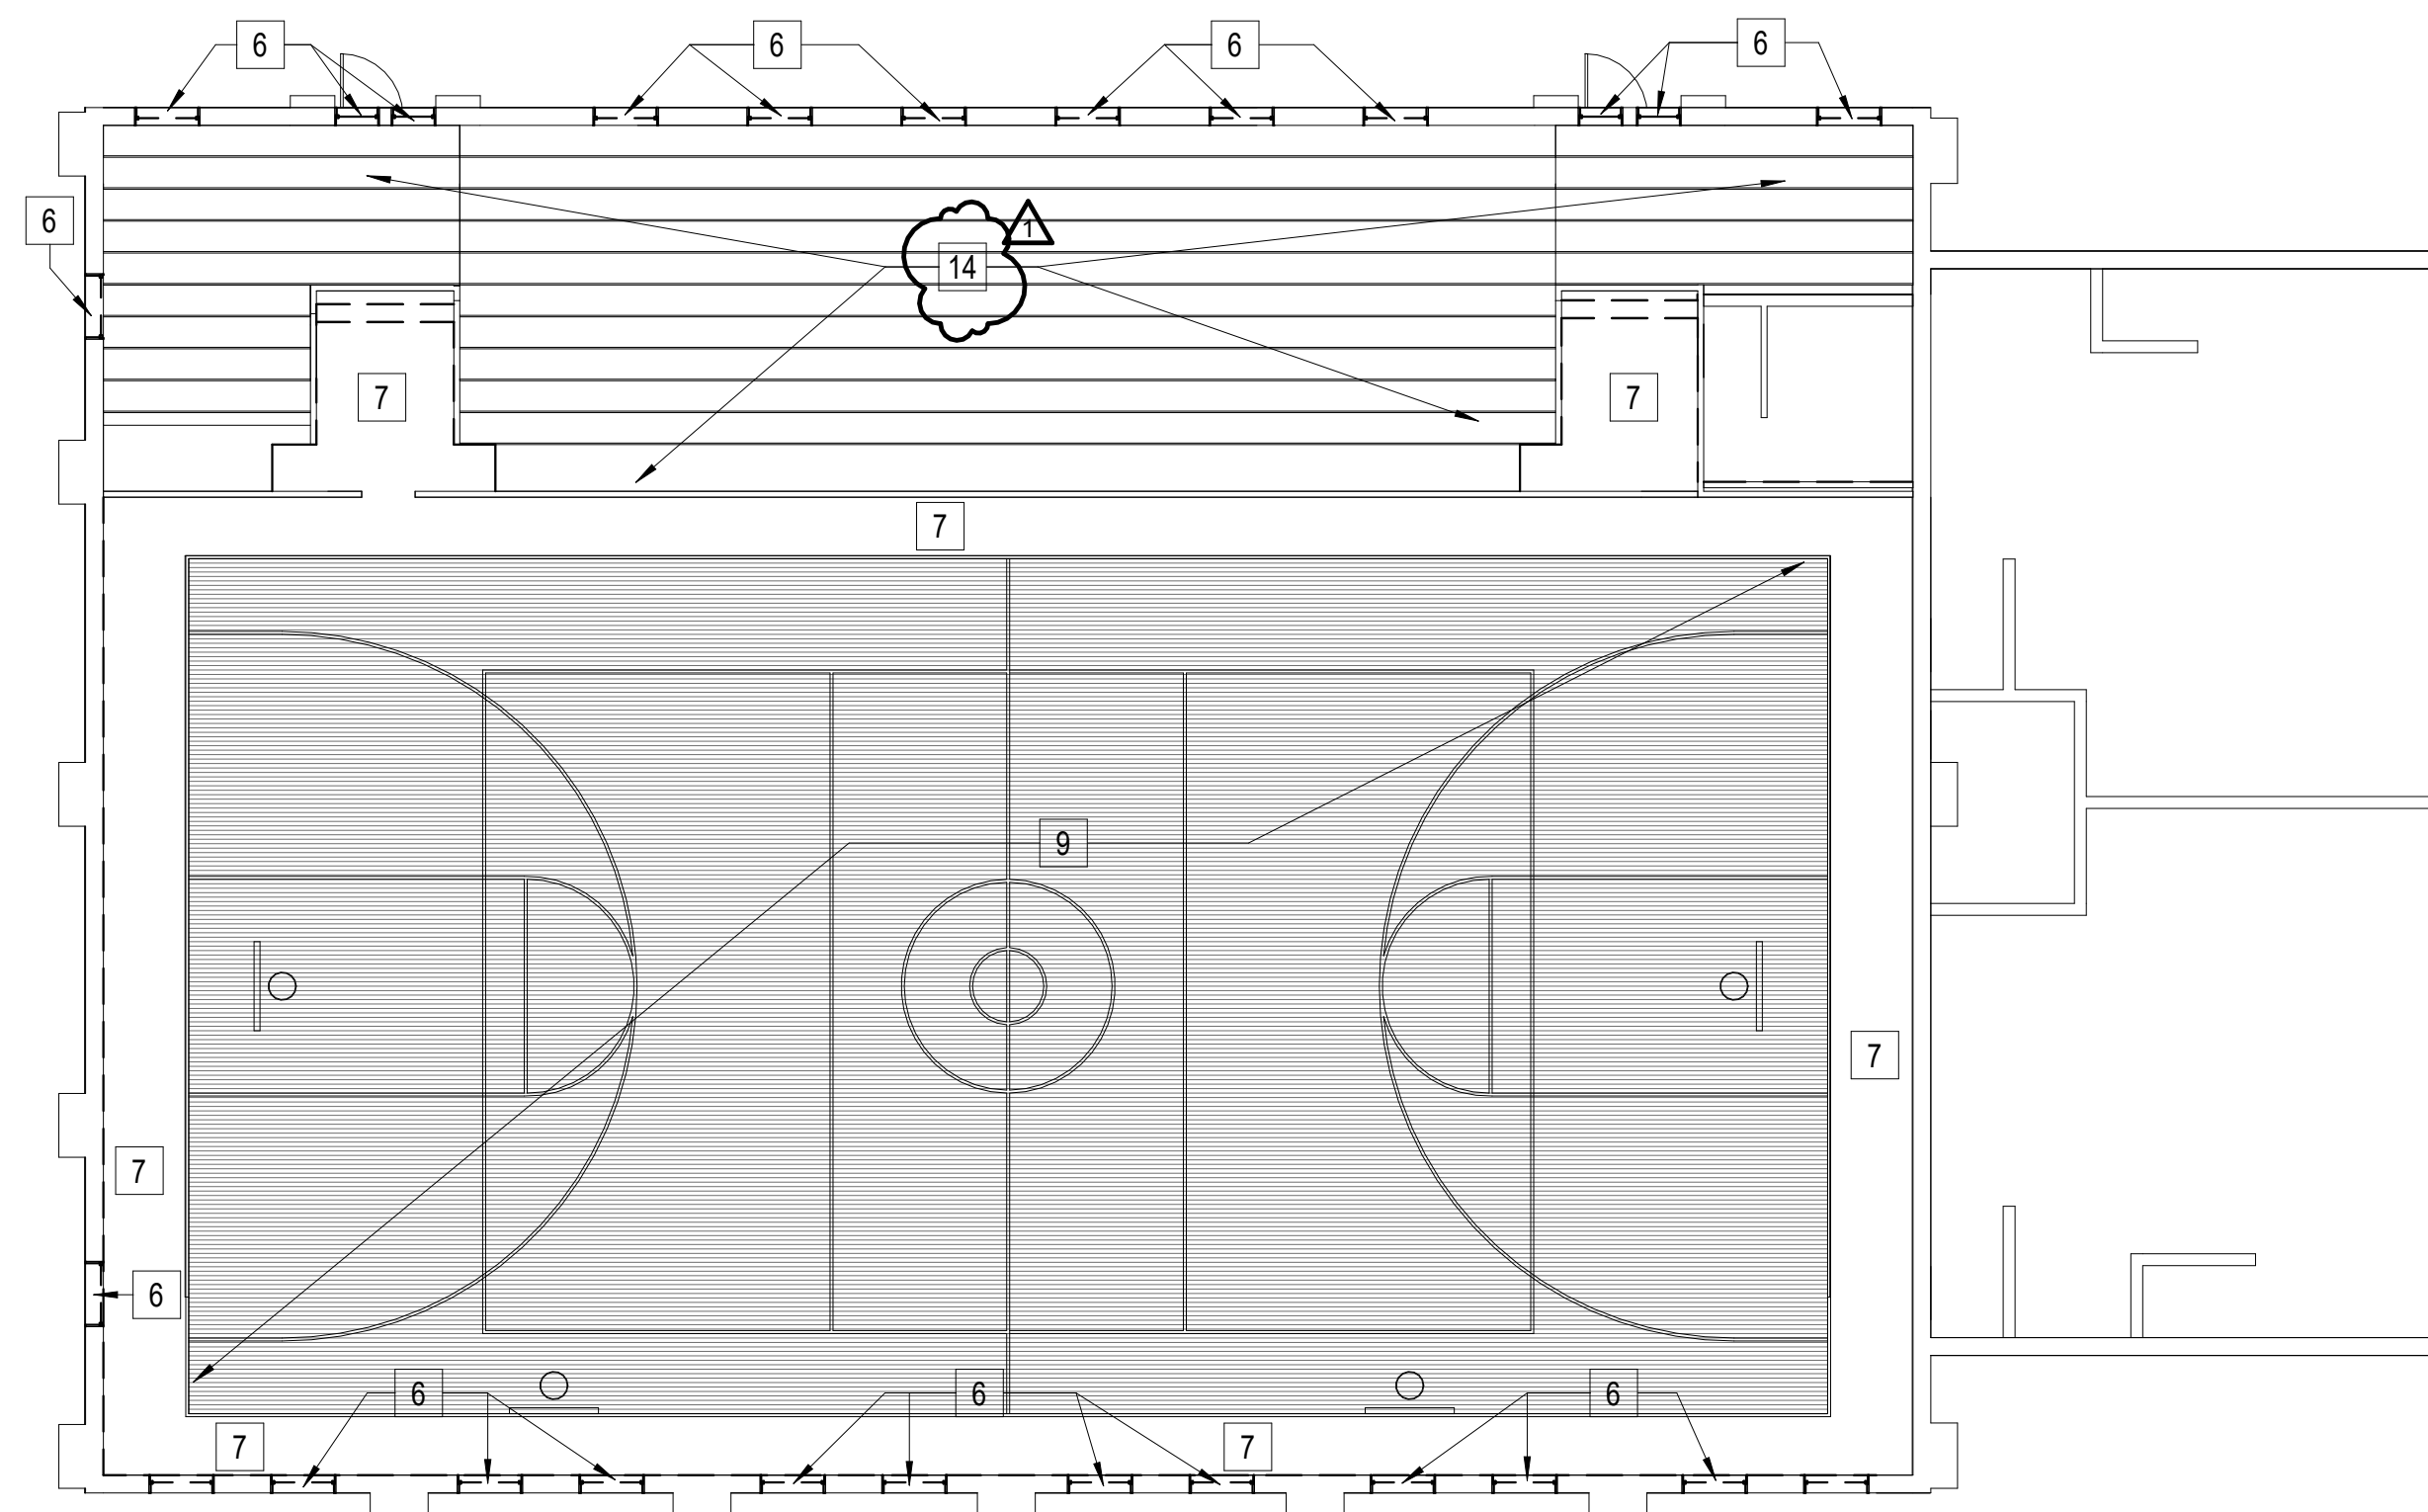


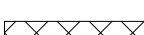
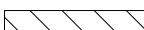
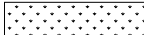
This page intentionally left blank



## DEMOLITION NOTES

- A. PROVIDE NECESSARY PROTECTION TO INSURE THE SAFE PASSAGE OF PERSONS AROUND THE AREA OF DEMOLITION TO PREVENT DAMAGE TO THE ADJACENT MATERIALS. MAINTAIN CLEAR CORRIDORS AND FIRE EXITS AT ALL TIMES.
- B. OWNER WILL REMOVE ALL ASBESTOS MATERIAL AND OTHER RELATED MATERIALS PRIOR TO THE STARTING OF THE PROJECT OR DURING THE PROJECT UNDER SEPARATE CONTRACT. OWNER WILL SCHEDULE THIS WORK TO COORDINATE WITH CONTRACTOR'S SCHEDULE.
- C. EXISTING ITEMS CONCEALED AND NOT DISTURBED SHALL BE ABANDONED IN PLACE AFTER THEY ARE RENDERED HARMLESS AND USELESS. REMOVE LAMPS FROM ALL ABANDONED LIGHT FIXTURES.
- D. ALL ITEMS OR MATERIALS REMOVED FROM THE PROJECT SHALL BE MADE AVAILABLE FOR OWNER'S INSPECTION WITH THE OWNER RETAINING THE OPTION TO CLAIM ANY ITEM OR MATERIAL. ALL CLAIMED ITEMS AND MATERIALS BY THE OWNER SHALL REMAIN ON THE SITE. ALL OTHER ITEMS SHALL BE REMOVED FROM THE SITE.
- E. ALL DEMOLITION REQUIRED FOR PENETRATIONS THRU STRUCTURAL WALLS MUST BE MADE ONLY AFTER INVESTIGATION OF ACTUAL CONDITIONS (WHICH MAY OR MAY NOT BE THE SAME AS RECORDED DOCUMENTS INDICATE). PROVIDE SHORING AND BRACING AS REQUIRED FOR SPECIFIC LOCATIONS. VERIFY WITH ARCHITECT.
- F. REFER TO STRUCTURAL & MEP SHEETS FOR ADDITIONAL DEMOLITION REQUIREMENTS OF THESE TRADES.
- G. EXISTING DOORS AND FRAMES SHALL REMAIN UNLESS NOTED OTHERWISE.
- H. EXISTING WINDOWS SHALL REMAIN UNLESS NOTED OTHERWISE.
- I. CONTRACTOR SHALL SITE VERIFY ALL CONDITIONS AND MEET ALL CITY OF HAMILTON, T.C. CODES. ALL WORK SHALL BE EXECUTED IN STRICT ACCORDANCE WITH ALL LOCAL, STATE, AND NATIONAL CODES, ORDINANCES, AND REGULATIONS GOVERNING THE PARTICULAR CLASS OF WORK INVOLVED AS INTERPRETED BY THE INSPECTING AUTHORITY.
- J. REFERENCE SPECIFICATION SECTION 01 10 00 FOR NOTES ON PROJECT SCHEDULE.
- K. PATCH, REPAIR AND PAINT ALL EXPOSED INTERIOR WALL SURFACES DAMAGED DUE TO WORK PERFORMED

### DEMOLITION SITE LEGEND

	EXISTING CONSTRUCTION TO REMAIN
	EXISTING CONSTRUCTION TO BE REMOVED
	KEYED NOTE - REFER THIS SHEET
	ALTERNATE 1
	ALTERNATE 2
	ALTERNATE 3

X KEYED NOTES

- 1 DEMO EXISTING WALL
- 2 DEMO EXISTING DOOR
- 3 DEMO EXISTING TOILET PARTITIONS
- 4 DEMO EXISTING PLUMBING FIXTURES
- 5 DEMO EXISTING RAILING
- 6 INFILL EXISTING WINDOWS/OPENINGS AS DETAILED
- 7 DEMO EXISTING FLOORING
- 8 DEMO EXISTING METAL STAIRS
- 9 EXISTING GYM FLOOR TO REMAIN - PROTECT
- 10 DEMO EXISTING COMPOSITE SLAB FLOOR AND STEEL STRUCTURE
- 11 REMOVE EXISTING WALL PADS
- 12 EXISTING RED BLEACHERS TO BE RELOCATED - PROTECT
- 13 EXISTING BLACK BLEACHERS TO BE REUSED - PROTECT
- 14 CLEAN, PREP & PAINT EXISTING WOOD BLEACHERS - ALT. 2

## ALTERNATES


- A. ALTERNATE NO. ONE - DESCRIPTION - SECTION 01 23 00  
JUNIOR HIGH GYM - PUBLIC RESTROOMS RENOVATION
- B. ALTERNATE NO. TWO - DESCRIPTION - SECTION 01 23 00  
JUNIOR HIGH GYM - RENOVATION OF ENTRY VESTIBULES AND CLASSROOM
- C. ALTERNATE NO. THREE - DESCRIPTION - SECTION 01 23 00  
JUNIOR HIGH GYM - ADD HVAC TO EXISTING WEIGHT ROOM
- D. ALTERNATE NO. FOUR - DESCRIPTION - SECTION 01 23 00  
JUNIOR HIGH GYM - CLEAN, PREP, & PAINT EXISTING WOOD BLEACHERS



**ISSUED FOR CONSTRUCTION**

**JACOB** **MARTIN**

TBPEFIRM # 2448	TBAEFIRM # BR 2261	TBPELSFIRM # 10194493
--------------------	-----------------------	--------------------------

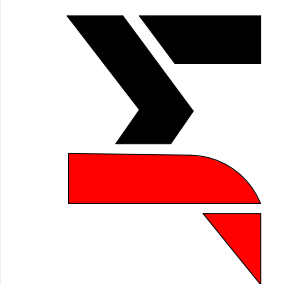

HAMILTON ISD  
ROCK GYM & JH GYM RENOVATIONS

# ENLARGED DEMO FLOOR PLAN - ROCK GYM

NO.	REVISION	DATE
	ADDENDUM 1	10/29/2025
PROJECT # SCALE		BAR IS ONE INCH IN LENGTH ON ORIGINAL DRAWING.
25327	As indicated	
CHECK SCALE AND ADJUST ACCORDINGLY.		

## A2.1





ISSUED FOR CONSTRUCTION

**JACOB  
MARTIN**

TBPELS FIRM  
# 10194493

TBAE FIRM  
# BR 2261

TBPE FIRM  
# 2448

HAMILTON ISD  
ROCK GYM & JH GYM RENOVATIONS




FLOOR PLAN - ROCK GYM

NO.		REVISION	DATE
1		ADDENDUM 1	10/29/2025
2			
3			
ROCK GYM ROOM FINISH SCHEDULE										
ROOM NO.	ROOM NAME	FLOORING		WALLS				CEILINGS		COMMENTS
		FLOOR FINISH	BASE FINISH	NORTH	EAST	SOUTH	WEST	FINISH	HEIGHT	
201	GYM	WD-01	WB-01	PT-01	PT-01	PT-01	PT-01	OTS/ PT-01	EXISTING	REPAINT EXISTING RED STRIPE (PT-02)

ROOM FINISH SCHEDULE LEGEND AND COMMENTARY - BASIS OF DESIGN (BOD)					
FLOORING	WALLS	CEILINGS	COMMENTARY		
LVT-01 LVT - MANNINGTON GROOVE	PT-01 SHERWIN WILLIAMS - SW6260 UNIQUE GRAY - SEMI	ACP-01 LAY-IN CEILING	1. STRUCTURE, DOORS & DOOR FRAMES - PT03 2. ALTERNATES		
WD-01 WOOD GYM FLOOR	PT-02 SHERWIN WILLIAMS - HEX COLOR #d4212c RED	ACP-05 LAY-IN CEILING WASHABLE			
SC-01 SEALED CONCRETE	PT-03 SHERWIN WILLIAMS - HEX COLOR #000000 BLACK	PT-04 SHERWIN WILLIAMS - SW6260 UNIQUE GRAY - FLAT			
RES-01 RESINOUS FLOOR	PT-05 SHERWIN WILLIAMS - SW6260 LAZY GRAY - FLAT	OTS OPEN TO STRUCTURE			
BASE	PT-01 FIBERGLASS REINFORCED PANEL				
RB-01 RUBBER BASE					
RSB-01 RESINOUS BASE					
WB-01 WOOD BASE - MATCH EXISTING					

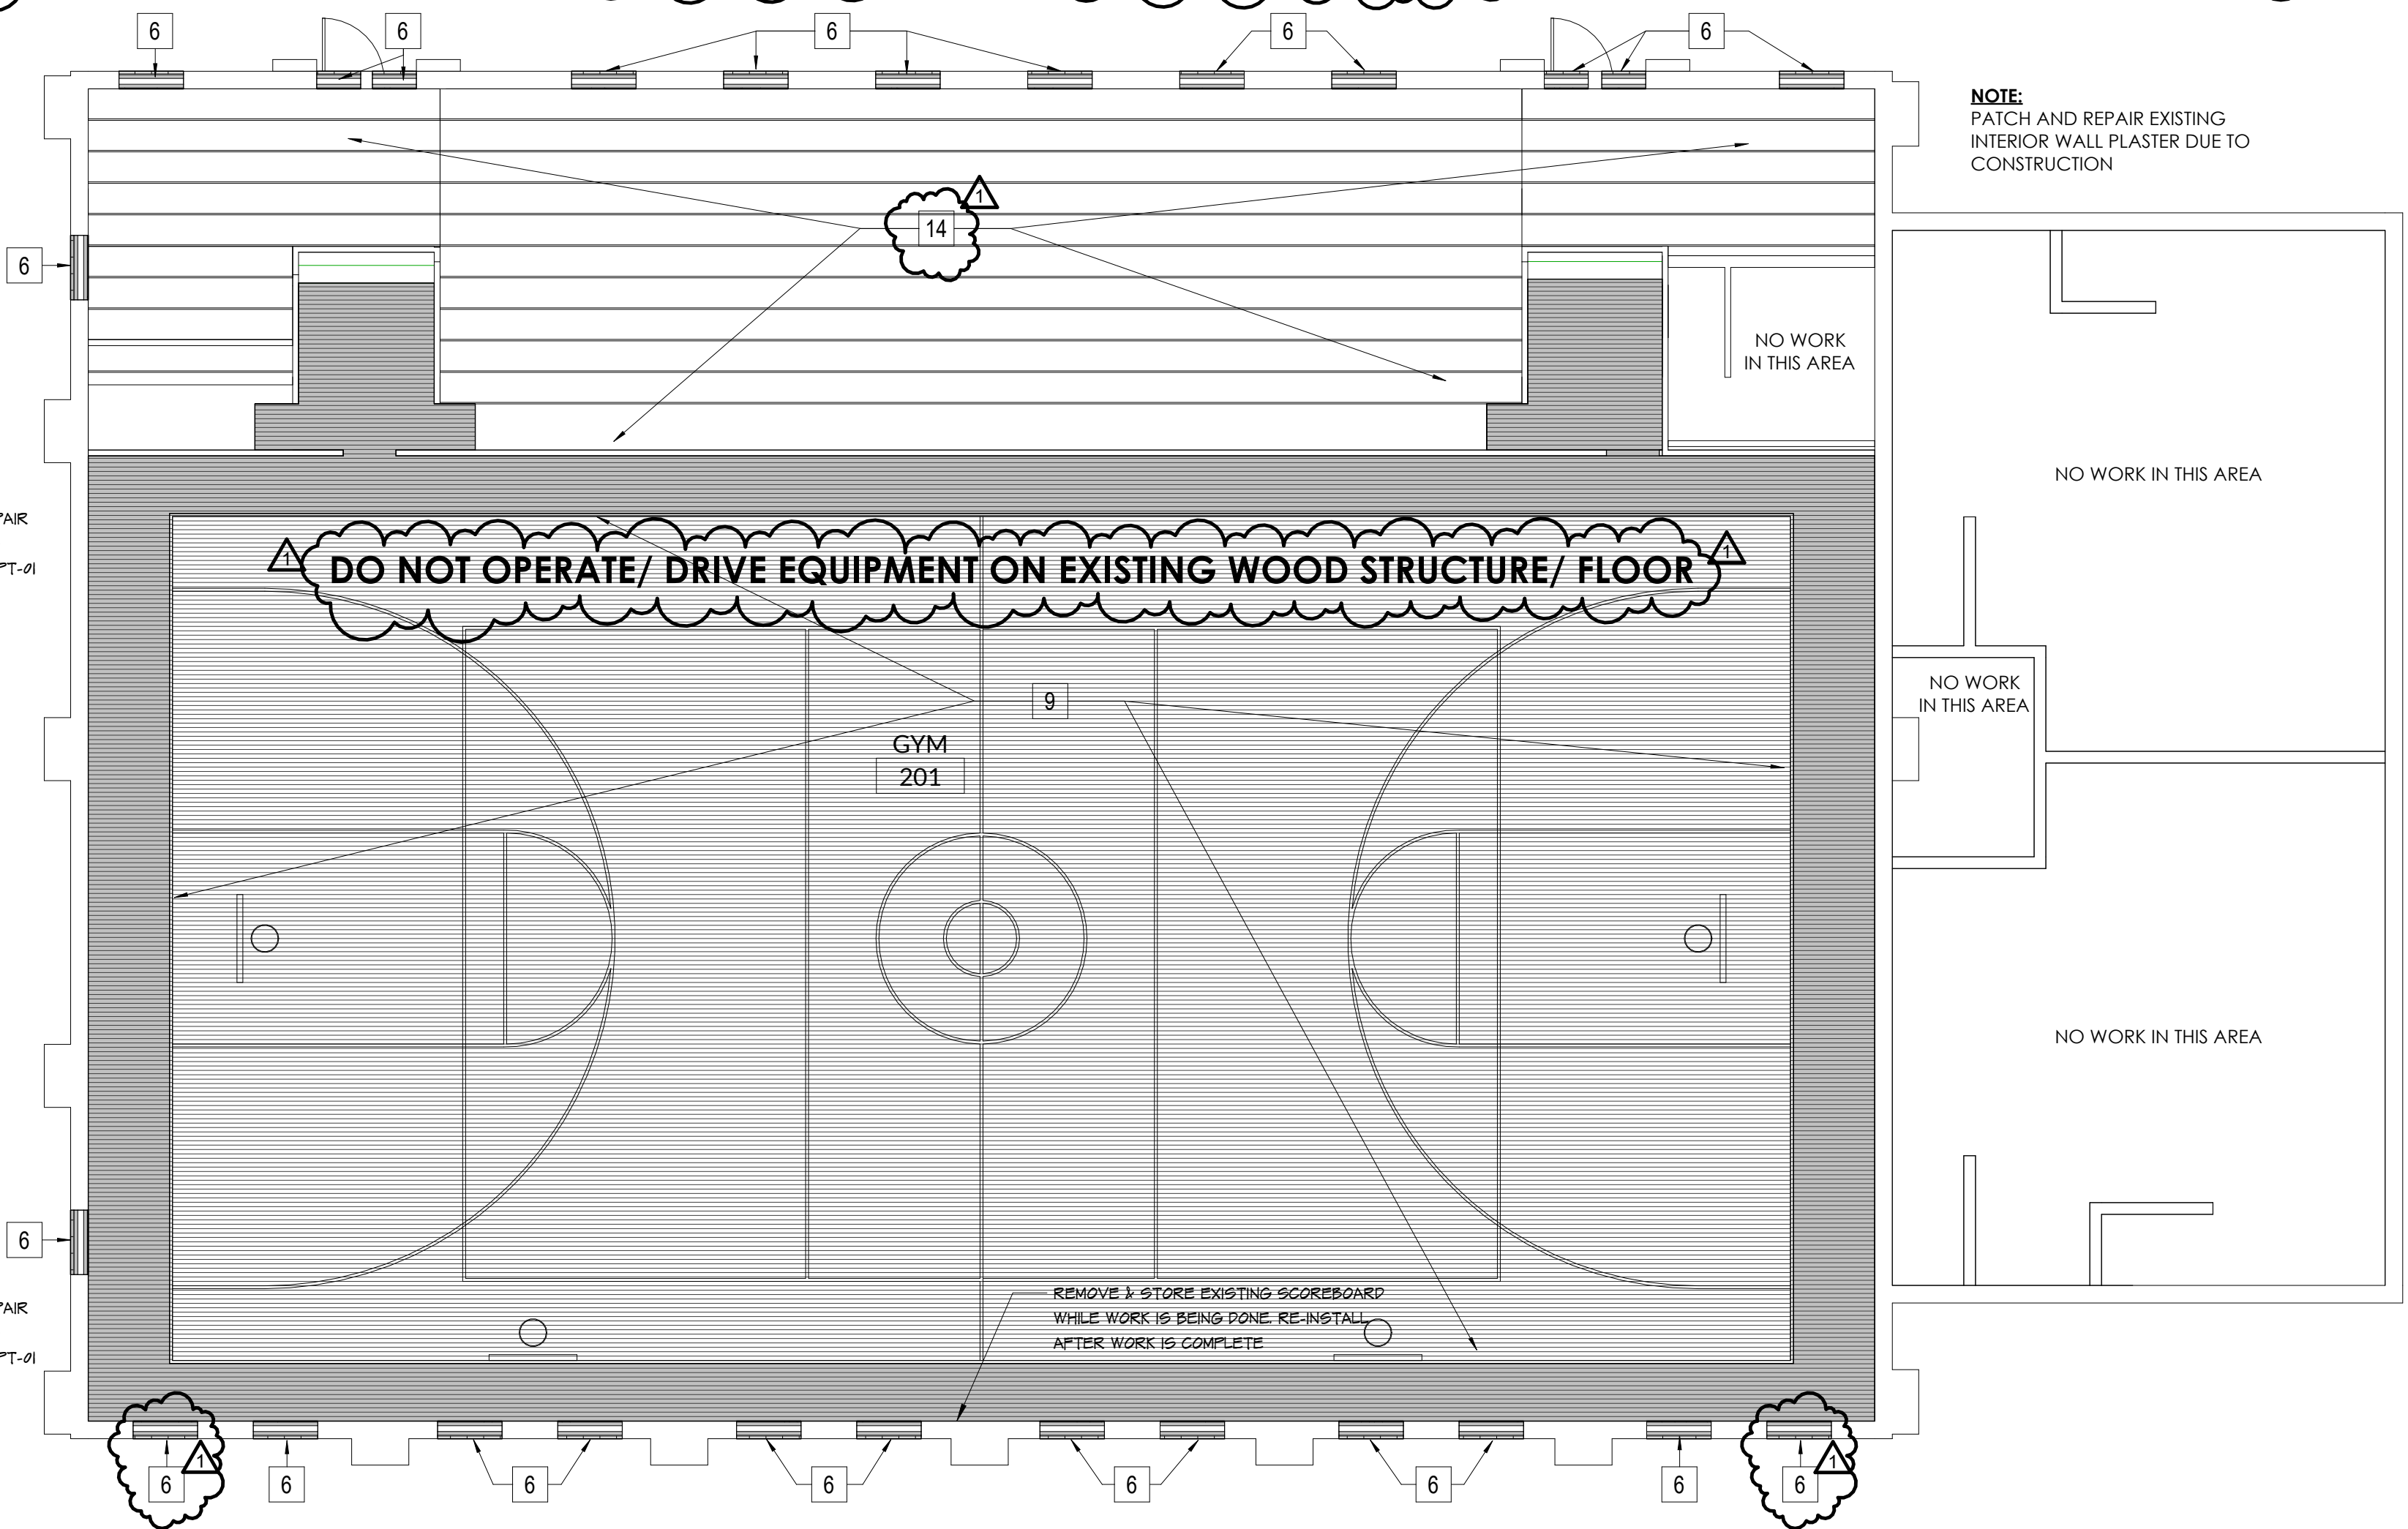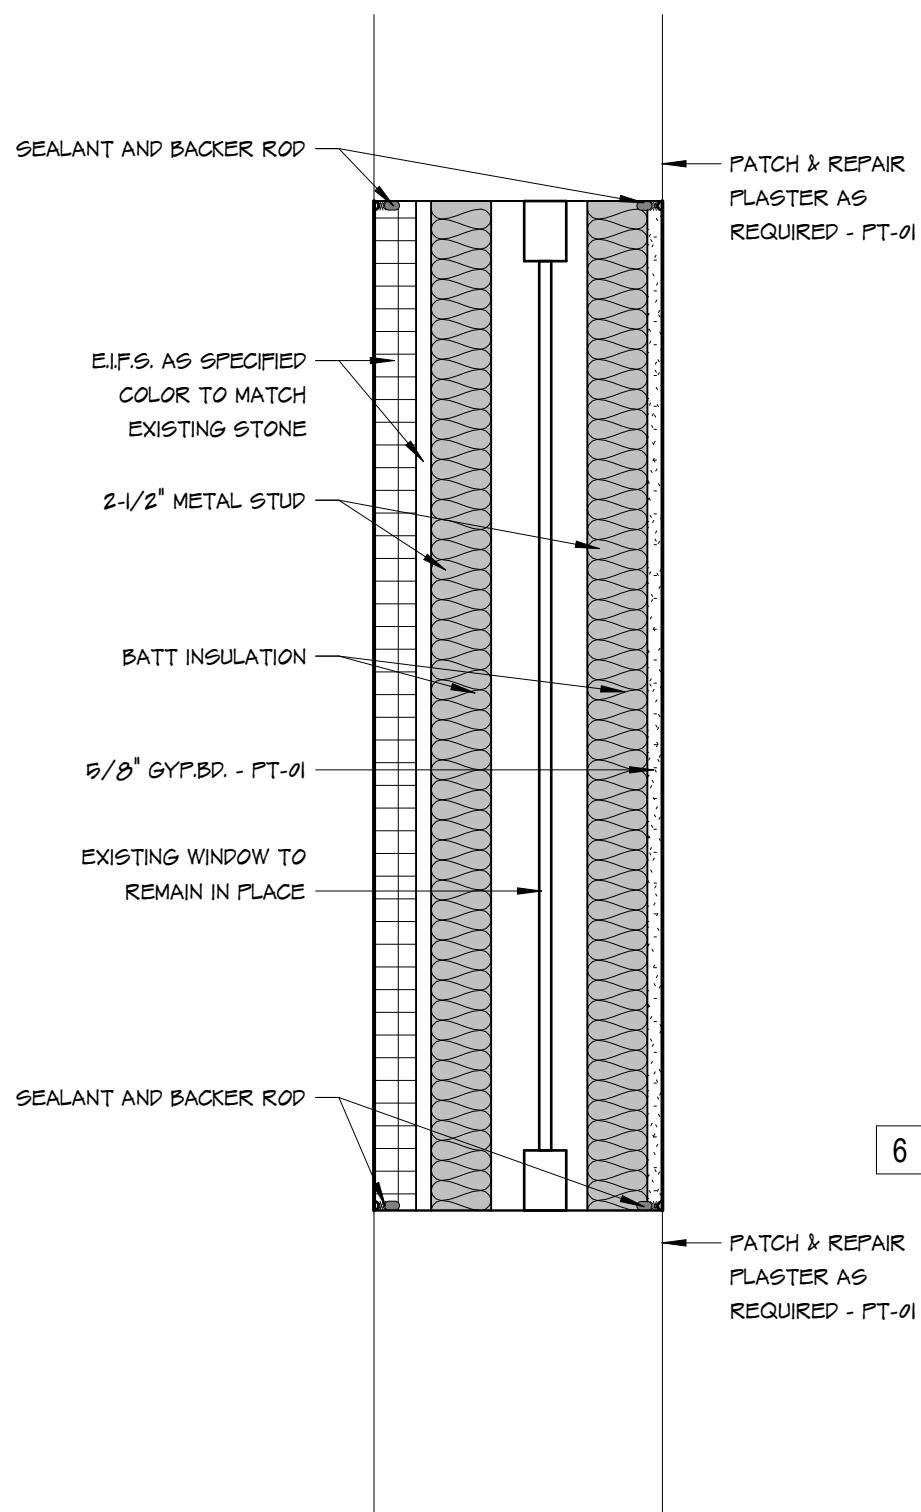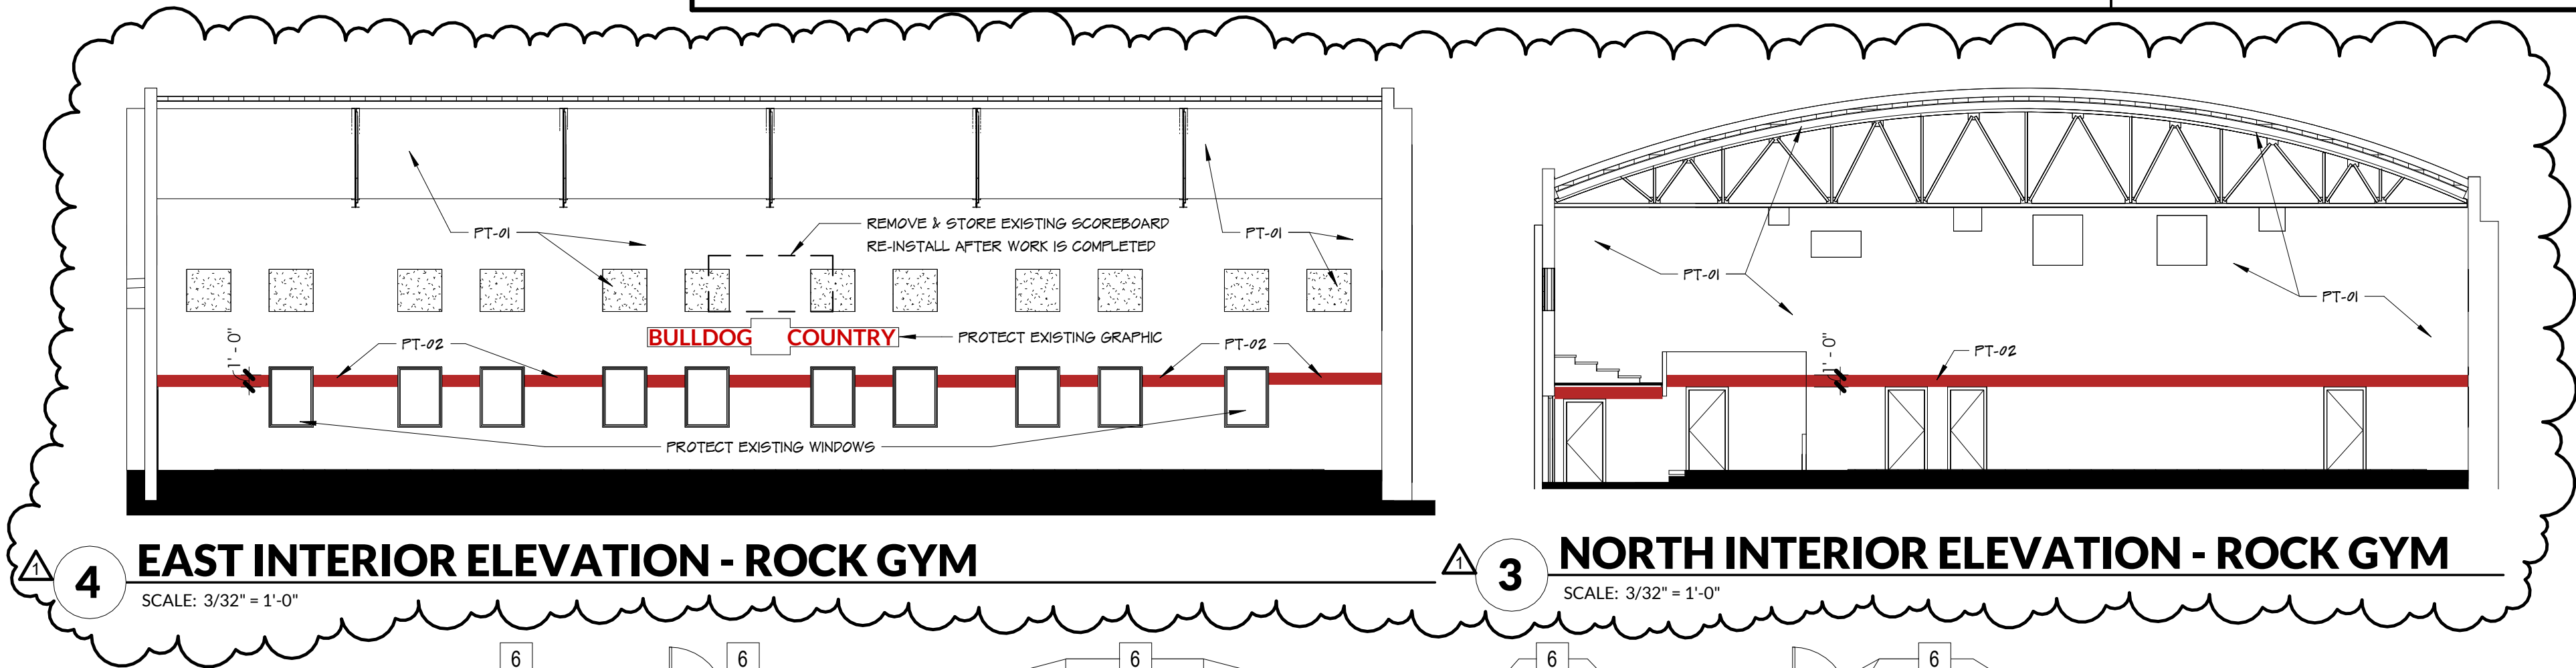

#### GENERAL NOTES

- THE FOLLOWING NOTES APPLY TO ALL PLAN SHEETS.
- CONTRACTOR SHALL VERIFY ALL DIMENSIONS AND REPORT ANY DISCREPANCY TO THE ARCHITECT FOR CORRECTION BEFORE PROCEEDING WITH CONSTRUCTION.
- ALL DIMENSIONS SHOWN ARE FROM FACE OF STUD OR FACE OF MASONRY.
- BLOCKING SHALL BE REQUIRED IN ALL STUD WALLS TO RECEIVE HANDRAILS, GRAB BARS, SHELVING, DOOR STOPS, AND ALL OTHER SIMILAR ITEMS REQUIRING A SECURE ANCHOR.
- THE GENERAL CONTRACTOR WILL BE REQUIRED TO COORDINATE ALL TRADES AS NECESSARY TO INSTALL ALL HANGING DEVICES FOR INSTALLATION OF ALL PIPING, MECHANICAL AND ELECTRICAL SYSTEMS.
- REFER TO REFLECTED CEILING PLAN FOR PARTITION HEIGHTS AND FIRE RATING REQUIREMENTS.
- REFER TO MEP SHEETS FOR ADDITIONAL REQUIREMENTS.

#### ENLARGED PLAN LEGEND

- NEW CMU WALL CONSTRUCTION
- NEW METAL STUD WALL CONSTRUCTION
- EXISTING WOOD FLOORING TO REMAIN - PROTECT
- NEW WOOD FLOORING - WD-01
- WINDOW TYPE - REFER TO A3 SHEETS
- KEYED NOTE - REFER THIS SHEET
- DOOR TAG DOOR NUMBER
- HARDWARE SET
- FIRE RATING
- ELEVATION - REFER A4 SHEETS
- SECTION - REFER A5 SHEETS
- FIRE EXTINGUISHER CABINET
- PARTITION TYPE - REFER TO SHEET A2.9
- NEW TOILET PARTITIONS, REFER TO SPECIFICATIONS SECTION 10165
- TOILET ACCESSORIES - REFER TO THIS SHEET
- ALTERNATE 1
- ALTERNATE 2
- ALTERNATE 3

#### KEYED NOTES

- DEMO EXISTING WALL
- DEMO EXISTING DOOR
- DEMO EXISTING TOILET PARTITIONS
- DEMO EXISTING PLUMBING FIXTURES
- DEMO EXISTING RAILING
- INFILL EXISTING WINDOWS/OPENINGS AS DETAILED
- DEMO EXISTING FLOORING
- DEMO EXISTING METAL STAIRS
- EXISTING GYM FLOOR TO REMAIN - PROTECT
- DEMO EXISTING COMPOSITE SLAB FLOOR AND STEEL STRUCTURE
- REMOVE EXISTING WALL PADS
- EXISTING RED BLEACHERS TO BE RELOCATED - PROTECT
- EXISTING BLACK BLEACHERS TO BE REUSED - PROTECT
- CLEAN, PREP & PAINT EXISTING WOOD BLEACHERS

#### ALTERNATES

- ALTERNATE NO. ONE - DESCRIPTION - SECTION 01 23 00 JUNIOR HIGH GYM - PUBLIC RESTROOMS RENOVATION
- ALTERNATE NO. TWO - DESCRIPTION - SECTION 01 23 00 JUNIOR HIGH GYM - RENOVATION OF ENTRY VESTIBULES AND CLASSROOM
- ALTERNATE NO. THREE - DESCRIPTION - SECTION 01 23 00 JUNIOR HIGH GYM - ADD HVAC TO EXISTING WEIGHT ROOM
- ALTERNATE NO. FOUR - DESCRIPTION - SECTION 01 23 00 ROCK GYM - CLEAN, PREP, & PAINT EXISTING WOOD BLEACHERS



ISSUED FOR CONSTRUCTION

JACOB MARTIN

TBPELS FIRM # 1019493  
TBPE FIRM # BR 2261  
TBPE FIRM # 2448


HAMILTON ISD  
ROCK GYM & JH GYM RENOVATIONS

UPPER LEVEL - ROCK GYM


NO.	REVISION	DATE	PROJECT #	SCALE	BAR IS ONE INCH IN LENGTH ON ORIGINAL DRAWING. CHECK SCALE AND ADJUST ACCORDINGLY.
25327	As indicated				
SEQ.	SHEET				

A2.5



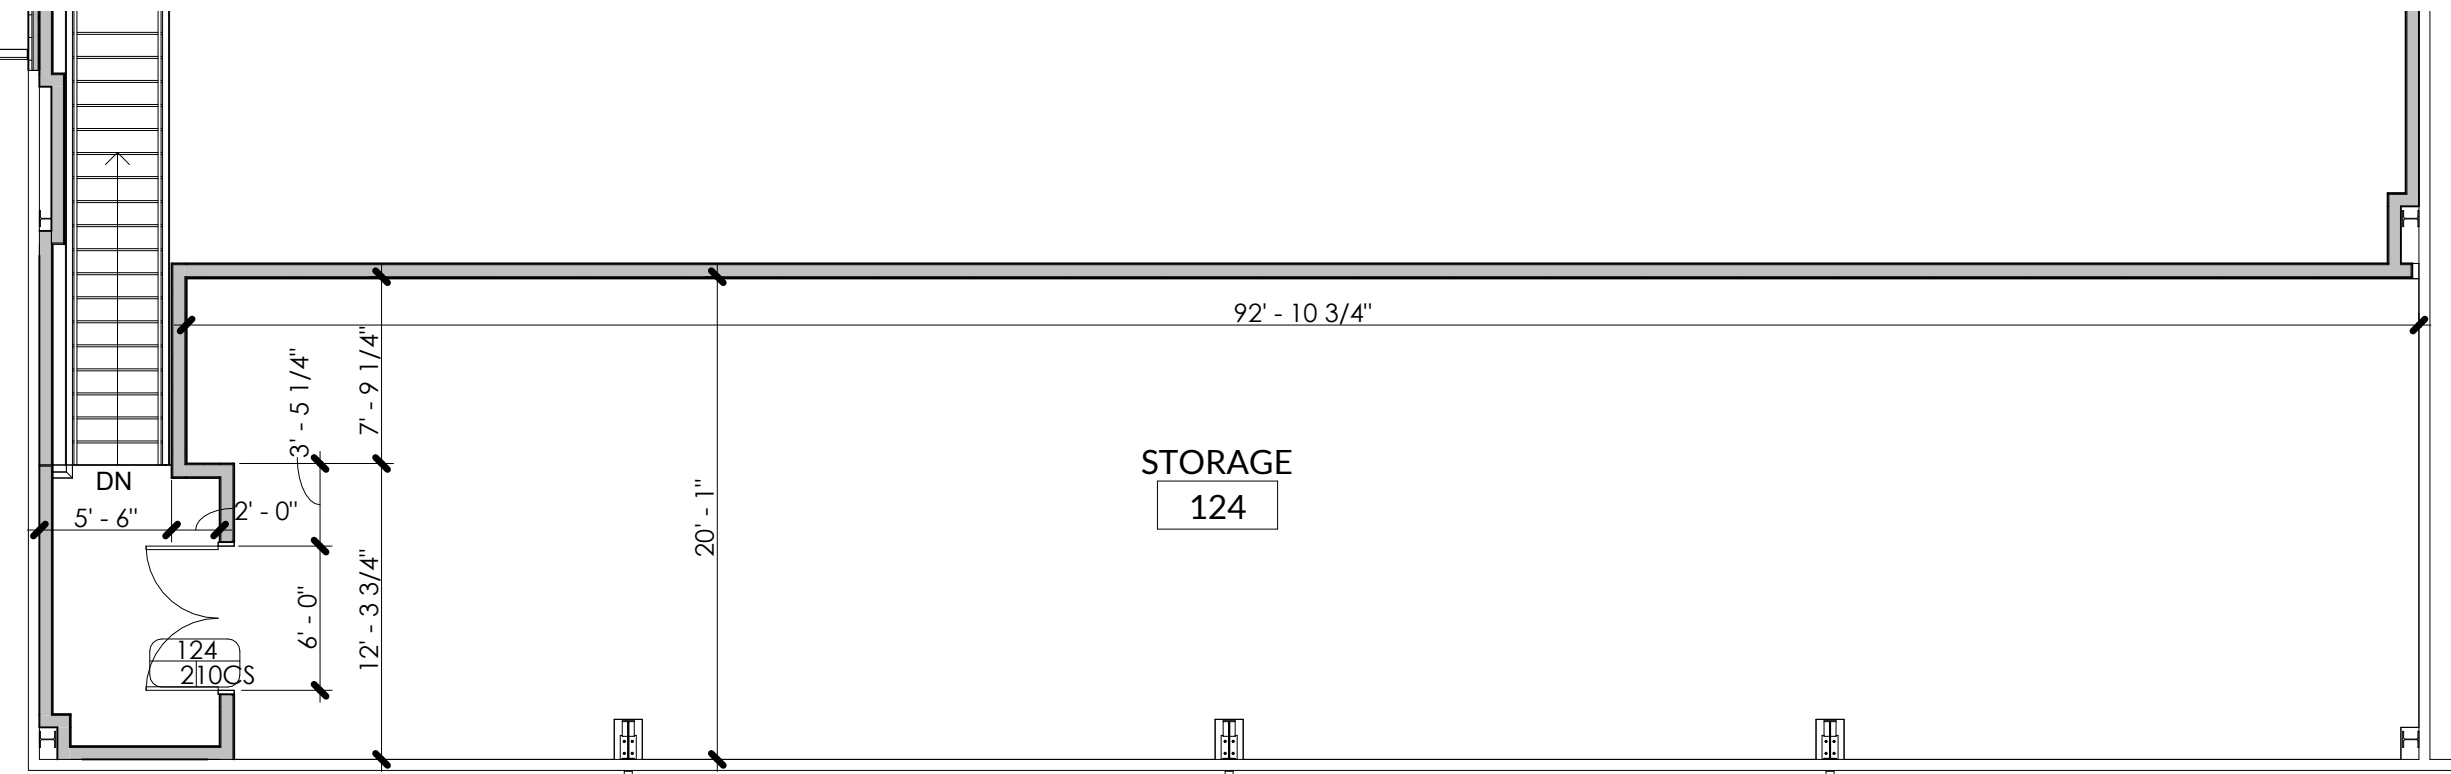

2 ENLARGED STORAGE PLATFORM  
SCALE: 1/8" = 1'-0"

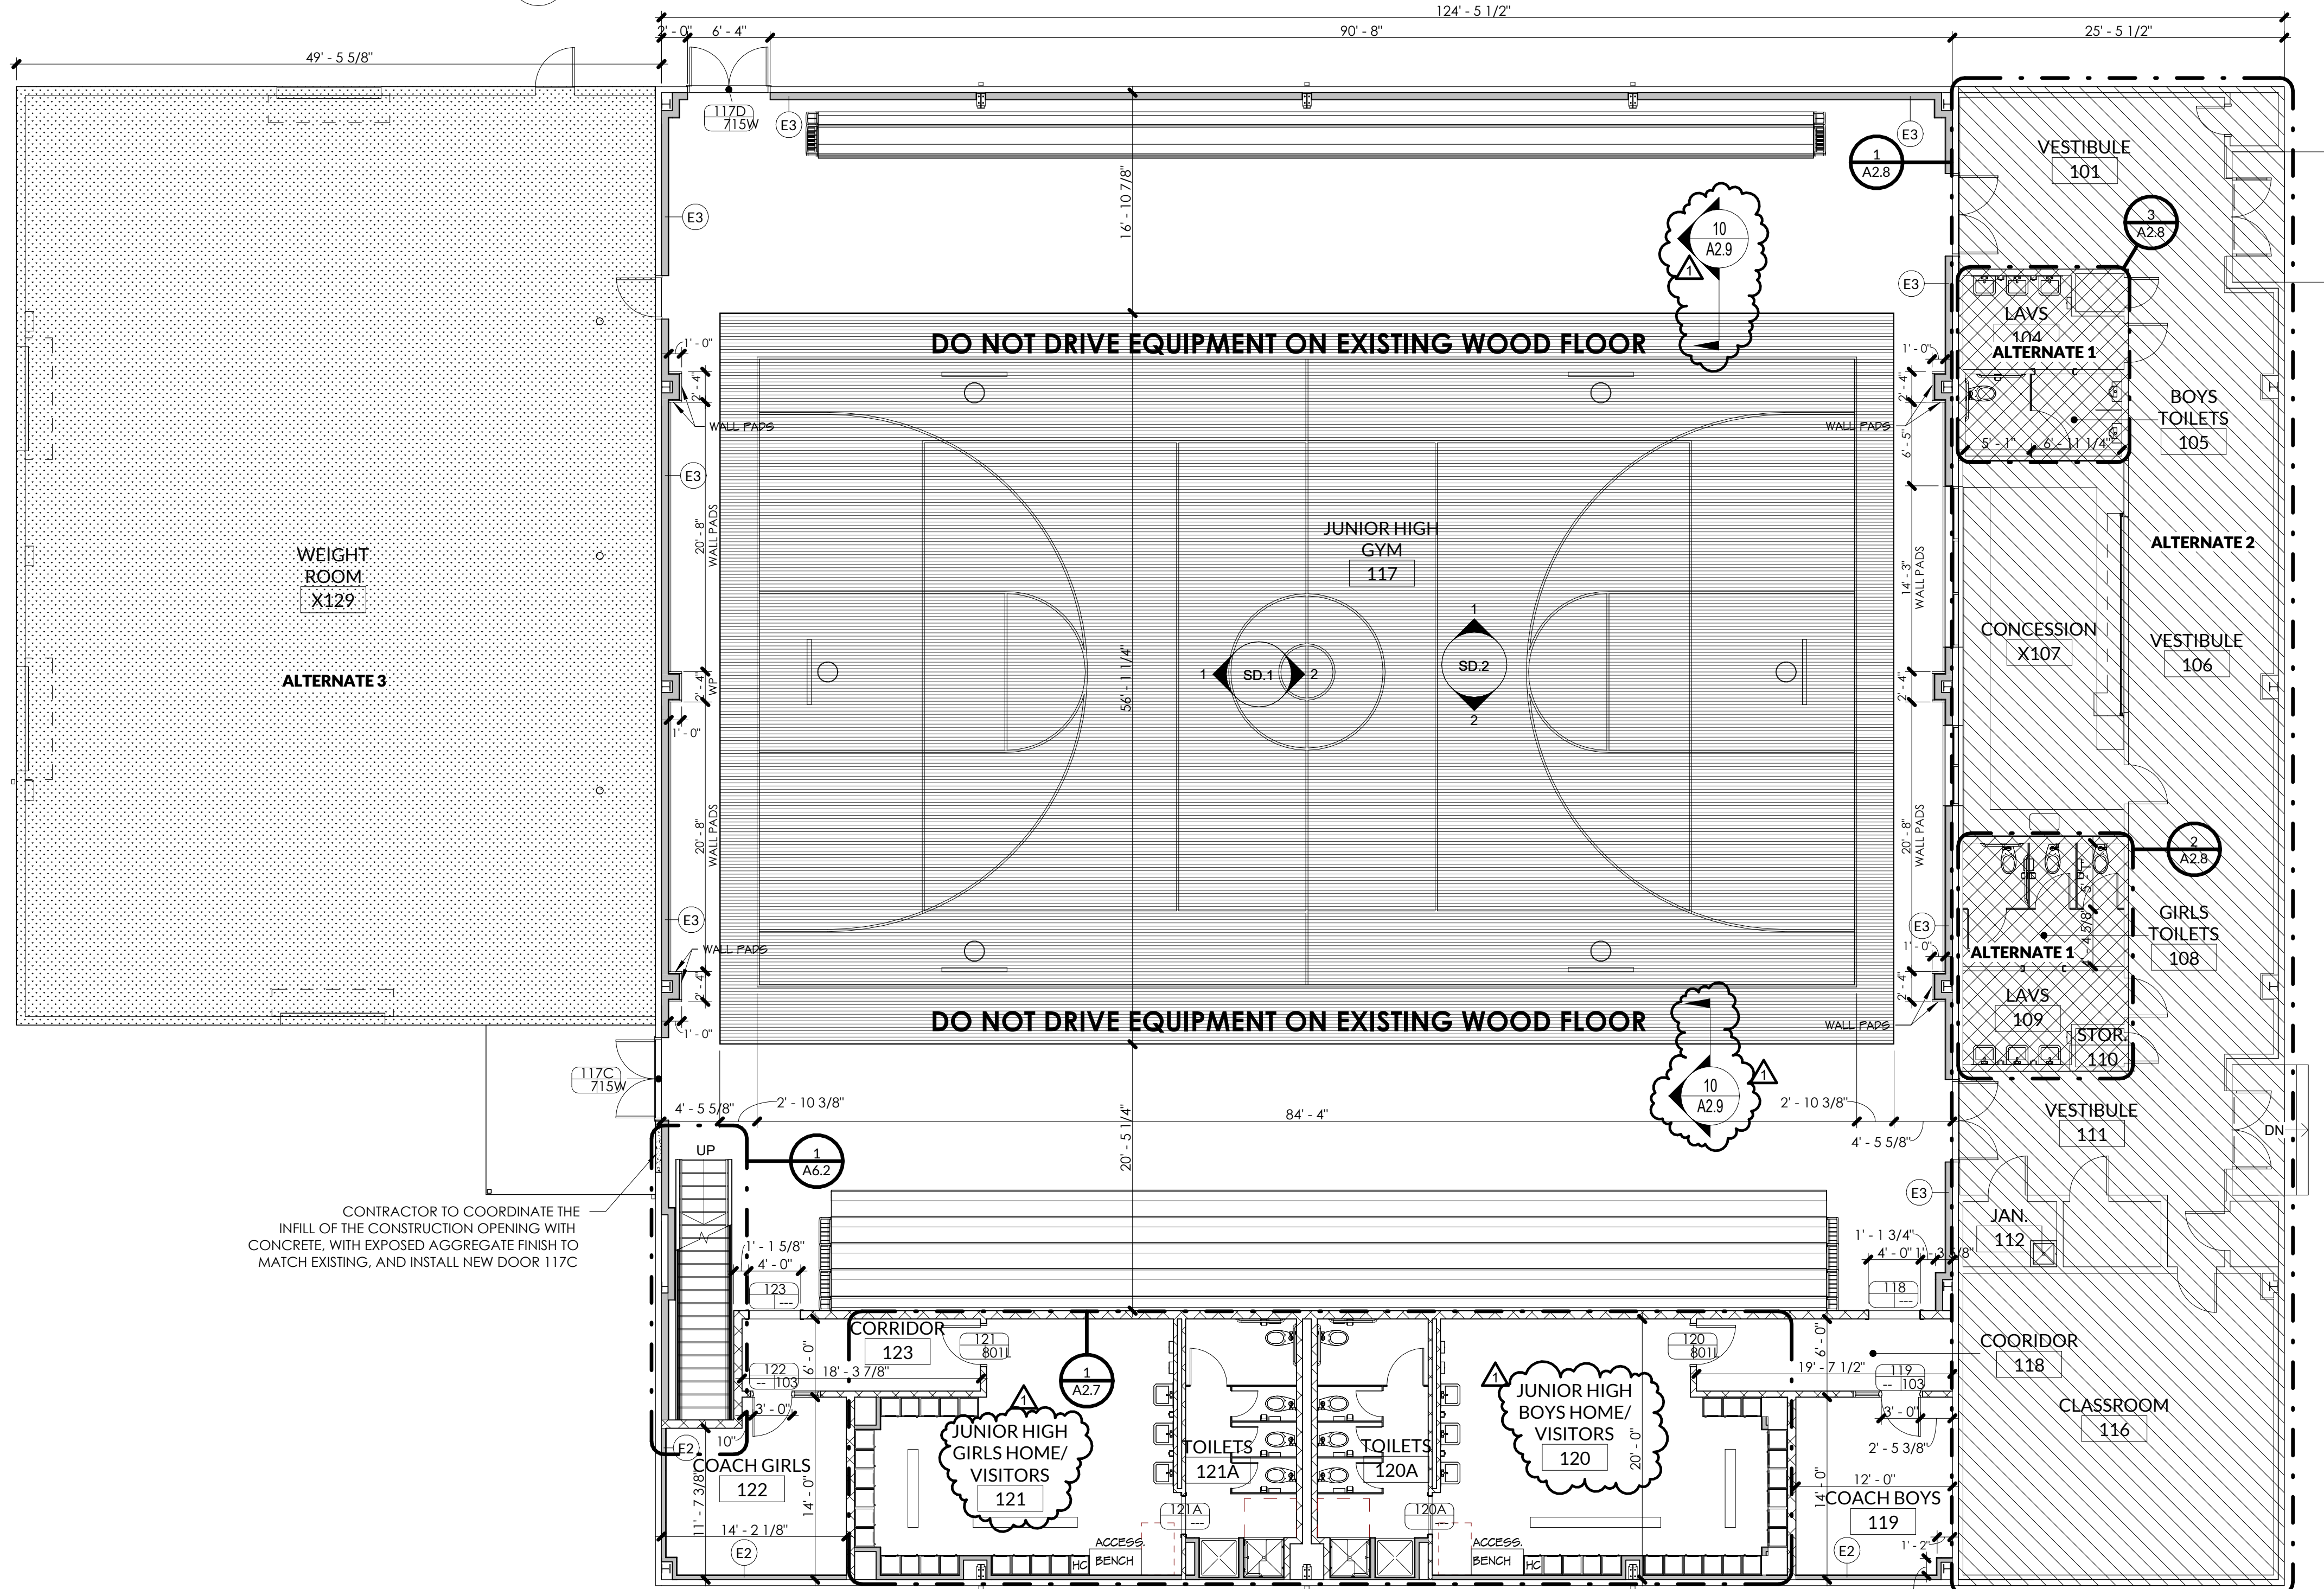

1 ENLARGED PLAN - JR HIGH GYM  
SCALE: 1/8" = 1'-0"

- GENERAL NOTES**
- A. THE FOLLOWING NOTES APPLY TO ALL PLAN SHEETS.
  - B. CONTRACTOR SHALL VERIFY ALL DIMENSIONS AND REPORT ANY DISCREPANCY TO THE ARCHITECT FOR CORRECTION BEFORE PROCEEDING WITH CONSTRUCTION.
  - C. ALL DIMENSIONS SHOWN ARE FROM FACE OF STUD OR FACE OF MASONRY.
  - D. BLOCKING SHALL BE REQUIRED IN ALL STUD WALLS TO RECEIVE HANDRAILS, GRAB BARS, SHELVING, DOOR STOPS, AND ALL OTHER SIMILAR ITEMS REQUIRING A SECURE ANCHOR.
  - E. THE GENERAL CONTRACTOR WILL BE REQUIRED TO COORDINATE ALL TRADES AS NECESSARY TO INSTALL ALL HANGING DEVICES FOR INSTALLATION OF ALL PIPING, MECHANICAL AND ELECTRICAL SYSTEMS.
  - F. REFER TO REFLECTED CEILING PLAN FOR PARTITION HEIGHTS AND FIRE RATING REQUIREMENTS.
  - G. REFER TO MEP SHEETS FOR ADDITIONAL REQUIREMENTS.

**ENLARGED PLAN LEGEND**

	NEW CMU WALL CONSTRUCTION
	NEW METAL STUD WALL CONSTRUCTION
	EXISTING WOOD FLOORING TO REMAIN - PROTECT
	NEW WOOD FLOORING - WD-01
	WINDOW TYPE - REFER TO A3 SHEETS
	KEYED NOTE - REFER THIS SHEET
	DOOR TAG DOOR NUMBER
	HARDWARE SET
	FIRE RATING
	ELEVATION - REFER A4 SHEETS
	SECTION - REFER A5 SHEETS
	FIRE EXTINGUISHER CABINET
	PARTITION TYPE - REFER TO SHEET A2.9
	NEW TOILET PARTITIONS, REFER TO SPECIFICATIONS SECTION 10165
	TOILET ACCESSORIES - REFER TO THIS SHEET
	ALTERNATE 1
	ALTERNATE 2
	ALTERNATE 3

**KEYED NOTES**

**TOILET ACCESSORIES**

1	TAS GRAB BARS 36" 42"
2	TOILET PAPER DISPENSER
3	SANITARY NAPKIN DISPOSAL UNIT, VERIFY LOCATION WITH ARCHITECT PRIOR TO INSTALLATION
4	PAPER TOWEL DISPENSER, VERIFY LOCATION WITH ARCHITECT PRIOR TO INSTALLATION
5	MIRROR, 24" W x 36" H
6	SOAP DISPENSER, VERIFY LOCATION WITH ARCHITECT WITH ARCHITECT PRIOR TO INSTALLATION
7	ADA COMPLIANT SHOWER

**ALTERNATES**

A. ALTERNATE NO. ONE - DESCRIPTION - SECTION 01 23 00  
JUNIOR HIGH GYM - PUBLIC RESTROOMS RENOVATION

B. ALTERNATE NO. TWO - DESCRIPTION - SECTION 01 23 00  
JUNIOR HIGH GYM - RENOVATION OF ENTRY VESTIBULES AND CLASSROOM

C. ALTERNATE NO. THREE - DESCRIPTION - SECTION 01 23 00  
JUNIOR HIGH GYM - ADD HVAC TO EXISTING WEIGHT ROOM

D. ALTERNATE NO. FOUR - DESCRIPTION - SECTION 01 23 00  
ROCK GYM - CLEAN, PREP, & PAINT EXISTING WOOD BLEACHERS

JACOB MARTIN  
REGISTERED ARCHITECT  
TIMOTHY W. HOPKINS  
23562  
STATE OF TEXAS  
10/29/2025

ISSUED FOR CONSTRUCTION

TBPELS FIRM # 10194493  
TBPE FIRM # BR 2261  
TBPE FIRM # 2448

HAMILTON ISD

ROCK GYM & JH GYM RENOVATIONS

ENLARGED FLOOR PLANS - JR HIGH GYM

NO.	REVISION	DATE	10/29/2025
1	ADDENDUM 1		
2			
3			



JH GYM ROOM FINISH SCHEDULE										
ROOM NO.	ROOM NAME	FLOORING		WALLS				CEILINGS		COMMENTS
		FLOOR FINISH	BASE FINISH	NORTH	EAST	SOUTH	WEST	FINISH	HEIGHT	
101	VESTIBULE	LVT-01	RB-01	PT-01	PT-01	PT-01	PT-01	ACP-02	MATCH EXIST	1,2
104	LAVS	LVT-01	RB-01	FRP-01	FRP-01	FRP-01	FRP-01	ACP-02	MATCH EXIST	1,2
105	BOYS TOILETS	LVT-01	RB-01	FRP-01	FRP-01	FRP-01	FRP-01	ACP-05	MATCH EXIST	1,2
106	VESTIBULE	LVT-01	RB-01	PT-01	PT-01	PT-01	PT-01	ACP-02	MATCH EXIST	1,2
108	GIRLS TOILETS	LVT-01	RB-01	FRP-01	FRP-01	FRP-01	FRP-01	ACP-05	MATCH EXIST	1,2
109	LAVS	LVT-01	RB-01	FRP-01	FRP-01	FRP-01	FRP-01	ACP-05	MATCH EXIST	1,2
110	STOR.	SC-01	RB-01	PT-01	PT-01	PT-01	PT-01	ACP-02	MATCH EXIST	1,2
111	VESTIBULE	LVT-01	RB-01	PT-01	PT-01	PT-01	PT-01	ACP-02	MATCH EXIST	1,2
112	JAN.	RES-01	RES-01	PT-01	PT-01	PT-01	PT-01	ACP-05	MATCH EXIST	1,2
116	CLASSROOM	LVT-01	RB-01	PT-01	PT-01	PT-01	PT-01	ACP-02	MATCH EXIST	1,2
117	JUNIOR HIGH GYM	LVT-01	RB-01	PT-01/ PT-02	PT-01/ PT-02	PT-01/ PT-02	PT-01/ PT-02	OTS/ PT-03	---	1, REFER TO A6 SHEETS - INTERIOR ELEVATIONS FOR LOCATIONS
118	COORIDOR	LVT-01	RB-01	PT-01	PT-01	PT-01	PT-01	OTS/ PT-03	---	1
119	COACH BOYS	LVT-01	RB-01	PT-01	PT-01	PT-01	PT-01	OTS/ PT-03	---	1
120	JUNIOR HIGH BOYS HOME/ VISITORS	RES-01	RES-01	PT-01	PT-01	PT-01	PT-01	OTS/ PT-03	---	1
120A	TOILETS	RES-01	RES-01	FRP-01	FRP-01	FRP-01	FRP-01	ACP-05	9'-0"	1
121	JUNIOR HIGH GIRLS HOME/ VISITORS	RES-01	RES-01	PT-01	PT-01	PT-01	PT-01	OTS/ PT-03	---	1
121A	TOILETS	RES-01	RES-01	FRP-01	FRP-01	FRP-01	FRP-01	ACP-05	9'-0"	1
122	COACH GIRLS	LVT-01	RB-01	PT-01	PT-01	PT-01	PT-01	OTS/ PT-03	---	1
123	CORRIDOR	LVT-01	RB-01	PT-01	PT-01	PT-01	PT-01	OTS/ PT-03	---	1
124	STORAGE	SC-01	RB-01	PT-01	PT-01	PT-01	PT-01	OTS/ PT-03	---	1


ROOM FINISH SCHEDULE LEGEND AND COMMENTARY - BASIS OF DESIGN (BOD)				
FLOORING	WALLS	CEILING	COMMENTARY	
LVT-01 LVT - MANNINGTON GROOVE WD-01 WOOD GYM FLOOR SC-01 SEALED CONCRETE RES-01 RESINOUS FLOOR	PT-01 SHERWIN WILLIAMS - SW6260 UNIQUE GRAY - SEMI PT-02 SHERWIN WILLIAMS - HEX COLOR #d4212c RED PT-03 SHERWIN WILLIAMS - HEX COLOR #000000 BLACK PT-05 SHERWIN WILLIAMS - SW6254 LAY GRAY - FLAT FRP-01 FIBERGLASS REINFORCED PANEL	ACP-01 LAY-IN CEILING ACP-05 LAY-IN CEILING WASHABLE PT-04 SHERWIN WILLIAMS - SW6260 UNIQUE GRAY - FLAT OTS OPEN TO STRUCTURE	1. STRUCTURE, DOORS & DOOR FRAMES - PT03 2. ALTERNATES	
BASE				
RB-01 RUBBER BASE RSB-01 RESINOUS BASE WB-01 WOOD BASE - MATCH EXISTING				

ROOM FINISH LEGEND		
	LVT-01 LVT - MANNINGTON GROOVE (B.O.D.)	RES-01 RESINOUS FLOOR
	SC-01 SEALED CONCRETE	

3 ALTERNATE 1  
SCALE: 1/4" = 1'-0"

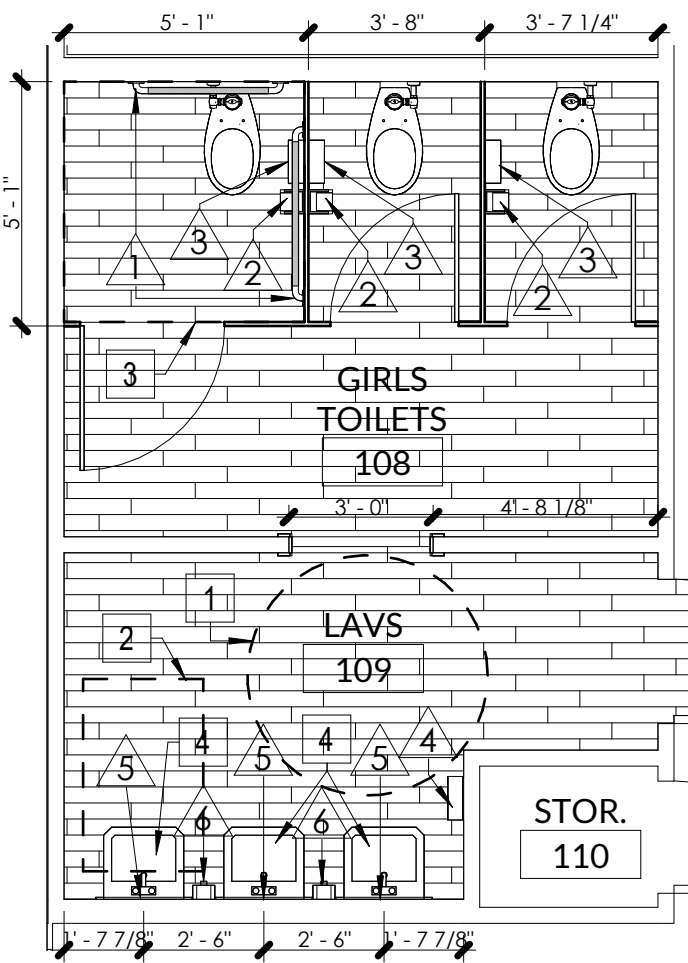

2 ALTERNATE 1  
SCALE: 1/4" = 1'-0"

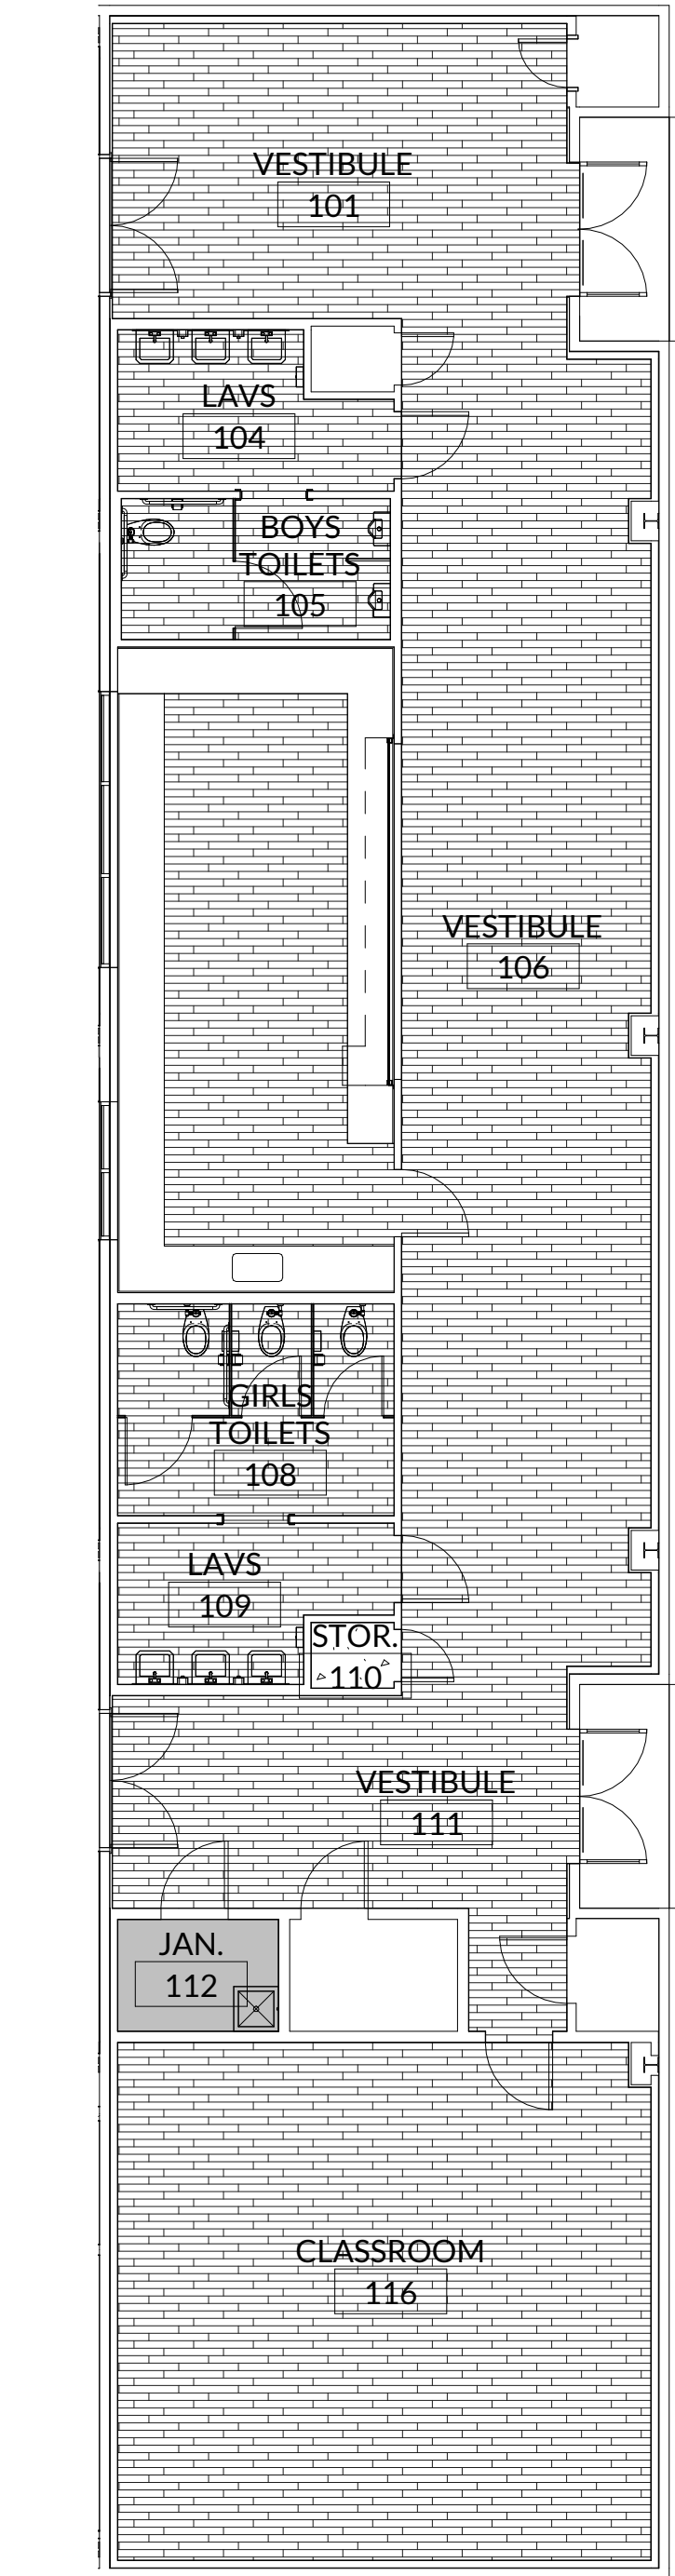

1 ALTERNATE 2  
SCALE: 1/8" = 1'-0"

INTERIOR ELEVATIONS GENERAL NOTES

A. ALL CABINET CONSTRUCTION TO BE PLASTIC LAMINATE CONSTRUCTION UNLESS NOTED OTHERWISE.

B. SEE PLAN FOR LOCATION AND QUANTITY OF ALL UNITS.

C. FIELD VERIFY ALL DIMENSIONS.

INTERIOR ELEVATIONS LEGEND

GRAPHIC SYMBOL INDICATES DIRECTION OF VIEW ON PLAN SHEET.

KEYED NOTES

1 TAS WHEELCHAIR T-TURNAROUND

2 TAS COMPLIANT CLEAR FLOOR SPACE REQUIRED AT FIXTURE, 30" x 48"

3 TAS COMPLIANT CLEAR FLOOR SPACE REQUIRED AT TOILET, 60" x 60"

4 WALL MOUNTED SINK

5 TAS COMPLIANT CLEAR FLOOR SPACE REQUIRED AT SHOWER, 36" x 48"

6 FREESTANDING BENCH

7 ACCESSIBLE BENCH

8 TAS COMPLIANT CLEAR FLOOR SPACE REQUIRED AT URINAL, 36" x 48"

TOILET ACCESSORIES

1 TAS GRAB BARS 36", 42"

2 TOILET PAPER DISPENSER

3 SANITARY NAPKIN DISPOSAL UNIT, VERIFY LOCATION WITH ARCHITECT PRIOR TO INSTALLATION

4 PAPER TOWEL DISPENSER, VERIFY LOCATION WITH ARCHITECT PRIOR TO INSTALLATION

5 MIRROR, 24" W x 36" H

6 SOAP DISPENSER, VERIFY LOCATION WITH ARCHITECT WITH ARCHITECT PRIOR TO INSTALLATION

7 ADA COMPLIANT SHOWER

ALTERNATES

A. ALTERNATE NO. ONE - DESCRIPTION - SECTION 01 23 00  
JUNIOR HIGH GYM - PUBLIC RESTROOMS RENOVATION

B. ALTERNATE NO. TWO - DESCRIPTION - SECTION 01 23 00  
JUNIOR HIGH GYM - RENOVATION OF ENTRY VESTIBULES AND CLASSROOM

C. ALTERNATE NO. THREE - DESCRIPTION - SECTION 01 23 00  
JUNIOR HIGH GYM - ADD HVAC TO EXISTING WEIGHT ROOM

D. ALTERNATE NO. FOUR - DESCRIPTION - SECTION 01 23 00  
ROCK GYM - CLEAN, PREP, & PAINT EXISTING WOOD BLEACHERS

ISSUED FOR CONSTRUCTION

JACOB MARTIN

TBPEL FIRM # 1019493

TBAE FIRM # BR 2261

TBPE FIRM # 2448

HAMILTON ISD

ROCK GYM & JH GYM RENOVATIONS

FINISH SCHEDULE & ALTERNATE ENLARGED FLOOR PLANS

NO.	REVISION	DATE	10/29/2025
1	ADDENDUM 1		
2			
3			
4			
5			
6			
7			

PROJECT # 25327







SCALE As indicated

BASIS ONE INCH IN LENGTH ON ORIGINAL DRAWING. CHECK SCALE AND ADJUST ACCORDINGLY.






SEQ. SHEET

A2.8

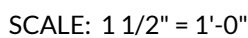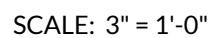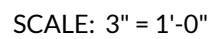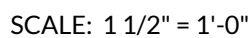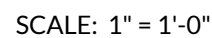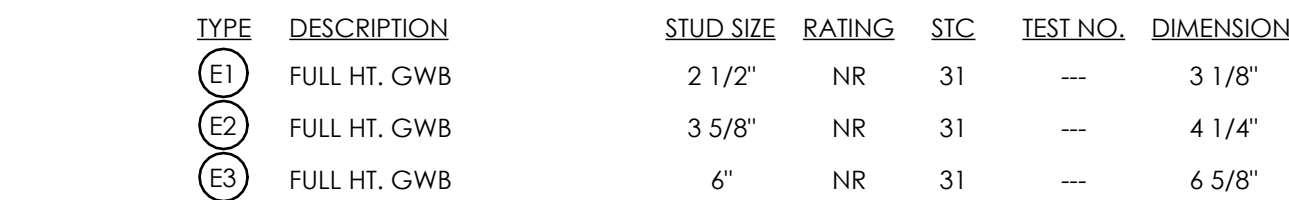

[illegible]


PARTITION RATING PRIORITIES LEGEND	
PARTITION RATING	PRIORITY
2 HOUR FIRE/SMOKE BARRIER	1 (HIGHEST)
2 HOUR FIRE WALL OR SHAFT WALL	2
1 HOUR FIRE/SMOKE BARRIER	3
1 HOUR FIRE WALL	4
NON-RATED WALL	5 (LOWEST)

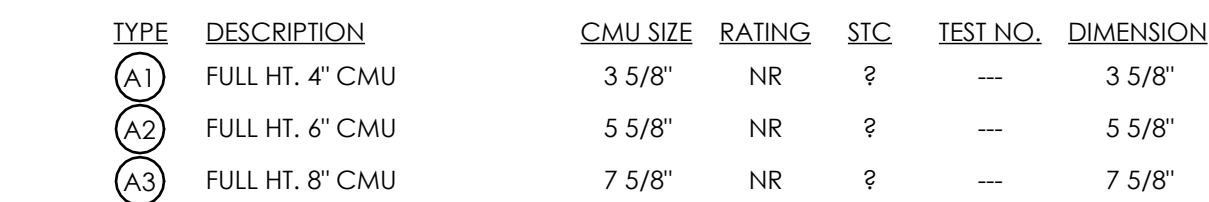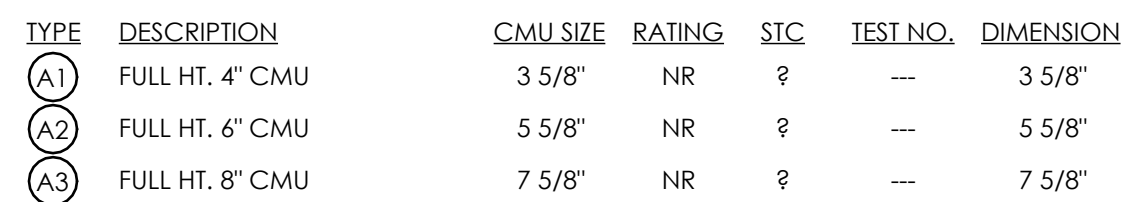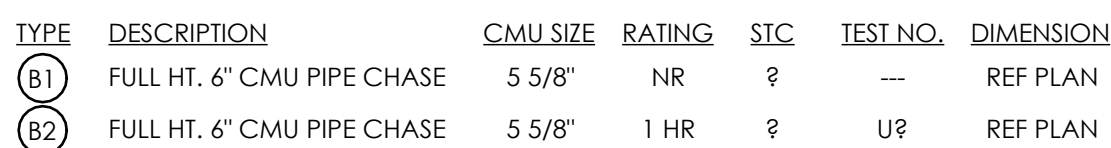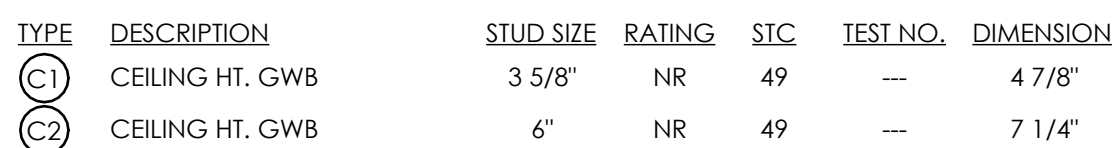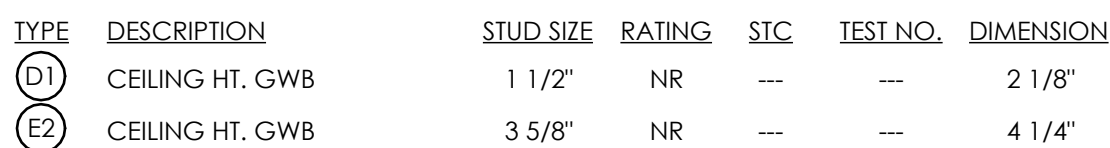



ISSUED FOR CONSTRUCTION

**JACOB  
MARTIN**

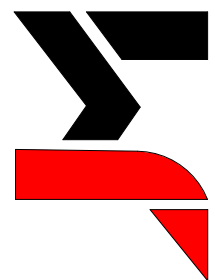

TBPE FIRM  
# 2448


TBAE FIRM  
# BR 2261

TBPELS FIRM  
# 10194493

HAMILTON ISD  
ROCK GYM & JH GYM RENOVATIONS


EXTERIOR ELEVATIONS - ROCK GYM

NO.		REVISION	DATE
1	1	ADDENDUM 1	10/29/2025
2	2		
3	3		
PROJECT #		SCALE	BAR IS ONE INCH IN LENGTH ON ORIGINAL DRAWING. CHECK SCALE AND ADJUST ACCORDINGLY.
25327		1/8" = 1'-0"	
SEQ.		SHEET	
A4.1			

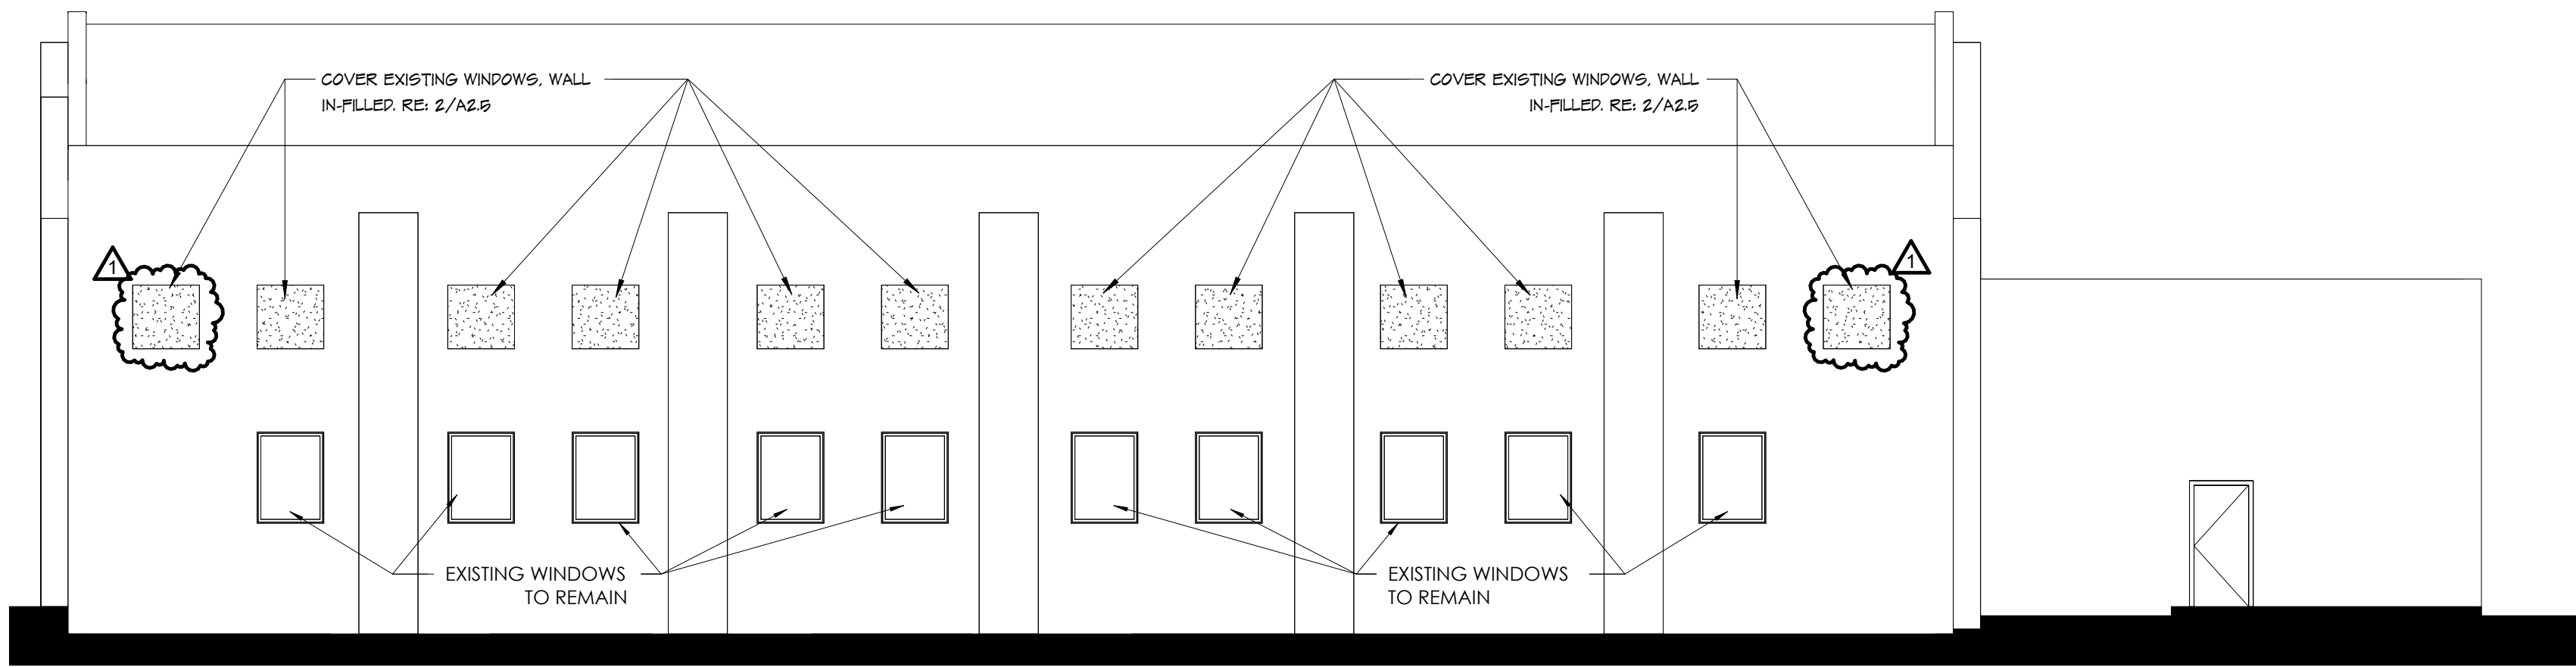

**2 WEST ELEVATION - ROCK GYM**

SCALE: 1/8" = 1'-0"

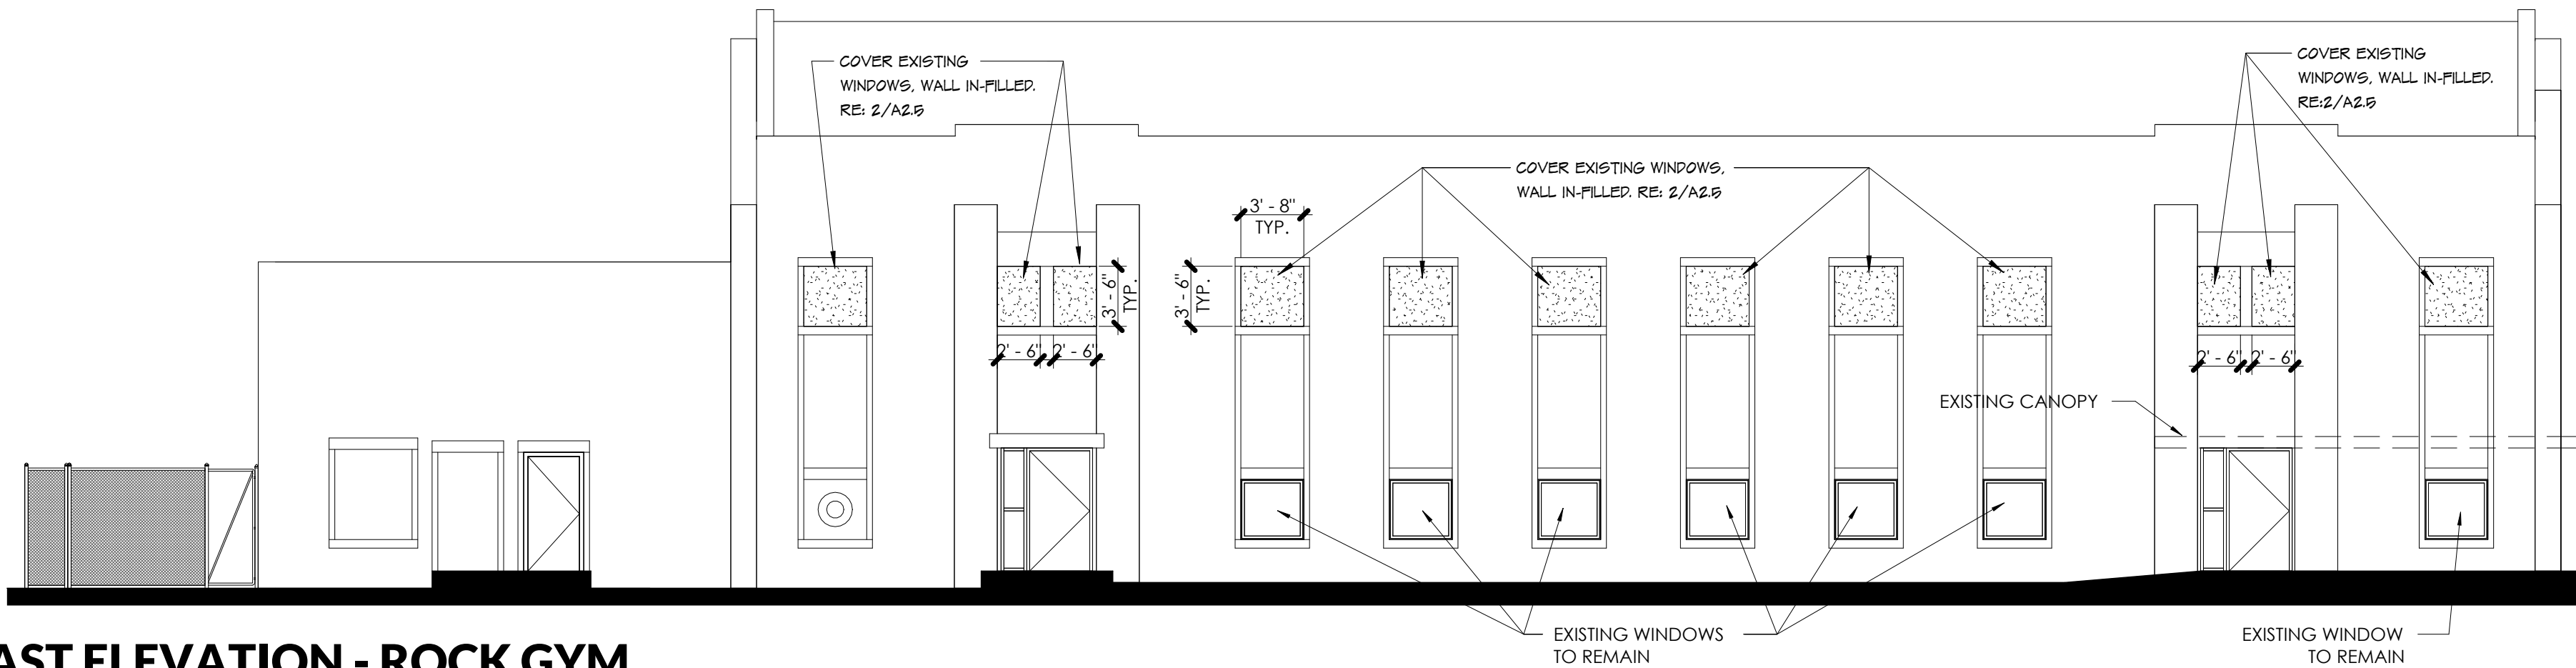


**1 EAST ELEVATION - ROCK GYM**

SCALE: 1/8" = 1'-0"







NO.	REVISION	DATE	BY	CHKD.	APP'D.
1	ADDENDUM 1	10/29/2025			
2					
3					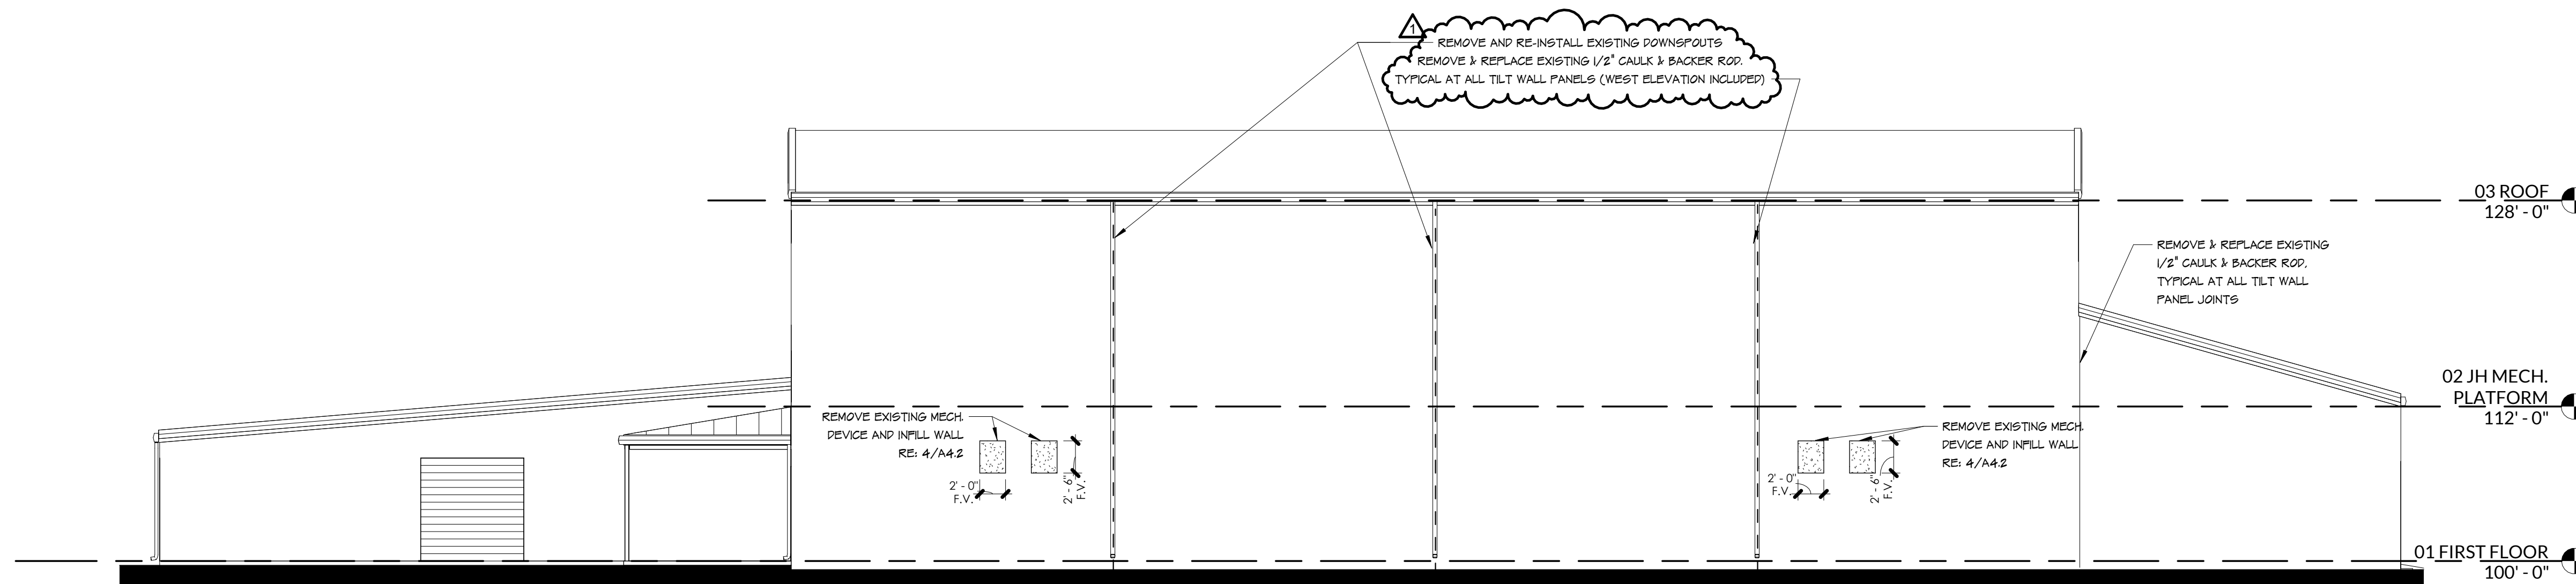
**3 EAST ELEVATION - JH GYM**

SCALE: 1/8" = 1'-0"

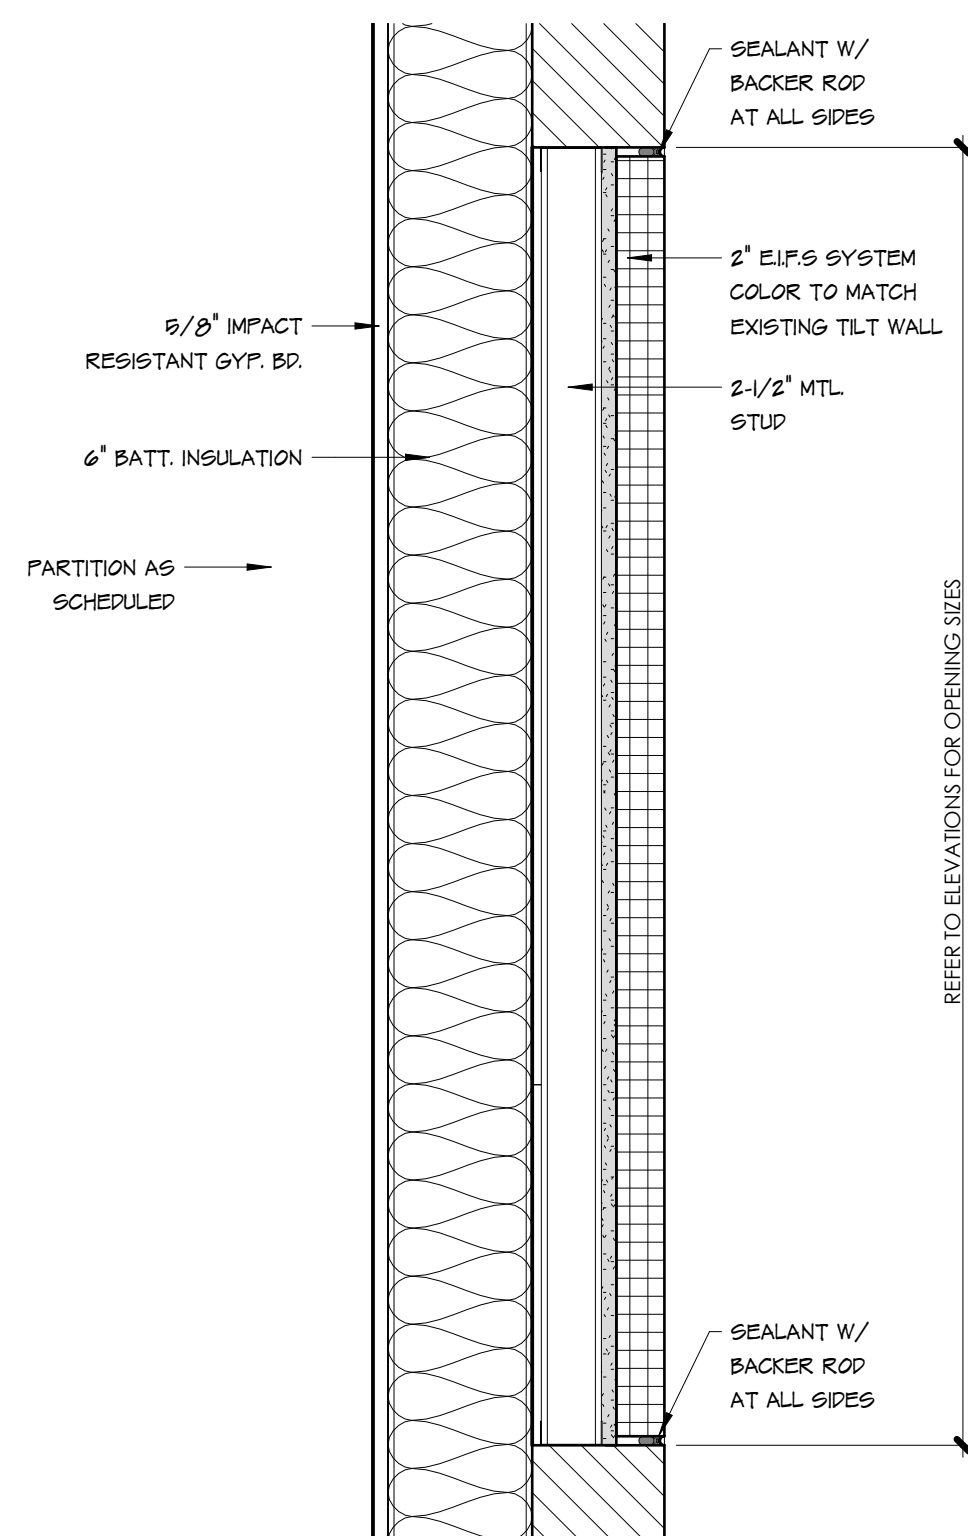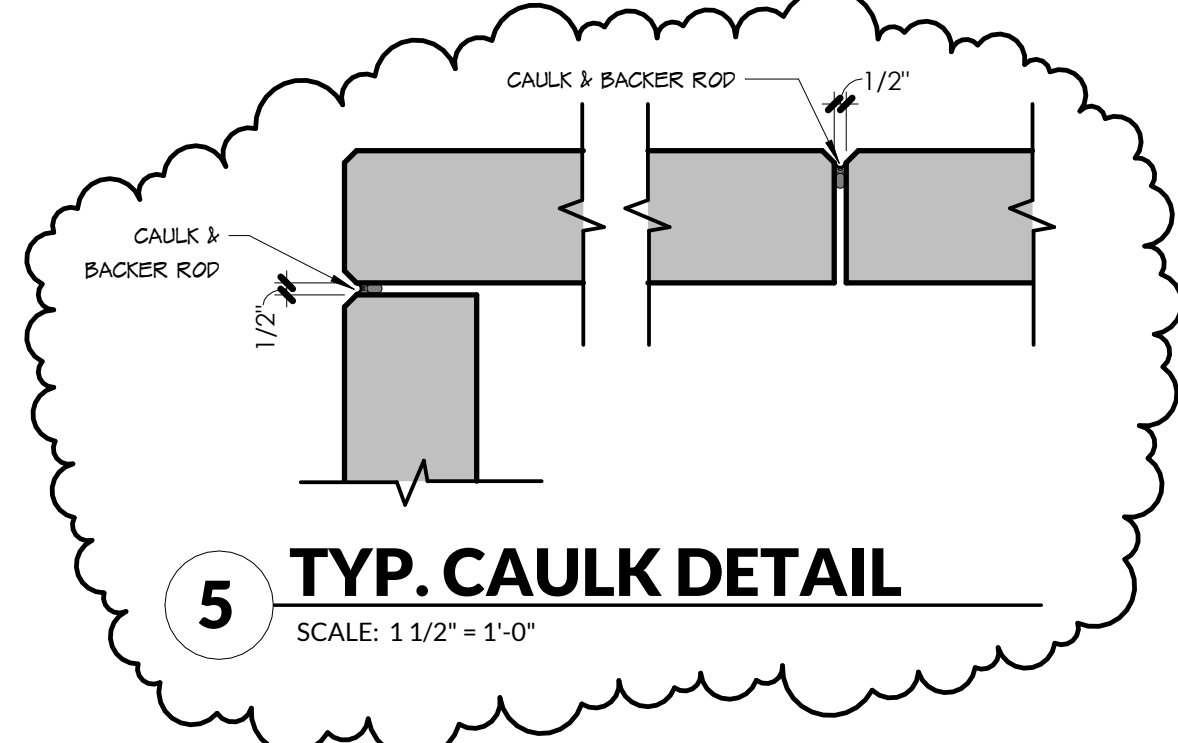


**4 DETAIL - WALL INFILL**

SCALE: 1 1/2" = 1'-0"

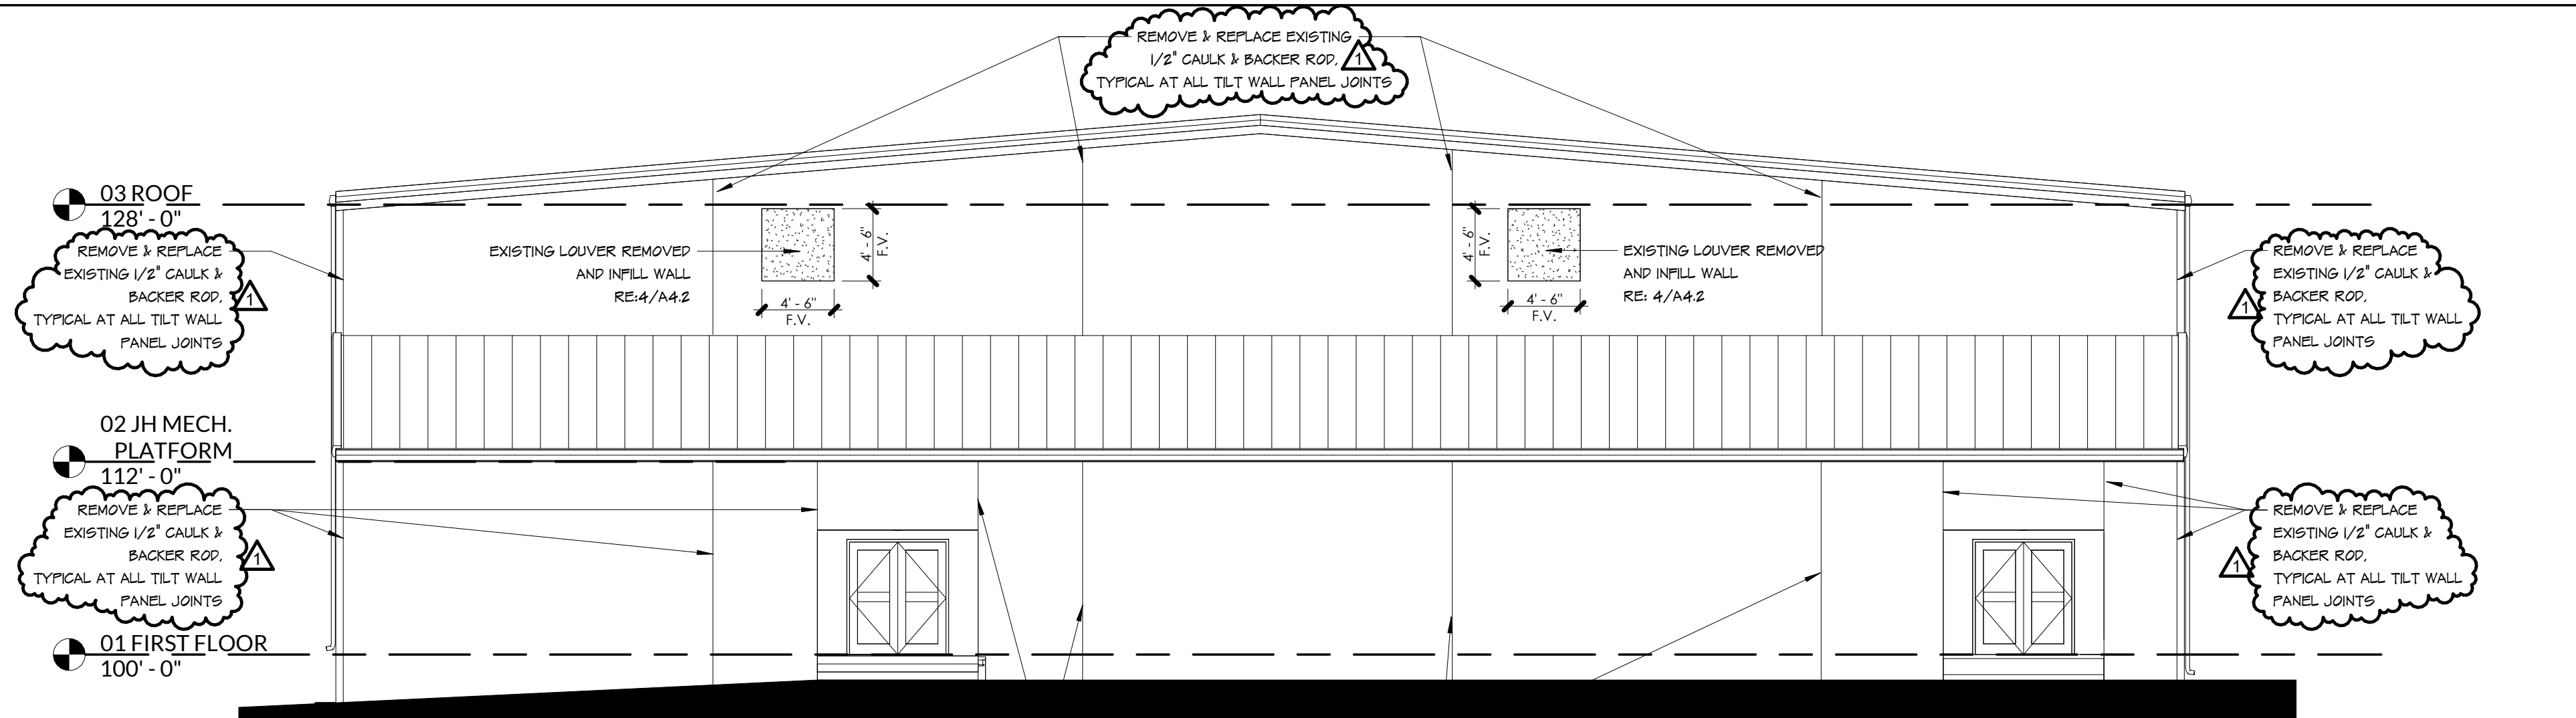


**2 NORTH ELEVATION - JH GYM**

SCALE: 1/8" = 1'-0"

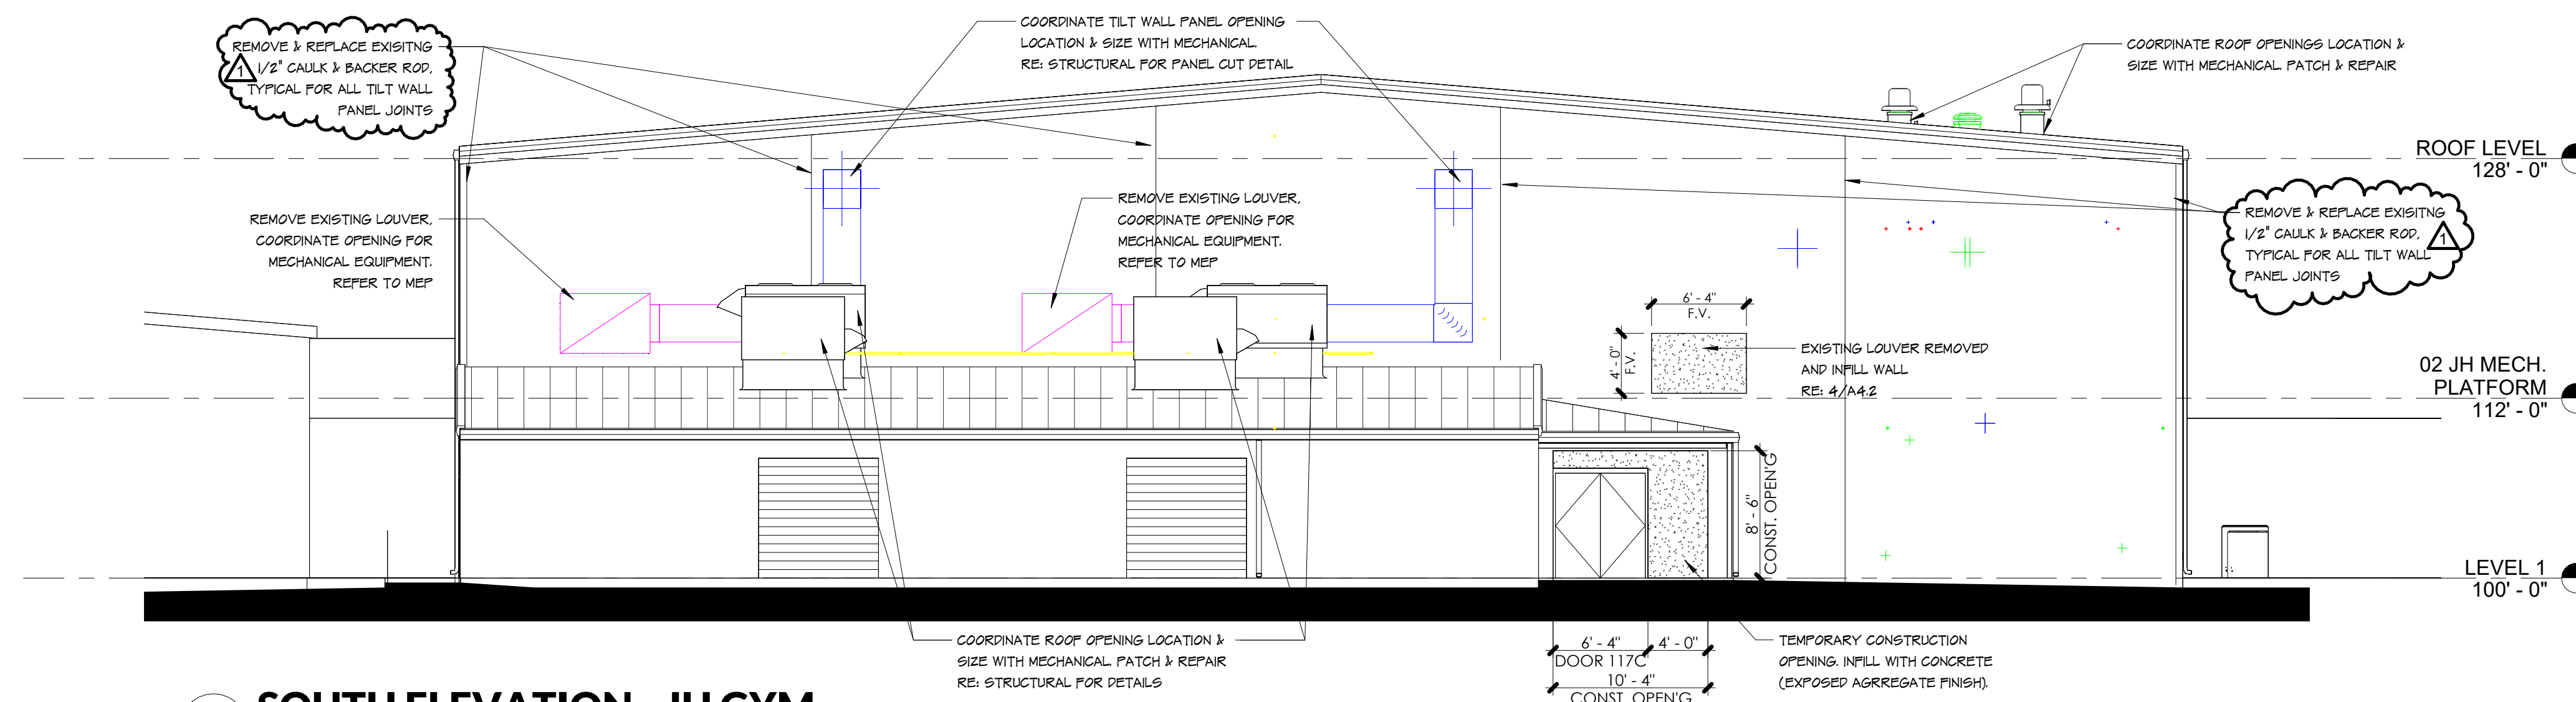


**1 SOUTH ELEVATION - JH GYM**

SCALE: 1/8" = 1'-0"

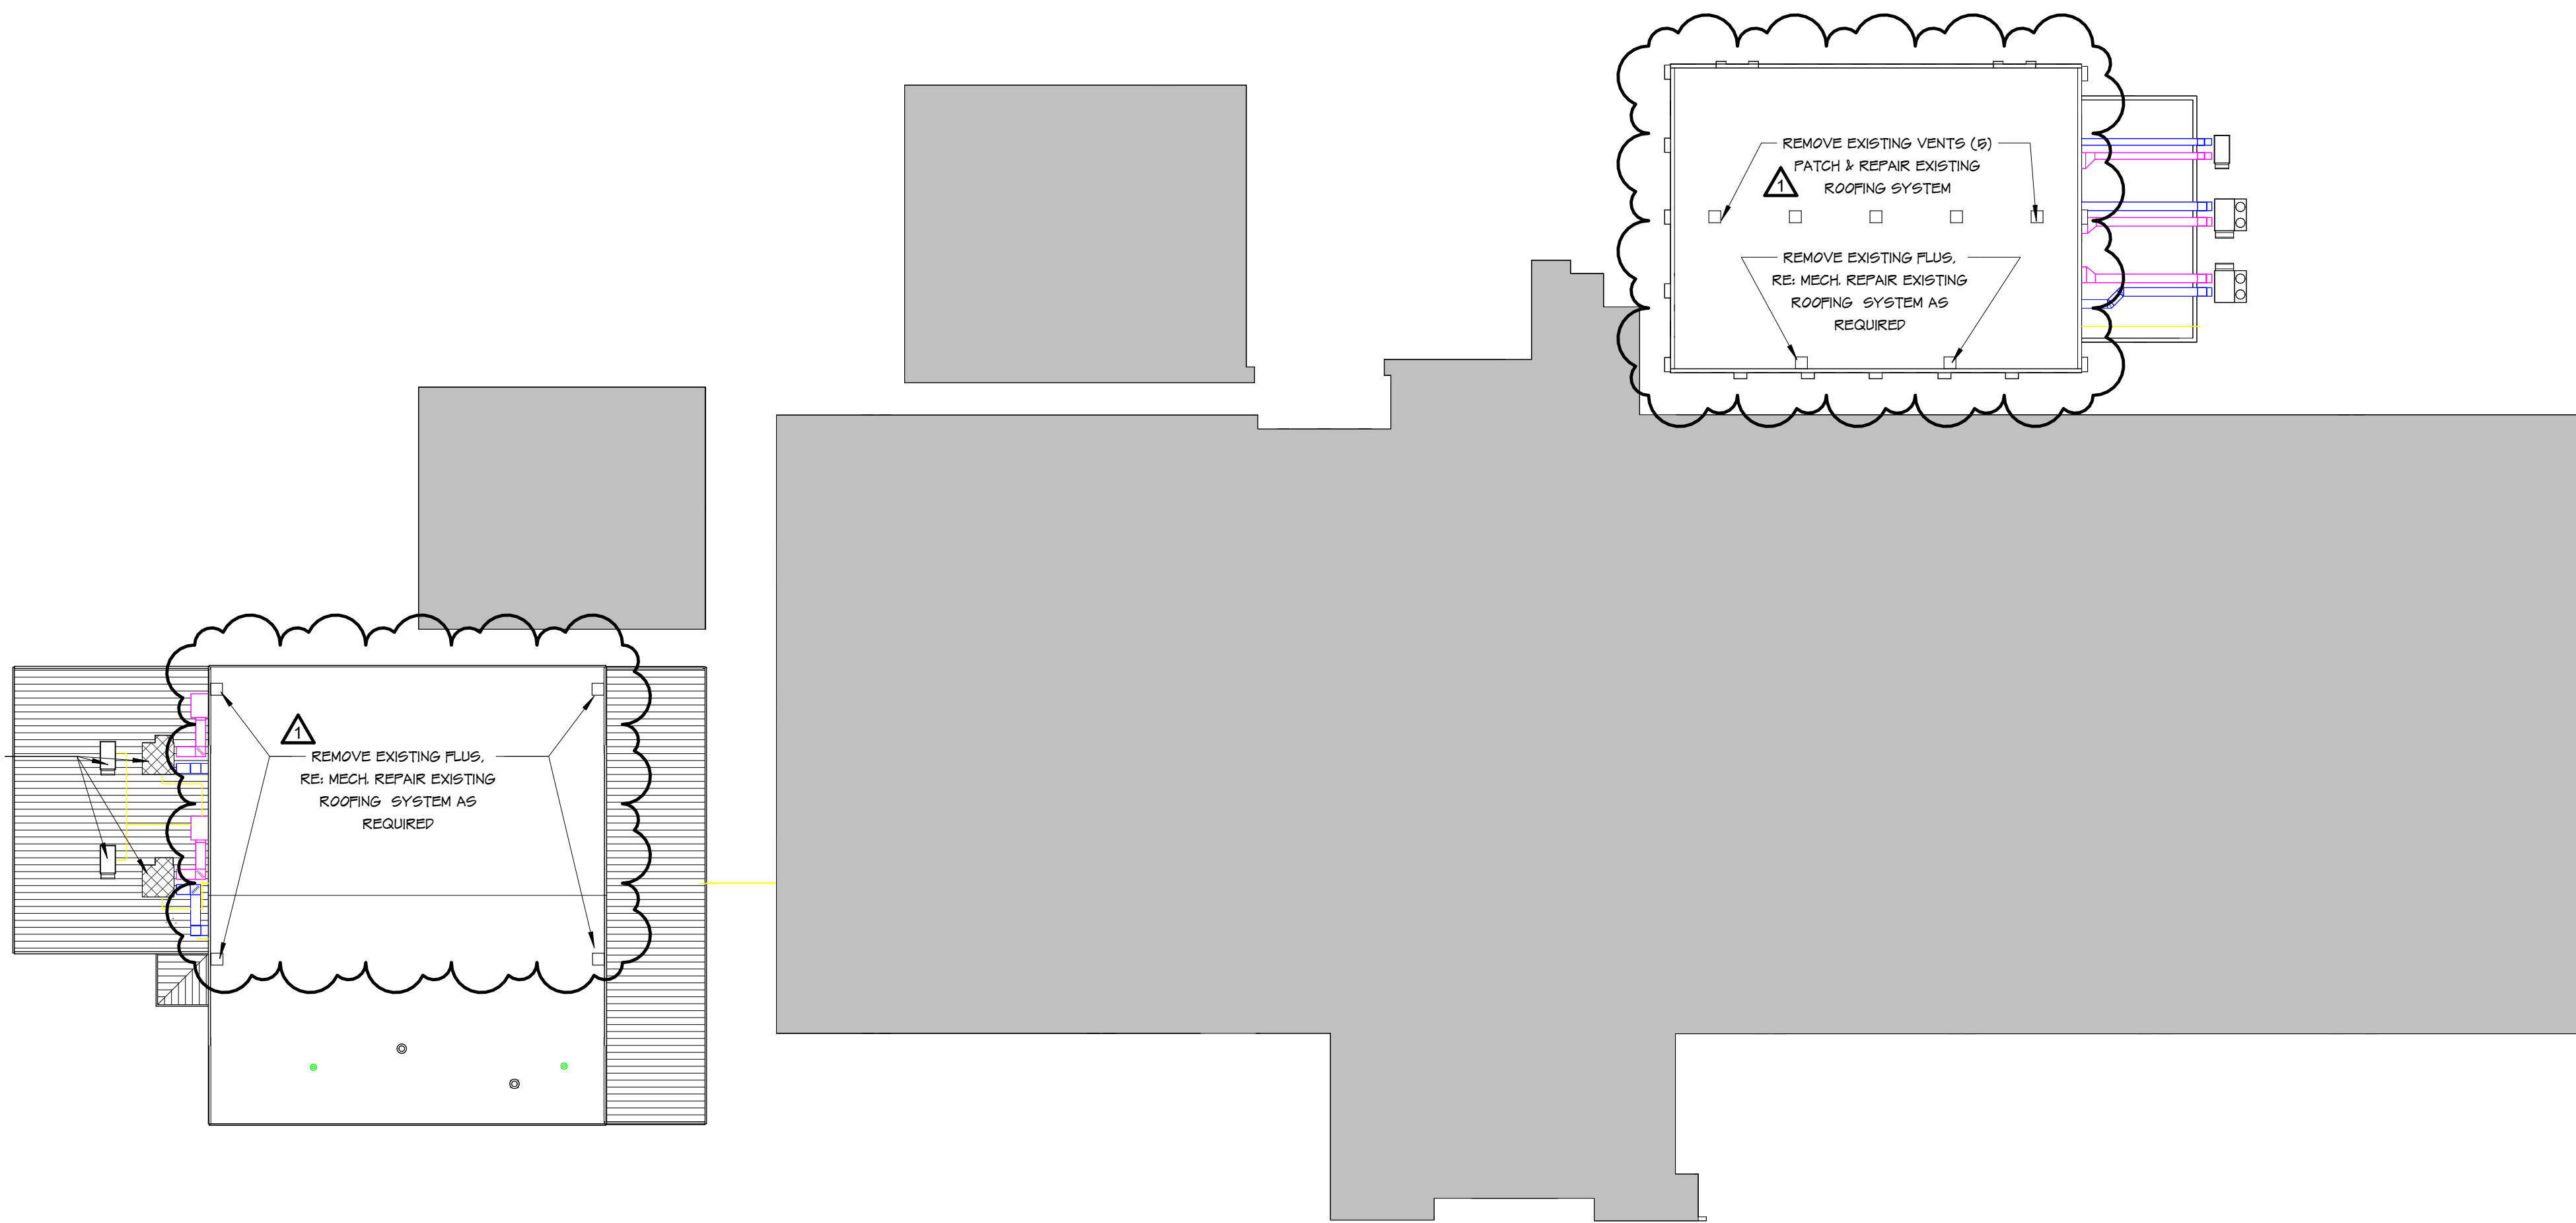

**1 ROOF PLAN**  
SCALE: 1/32" = 1'-0"

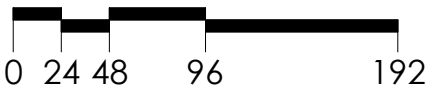

ROOF PLAN GENERAL NOTES

- A. REFER TO THE MECHANICAL AND PLUMBING DRAWINGS FOR ROOF TOP UNITS, ELECTRICAL CONDUIT, PLUMBING VENTS, ROOF CURBS, EXHAUST FANS, AND OTHER EQUIPMENT LOCATED ON THE EXISTING ROOFS.
- B. CONTRACTOR TO COORDINATE WITH RECLAIM CONSTRUCTION FOR PATCHING AND REPAIRING EXISTING ROOFS TO MAINTAIN THE REQUIRED ROOF WARRANTIES. CONTACT ANTHONY HOLEMAN WWW.RECLAIMCONSTRUCT.COM
- C. THE MECHANICAL ROOF TOP UNITS SHALL BE INSTALLED ON SLOPING FACTORY MANUFACTURED INSULATED CURBS. ROOF CONTRACTOR SHALL PROVIDE ALL CANTS, ROOFING, FLASHINGS, AND ADDITIONAL CONTINUOUS 1x4 NAILER ON SIDE OF MECHANICAL CURBS FOR ROOF FLASHING.
- D. ALL PIPING / CONDUIT SHALL BE SUPPORTED ON MANUFACTURER PIPE SUPPORTS. REFERENCE MEP SHEETS FOR LOCATIONS.

ROOF PLAN LEGEND

- EXISTING ROOF
- NEW ROOF PATCH
- NEW ROOF TOP UNIT - REFER TO MECHANICAL
- R.T.U.
- KEYED NOTES - REFER TO THIS SHEET
- EXISTING METAL ROOF
- NOT IN PROJECT SCOPE

KEYED NOTES


ALTERNATES

- A. ALTERNATE NO. ONE - DESCRIPTION - SECTION 01 23 00 JUNIOR HIGH GYM - PUBLIC RESTROOMS RENOVATION
- B. ALTERNATE NO. TWO - DESCRIPTION - SECTION 01 23 00 JUNIOR HIGH GYM - RENOVATION OF ENTRY VESTIBULES AND CLASSROOM
- C. ALTERNATE NO. THREE - DESCRIPTION - SECTION 01 23 00 JUNIOR HIGH GYM - ADD HVAC TO EXISTING WEIGHT ROOM
- D. ALTERNATE NO. FOUR - DESCRIPTION - SECTION 01 23 00 ROCK GYM - CLEAN, PREP, & PAINT EXISTING WOOD BLEACHERS



ISSUED FOR CONSTRUCTION

**JACOB MARTIN**

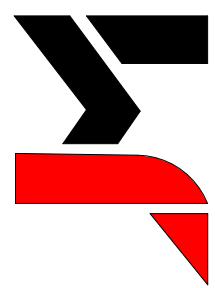

TBPELS FIRM # 10194493  
TBAE FIRM # BR 2261  
TBPE FIRM # 2448


HAMILTON ISD  
ROCK GYM & JH GYM RENOVATIONS

ROOF PLAN

NO.	REVISION	DATE	DESCRIPTION	PROJECT #	SCALE	PROJECT #	SCALE
1	ADDENDUM 1	10/29/2025		25327	As Indicated	25327	As Indicated
2							
3							
A8.0



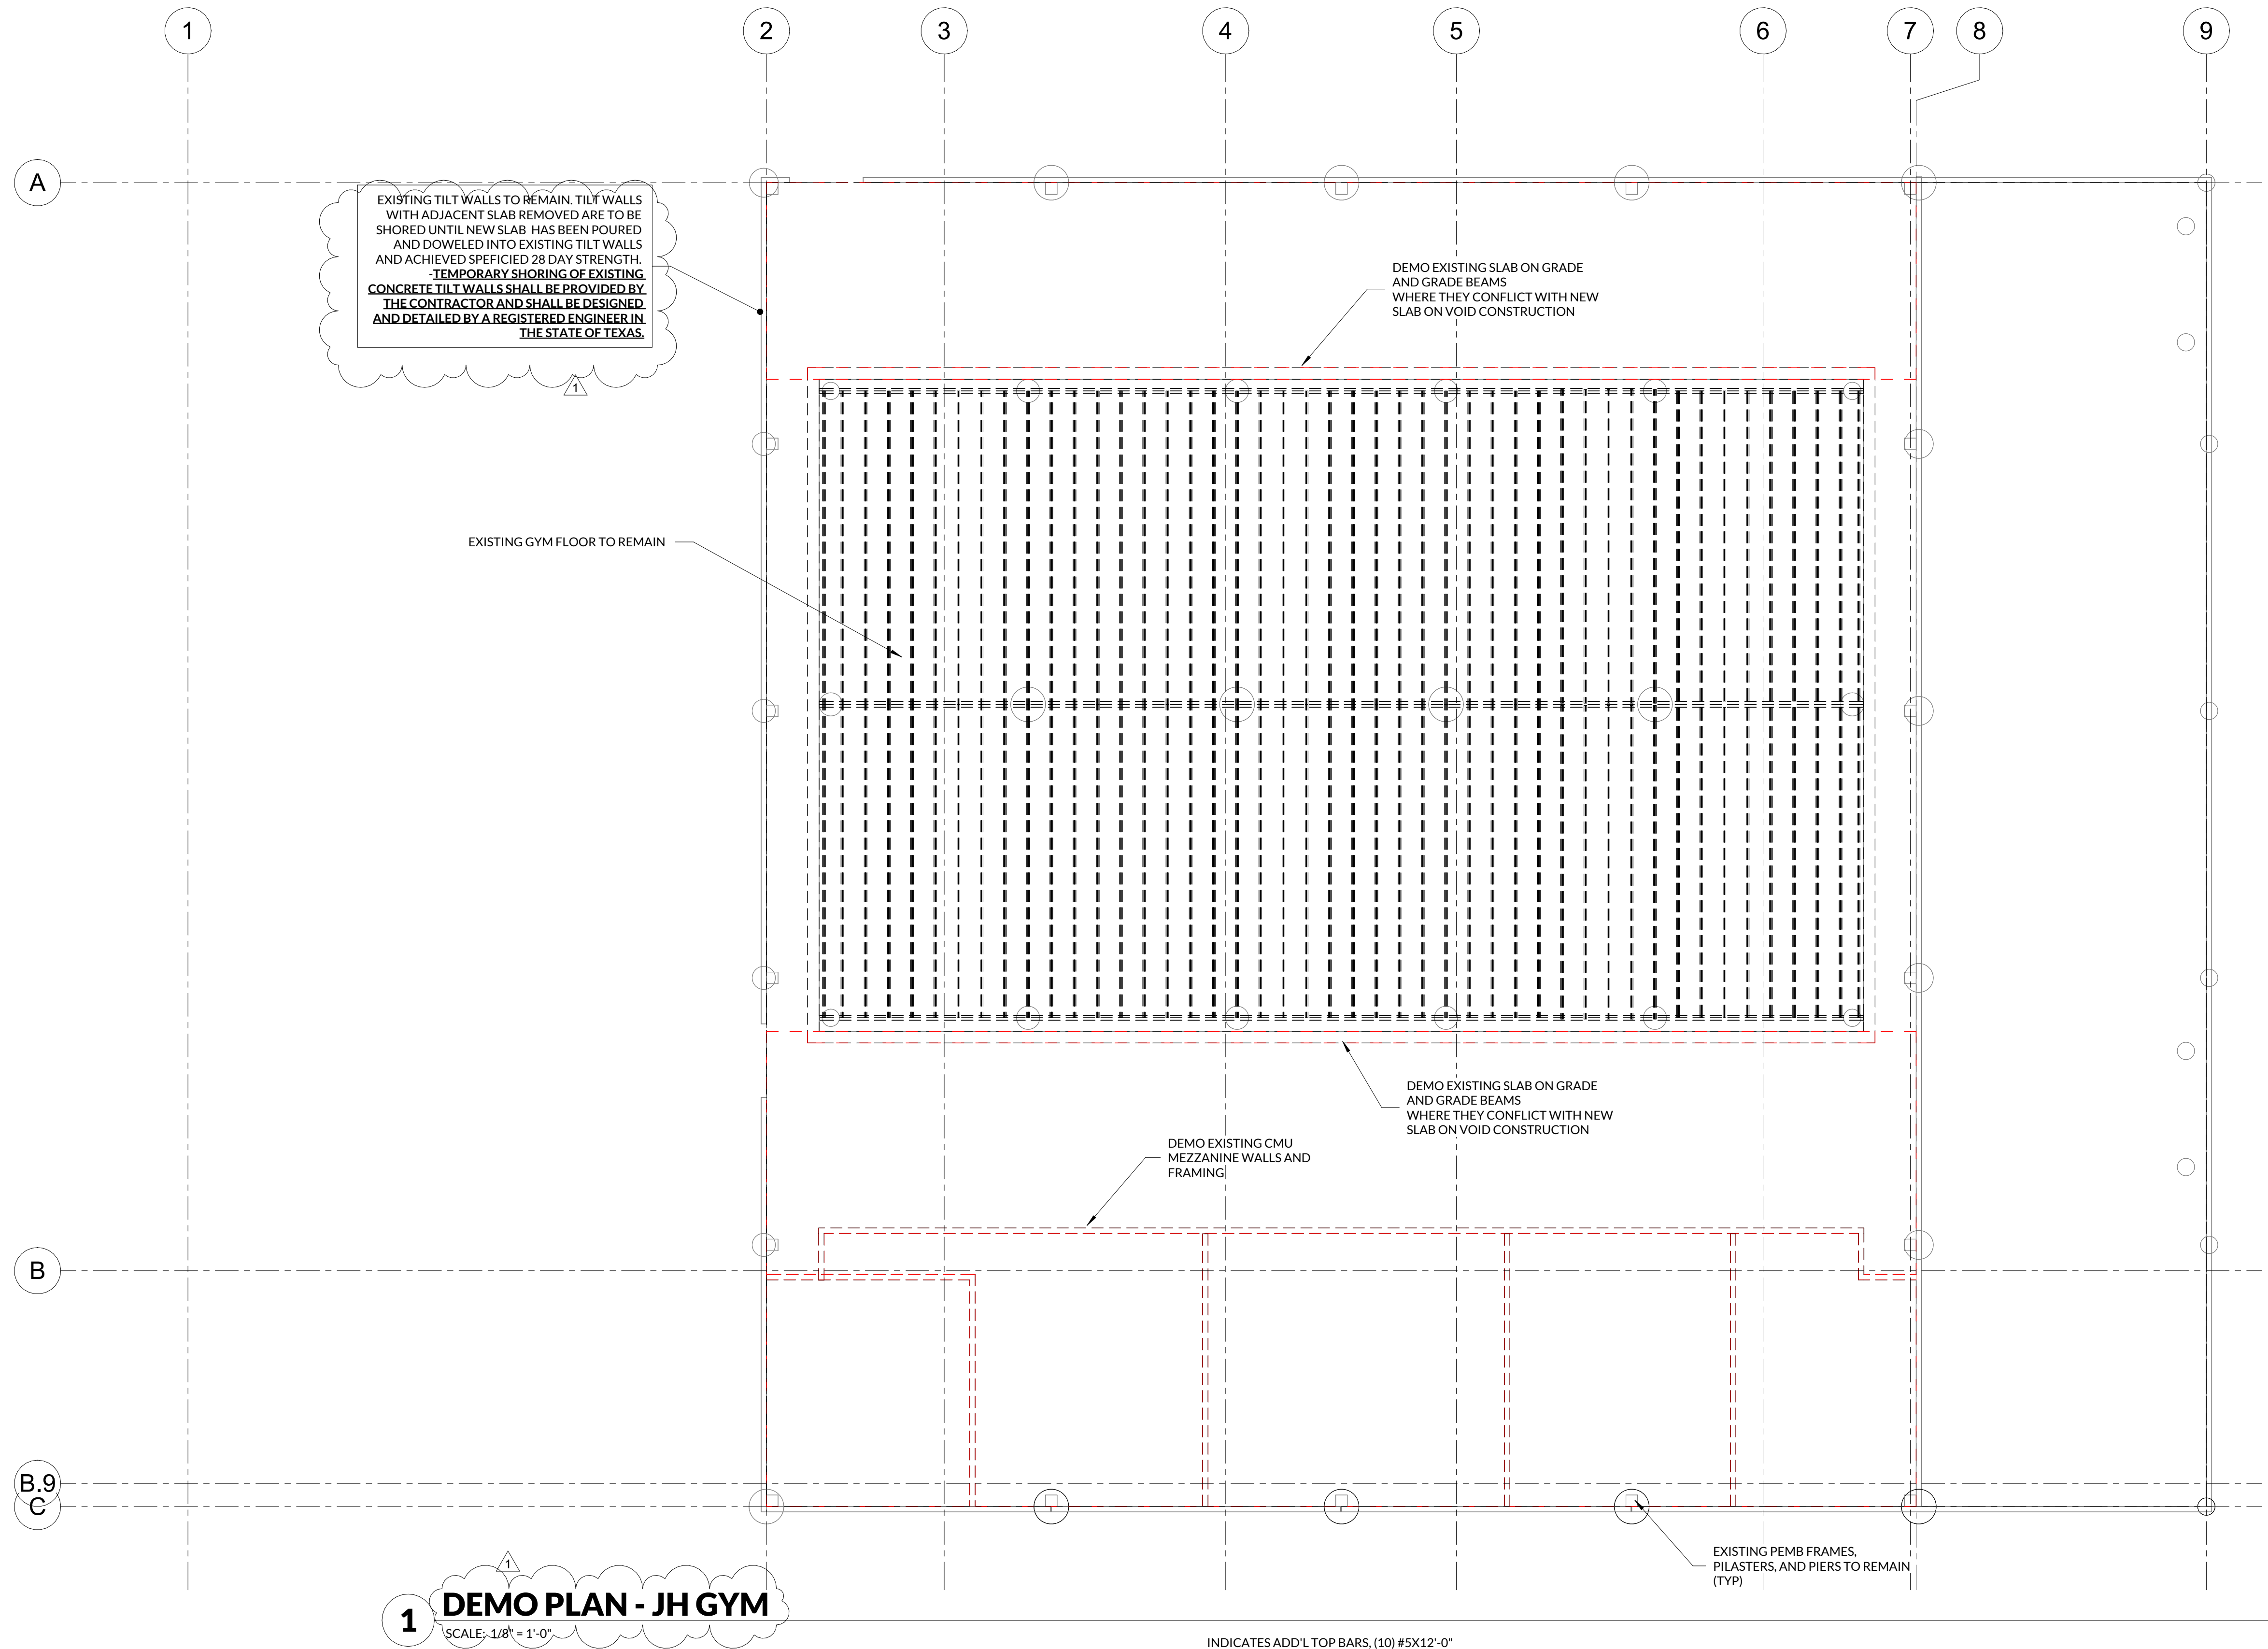

**1 DEMO PLAN - JH GYM**  
SCALE: 1/8" = 1'-0"

○ FD INDICATES FLOOR DRAIN

└ INDICATES SLAB STEP

INDICATES ADD'L TOP BARS, (10) #5X12'-0" EA WAY UNO, REF PLAN

PIER TYPE REF SCHED.


TOP OF PIER ELEV

COLUMN SIZE HSxSxSx1/4

BP-1 BASEPLATE TYPE -SEE 4/SO.2

INDICATES 8" LOAD BEARING CONCRETE MASONRY WALL REINFORCE W/ #5 @ 32" OC & CONT BOND BEAM W/ (1)#5 @ 8'-0" OC VERT

PLAN LEGEND      PIER LEGEND      WALL LEGEND

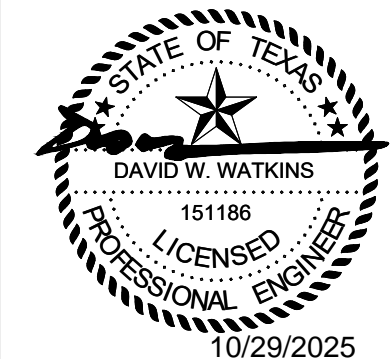

**JACOB MARTIN**

TBPE FIRM # 2448

TBAE FIRM # BR 2261

TBPELS FIRM # 10194493

HAMILTON ISD

ROCK GYM AND JH GYM RENOVATIONS


DEMO PLAN - JH GYM

NO.	REVISION	DATE
1	ADDENDUM 1	10/29/25
2		
3		
NO.	REVISION	DATE
1	1/1/21	1/1/21
2	1/1/21	1/1/21
3	1/1/21	1/1/21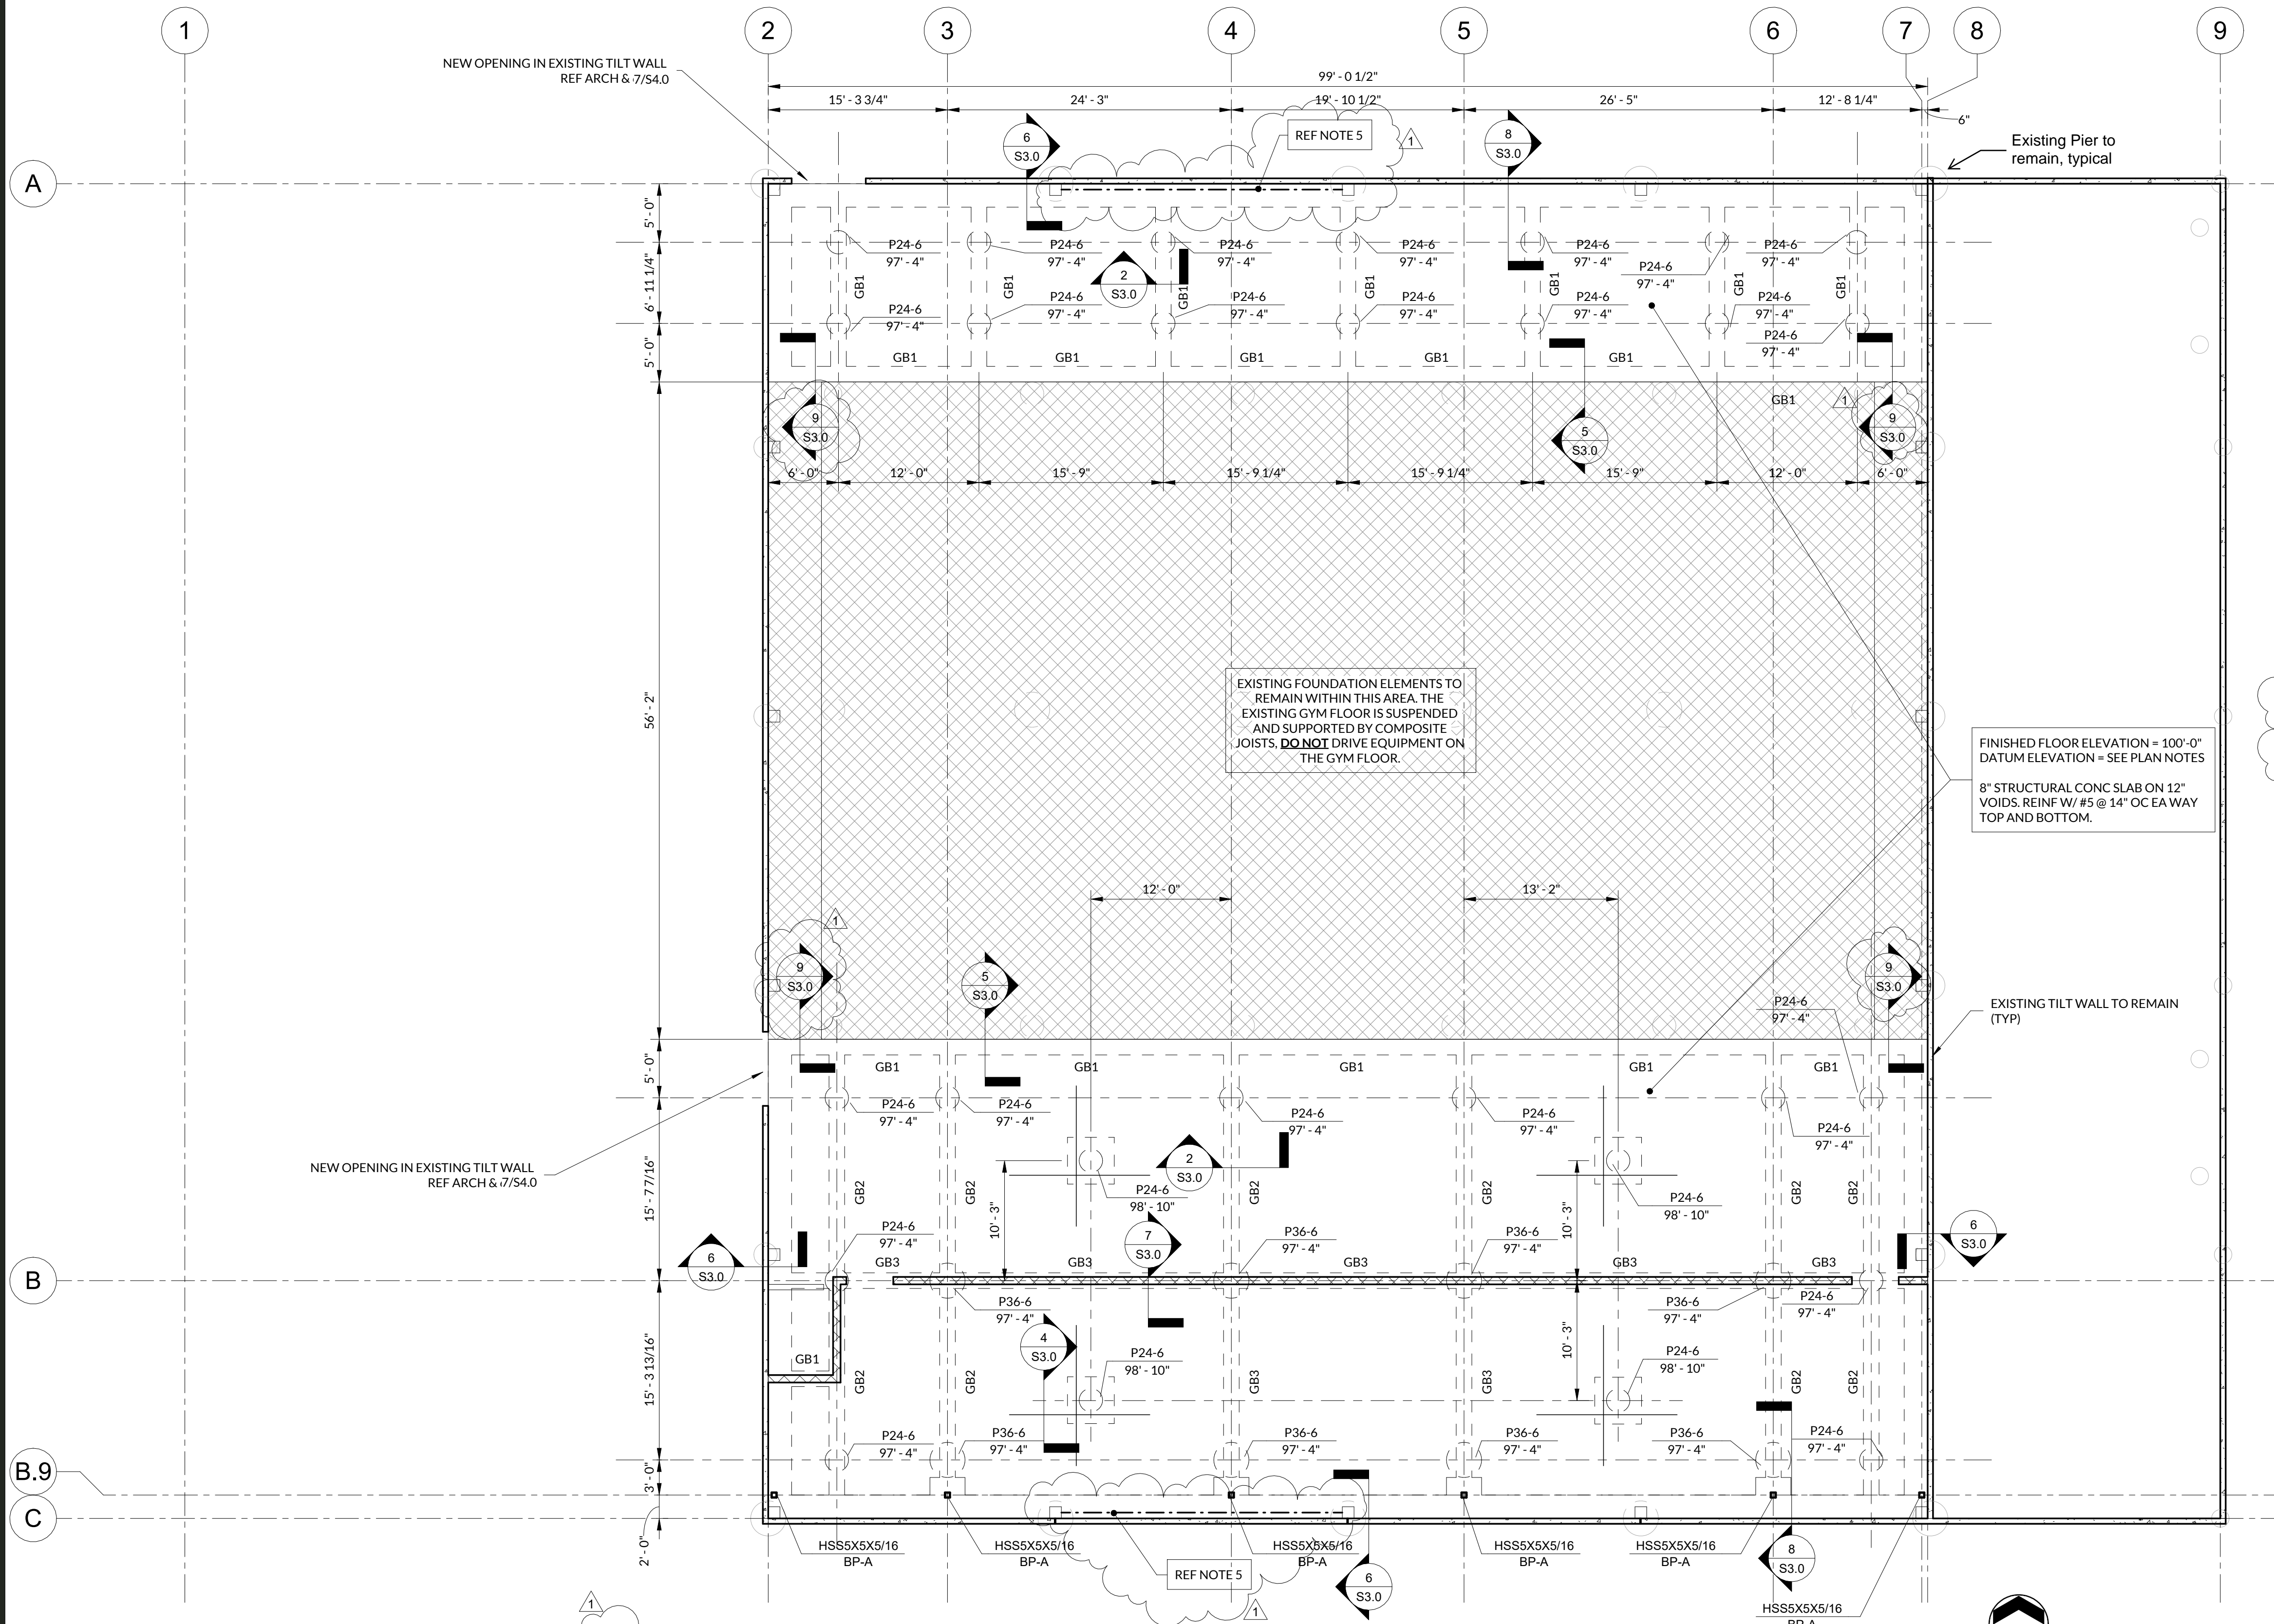
- NOTES:
- ALL ELEVATIONS ARE BASED ON A RELATIVE ELEVATION OF 100'-0" EQUAL TO THE EXISTING FLOOR ELEVATION.
  - COORDINATE BUILDING DIMENSIONS, WALL OPENING LOCATIONS AND DIMENSIONS, AND SLAB STEP AND SLOPE DIMENSIONS AND LOCATIONS WITH ARCHITECTURAL DRAWINGS. COORDINATE NON LOAD BEARING WALL LOCATIONS WITH ARCHITECTURAL PLANS. SEE S6.1 FOR NON LOAD BEARING WALL TYPICAL DETAILS AND REINF MINIMUMS.
  - ALL ANCHOR BOLTS ARE TO BE SET USING PLYWOOD TEMPLATES ATTACHED TO FORM WORK
  - IN THE EVENT OF A MISLOCATED OR MISSED ANCHOR BOLT, CONTRACTOR SHALL BE RESPONSIBLE FOR ANY REQUIRED REMOVAL & REPLACEMENT OF CONCRETE.

- EXISTING STRUCTURE NOTES:
- FIELD VERIFY DIMENSIONS AND ELEVATIONS OF EXISTING BUILDING AND COORDINATE WITH DIMENSIONS AND ELEVATIONS OF NEW CONSTRUCTION. NOTIFY ARCHITECT AND ENGINEER OF ANY DISCREPANCIES OR CONFLICTS PRIOR TO BEGINNING WORK.
  - SHORE ALL EXISTING FRAMING MEMBERS AS REQUIRED TO SAFELY SUPPORT EXISTING DEAD LOADS AND DESIGN LIVE LOADS PRIOR TO REMOVAL OF EXISTING STRUCTURE.
  - BEFORE OR CONCURRENT WITH ANY EXCAVATION, ADEQUATE SUPPORT TO THE SUBBASE AND SUBGRADE OF EXISTING SLABS AND FOUNDATIONS SHALL BE ESTABLISHED AS REQUIRED TO PREVENT UNDERMINING.
  - EXISTING STRUCTURAL MEMBER LOCATIONS AND DIMENSIONS ARE BASED ON ORIGINAL STRUCTURAL DRAWINGS. WHERE FABRICATION OF NEW MEMBERS DEPENDS ON EXISTING DIMENSIONS, DIMENSIONS SHALL BE FIELD VERIFIED PRIOR TO FABRICATION.
  - IT IS JACOB MARTIN'S UNDERSTANDING THAT THE PEMB FRAMES HAD X BRACE CABLES THAT HAVE BEEN CUT. GC TO IDENTIFY PREVIOUS LOCATIONS OF X BRACING AND REPLACE THE CUT CABLES WITH NEW CABLES OF THE SAME SIZE AND QUANTITY. LOCATIONS SHOWN ON PLAN ARE SCHEMATIC AND MAY NOT REFLECT ALL OF THE BRACED FRAMES THAT NEED TO BE REPLACED.

**1 JH GYM FOUNDATION PLAN**  
SCALE: 1/8" = 1'-0"

**PLAN LEGEND**



- FD INDICATES FLOOR DRAIN
- INDICATES SLAB STEP

**PIER LEGEND**

- INDICATES ADD'L TOP BARS, (10) #5X12"-0" EA WAY UNO, REF PLAN
- PIER TYPE REF SCHED.
- TOP OF PIER ELEV
- COLUMN SIZE HSS5X5X5/14
- BP-1 BASEPLATE TYPE -SEE 4/50.2


INDICATES 8" LOAD BEARING CONCRETE MASONRY WALL REINFORCE W/ #5 @ 32" OC & CONT BOND BEAM W/ (1)#5 @ 8'-0" OC VERT

PIER SCHEDULE				
MARK	DIAMETER	EMBED	VERTICAL BARS	TIES
P24-6	2' - 0"	6' - 0"	(6)#6	#3@12"OC
P36-6	3' - 0"	6' - 0"	(7)#8	#3@12"OC

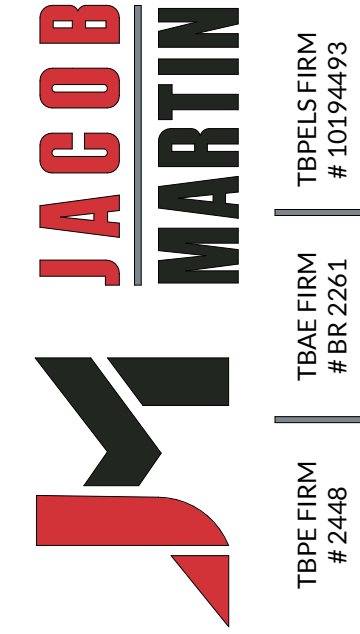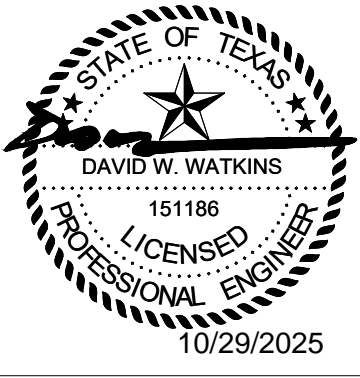

HAMILTON ISD  
**ROCK GYM AND JH GYM RENOVATIONS**  
**JH GYM FOUNDATION PLAN**

SEQ.	NO. REVISION	DATE
	ADDENDUM 1	10/29/25

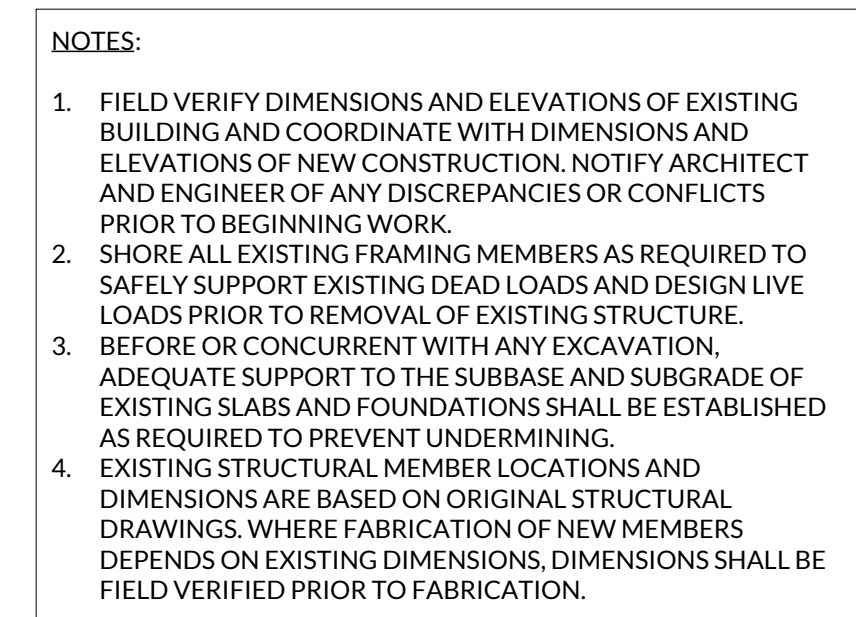

SCALE: 1/8" = 1'-0"

### S1.3



**JACOB  
MARTIN**

TBPE FIRM  
# 2448

TBAE FIRM  
# BR 2261


TBPBLS FIRM  
# 10194493

HAMILTON ISD

ROCK GYM AND JH GYM RENOVATIONS

ROCK GYM FOUNDATION PLAN



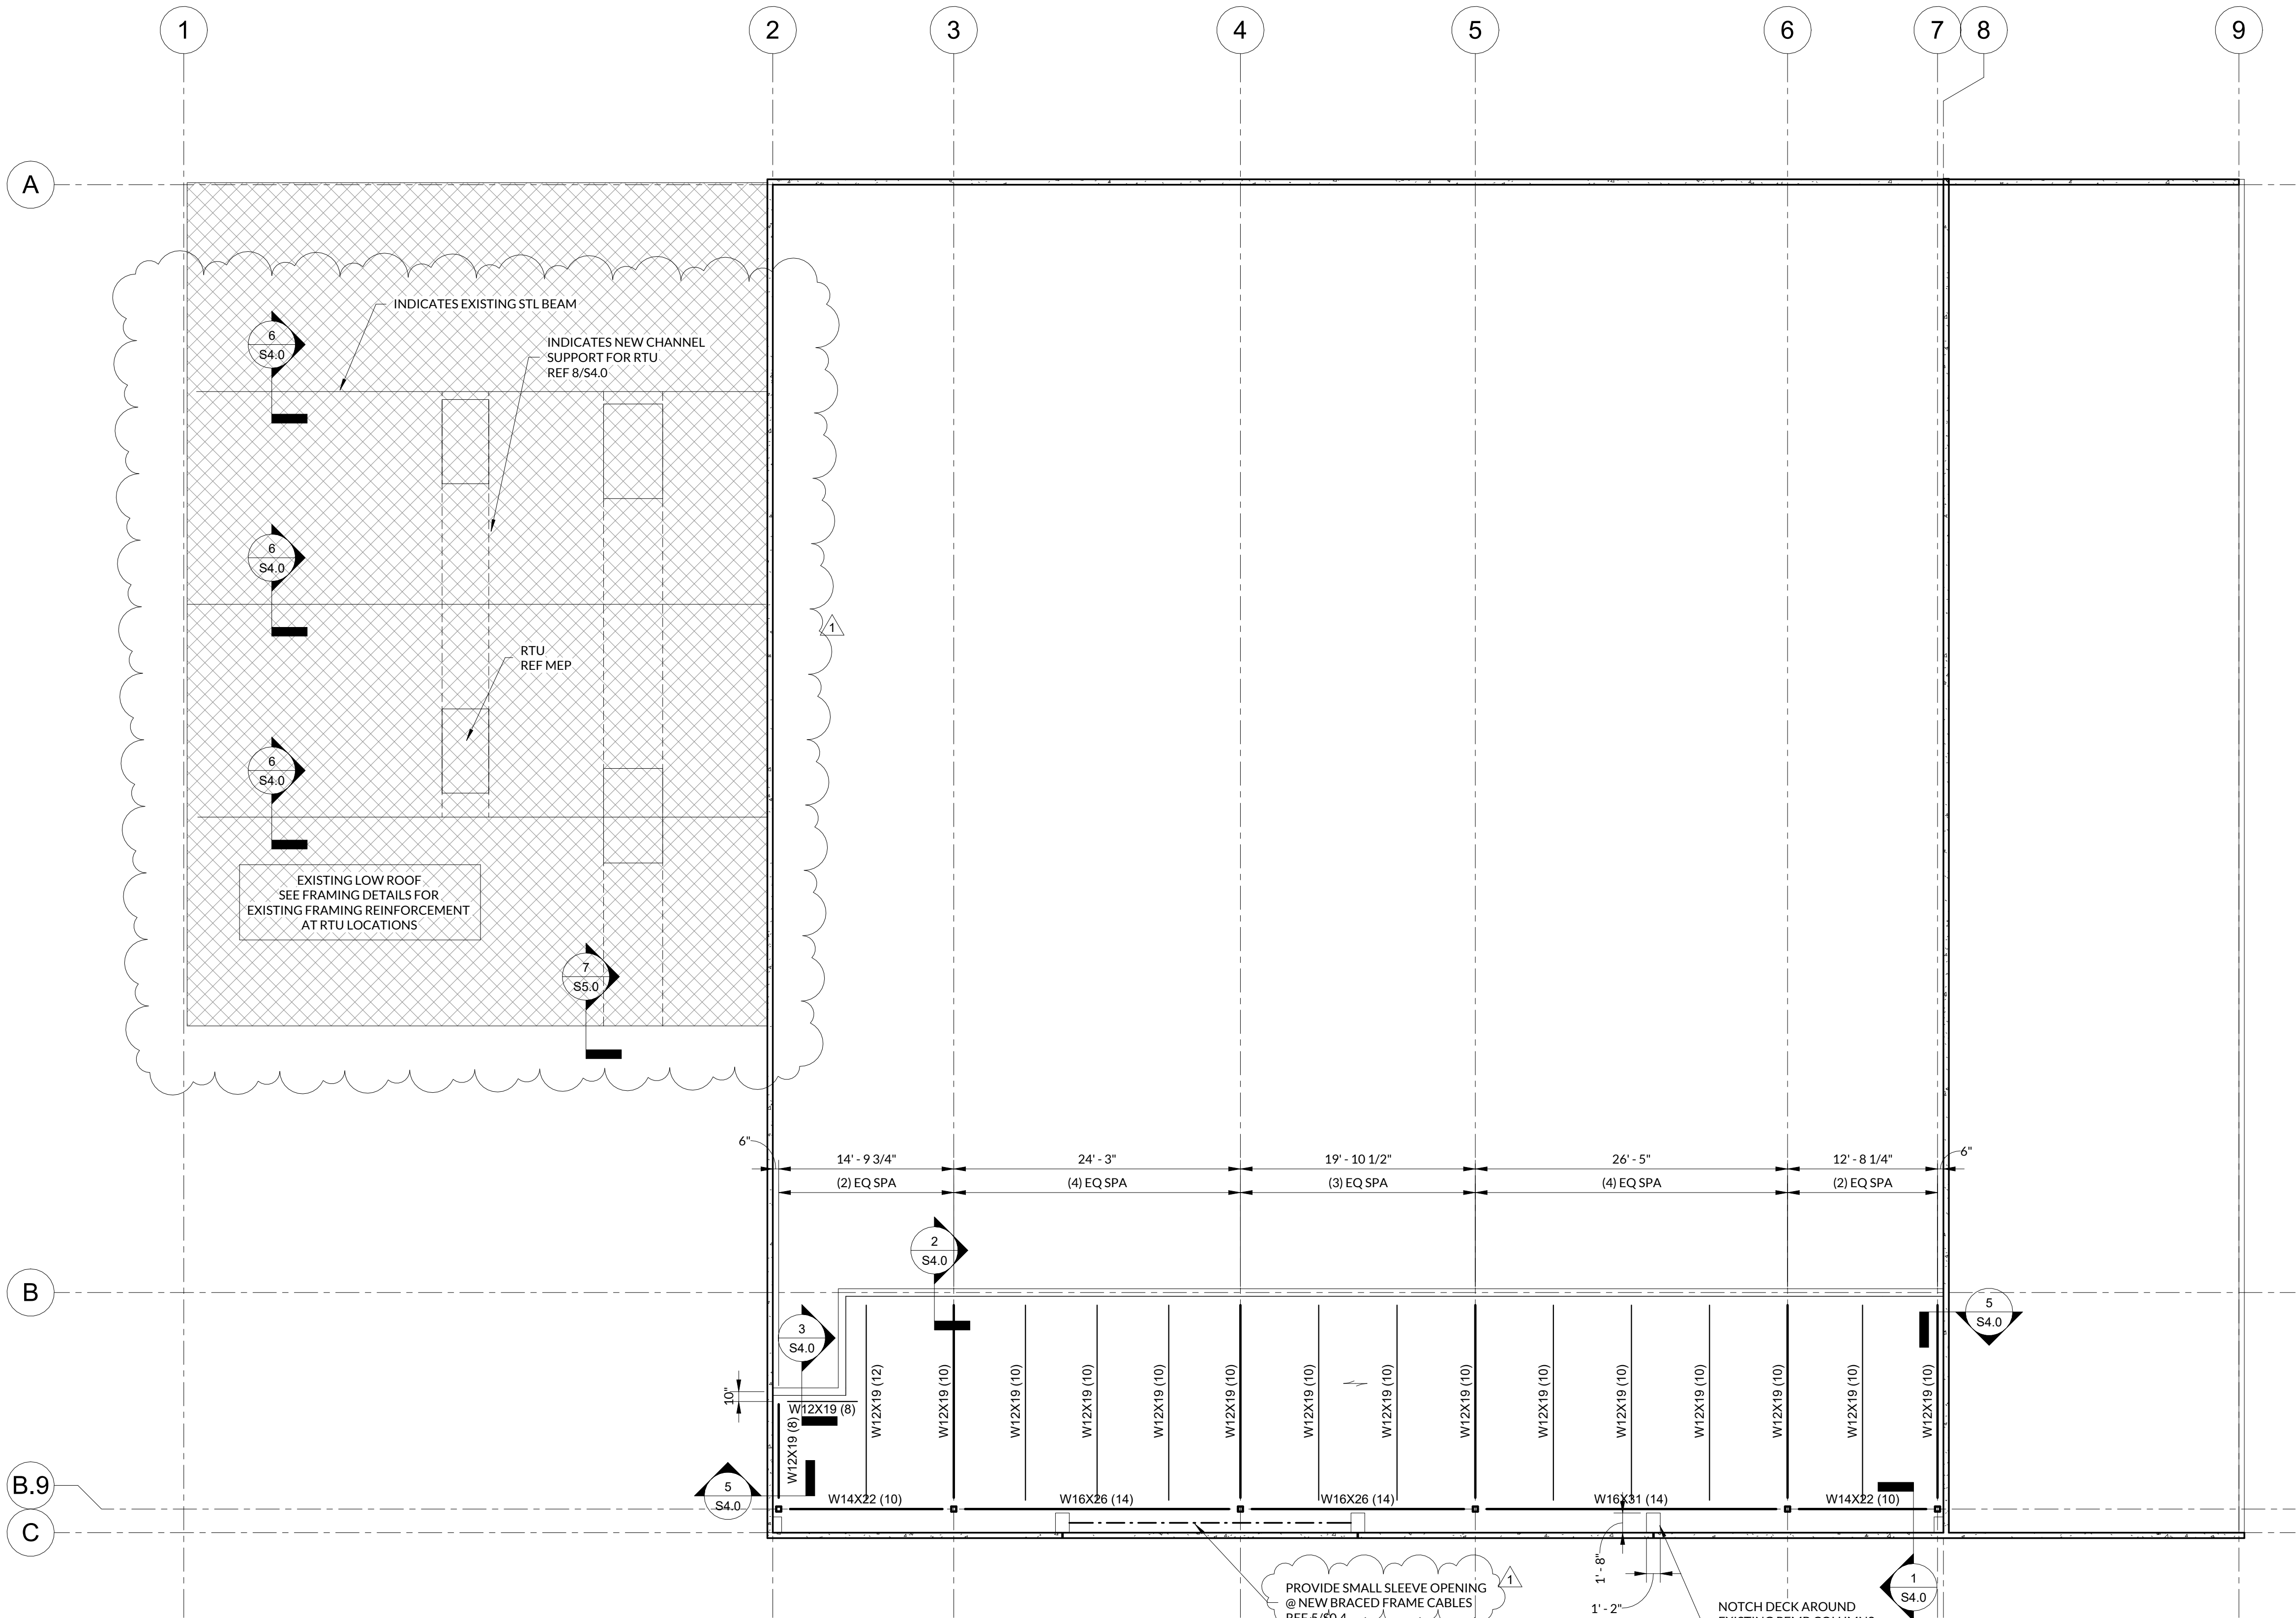

**1 MEZZANINE FRAMING PLAN - JH GYM**  
SCALE: 1/8" = 1'-0"

**FLOOR DECK:**  
3 1/2" NORMAL WEIGHT CONCRETE ON 2"  
20 GA GALV COMPOSITE DECK. TOTAL SLAB  
THICKNESS = 5 1/2". REINFORCE W/ 6X6-W2.1XW2.1  
WELDED WIRE REINFORCEMENT

**TO S NOTE:**  
FINISHED FLOOR ELEVATION = 112'-0"  
TOP OF COMPOSITE BEAM SHALL BE 5 1/2"  
BELOW FFE UNO (3 1/2" CONCRETE ON 2" DECK)


INDICATES DECK SPAN  
DIRECTION

**PLAN LEGEND**

INDICATES NUMBER OF  
EQUALLY SPACED  
3/4"Øx4 1/2" SHEAR STUDS

BEAM SIZE  
INDICATES SLOPING BEAM


**BEAM LEGEND**

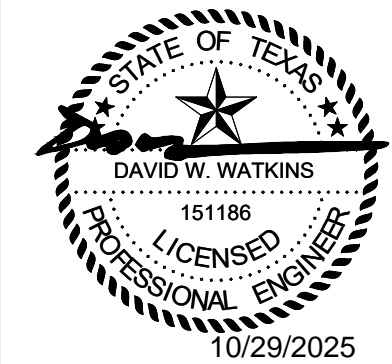

HAMILTON ISD  
ROCK GYM AND JH GYM RENOVATIONS  
MEZZANINE FRAMING PLAN - JH GYM

NO.	REVISION	DATE
1	ADDENDUM 1	10/29/25
2		
3		
NO.	REVISION	DATE	SCALE	PROJECT #	SHEET
1	ADDENDUM 1	10/29/25		25327	
2					
3					
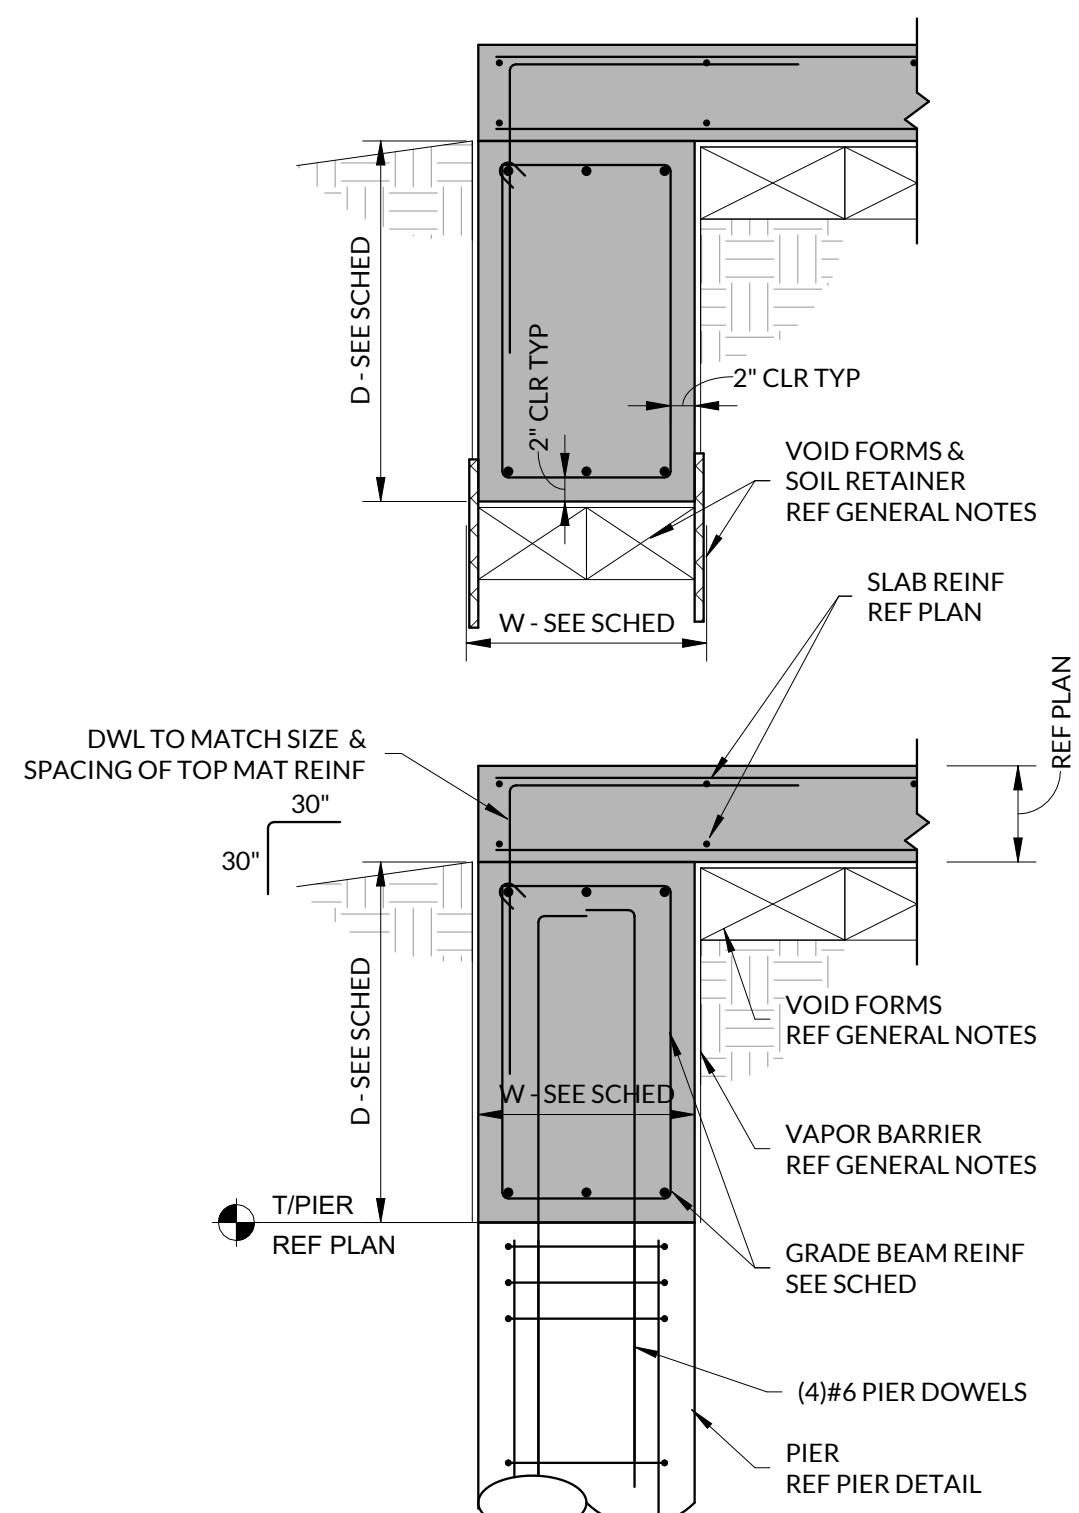


TYPE	D	W	REINFORCING
GB1	24"	16"	(2)#8 W/ #4 @ 10" OC
GB2	24"	16"	(3)#8 W/ #4 @ 10" OC
GB3	24"	16"	(4)#8 W/ #4 @ 10" OC

NOTES:  
1. EXTEND PIER DOWELS WITHIN 3" OF THE TOP OF GRADE BEAM.  
2. INTERMEDIATE PIERS ARE TO BE CENTERED ON THE GRADE BEAM UNO.


**1 TYPICAL GRADE BEAM DETAIL**  
SCALE: 3/4" = 1'-0"

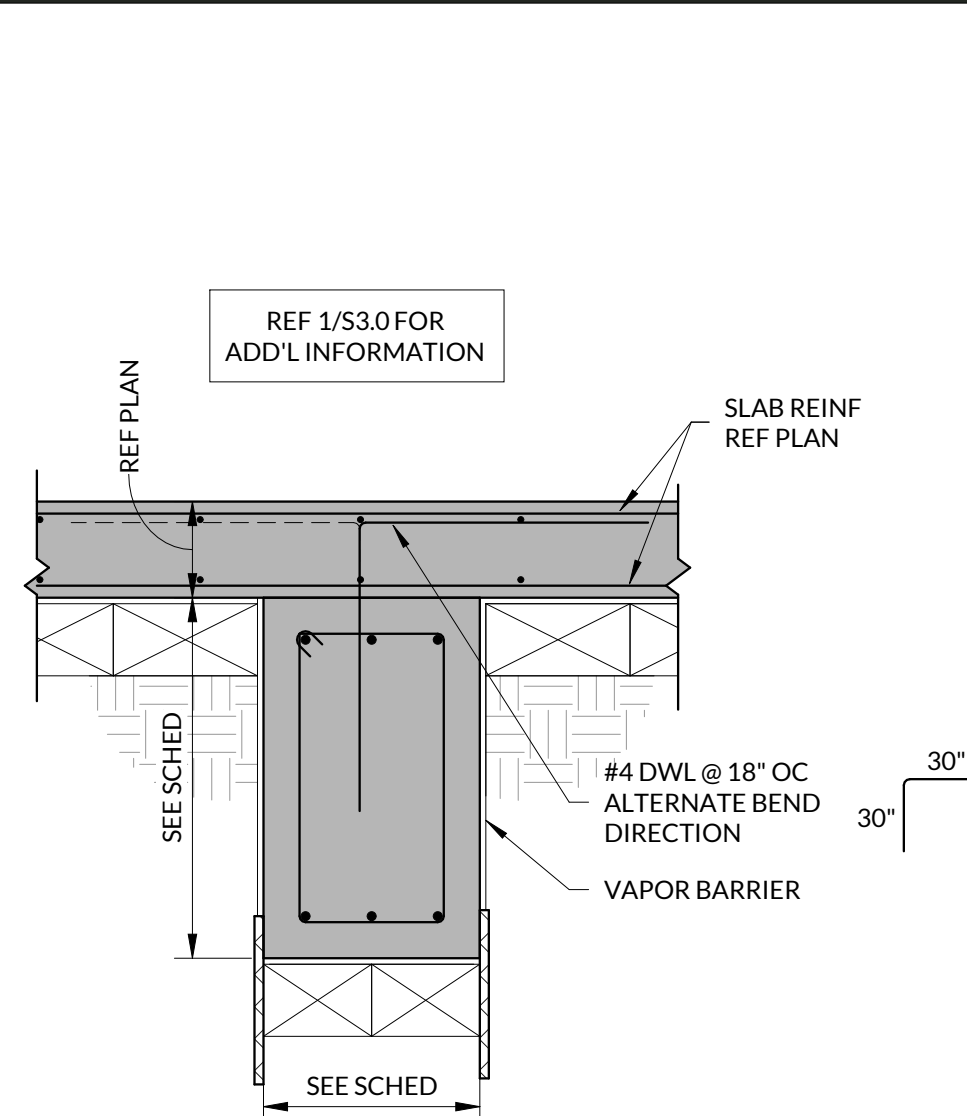


**2 INTERIOR GRADE BEAM DETAIL**  
SCALE: 3/4" = 1'-0"

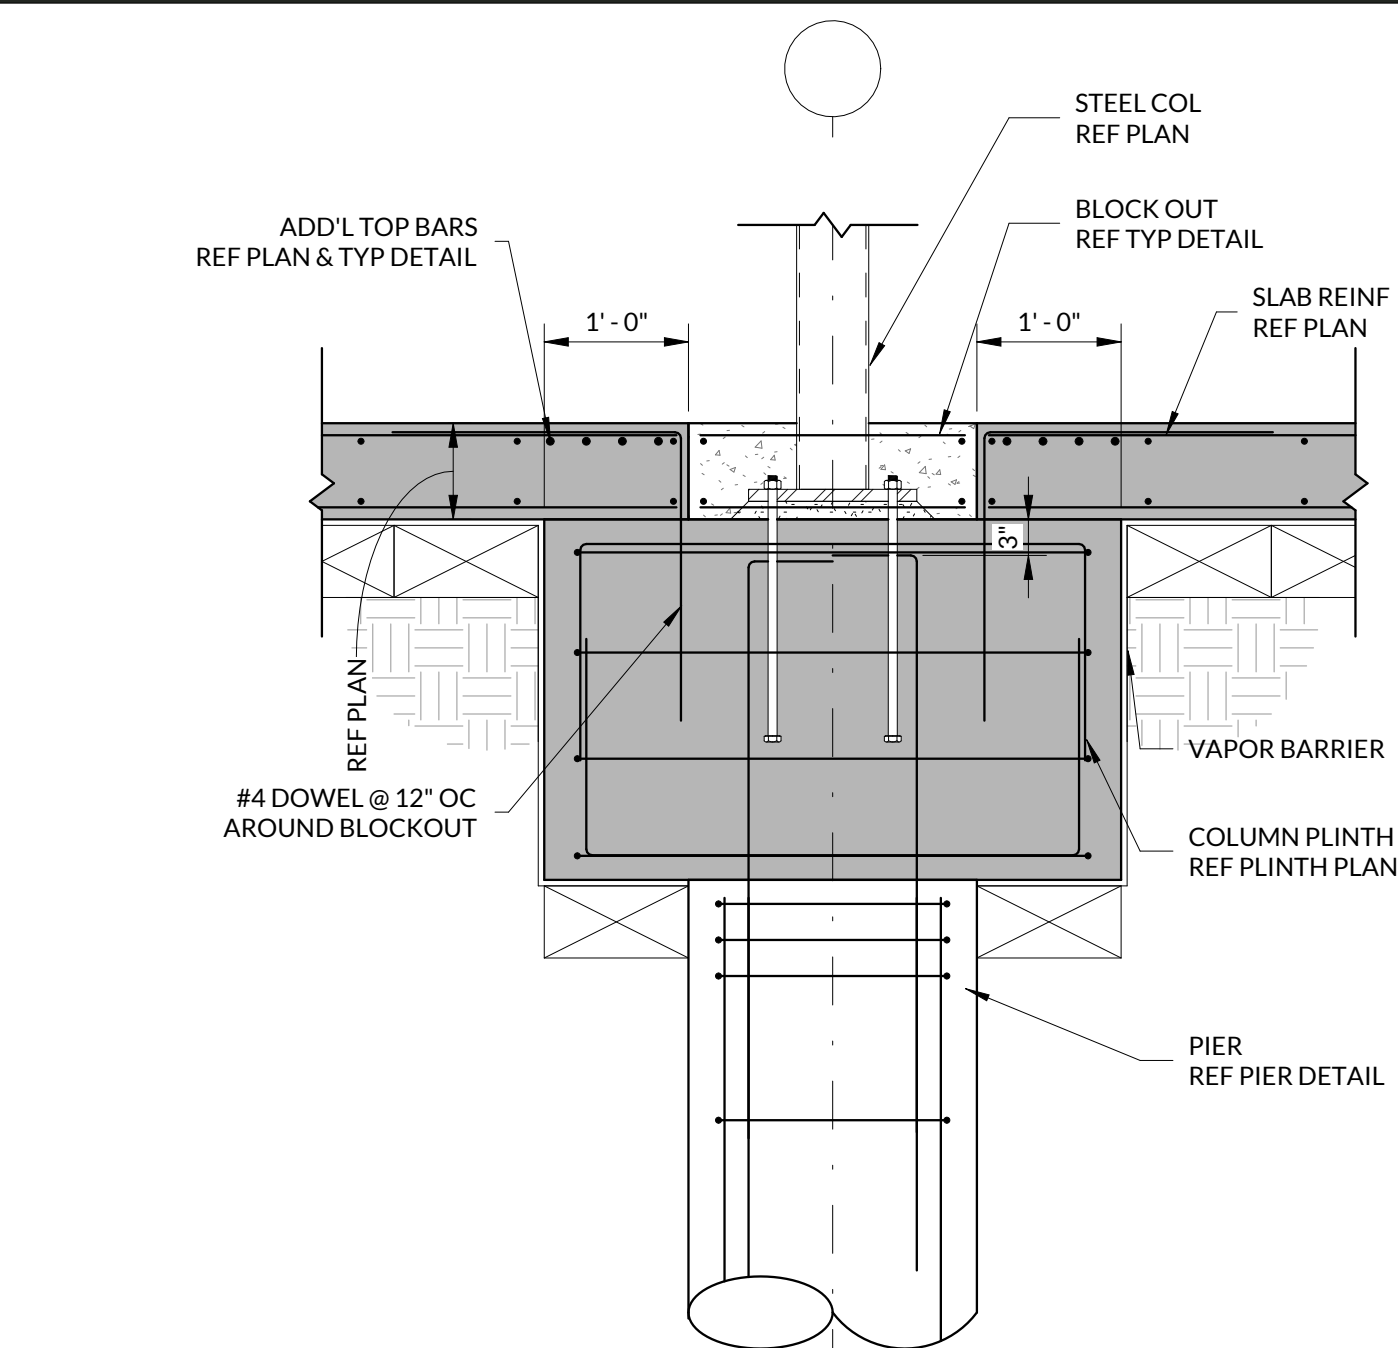

**3 INTERIOR COLUMN DETAIL**  
SCALE: 3/4" = 1'-0"


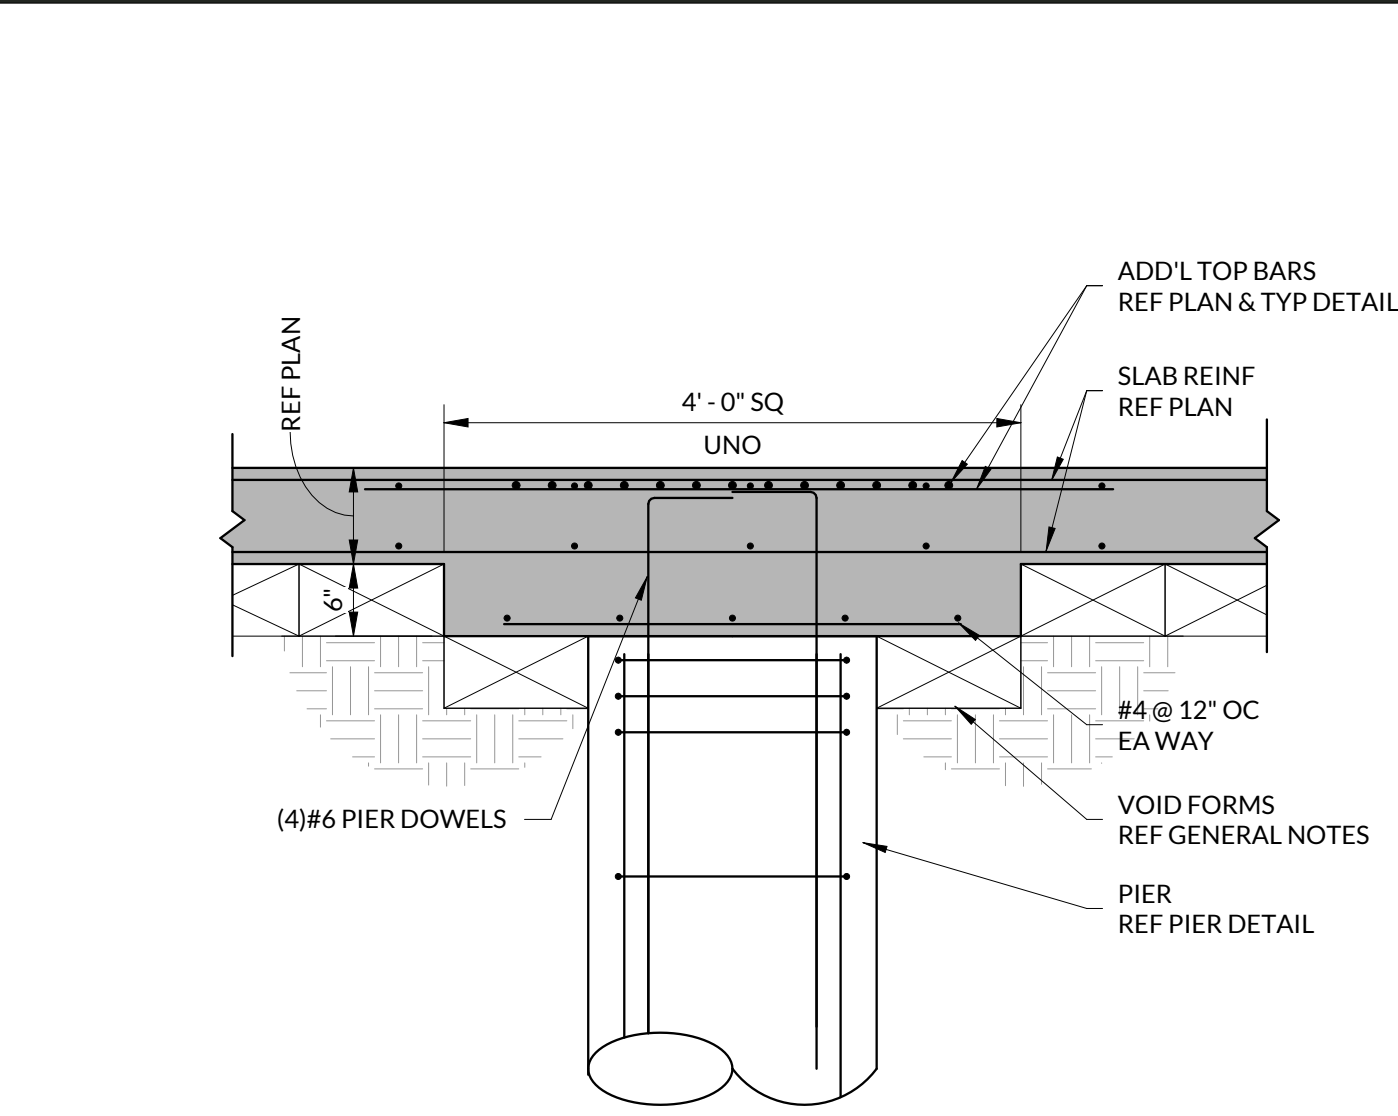


**4 DROP CAP DETAIL**  
SCALE: 3/4" = 1'-0"

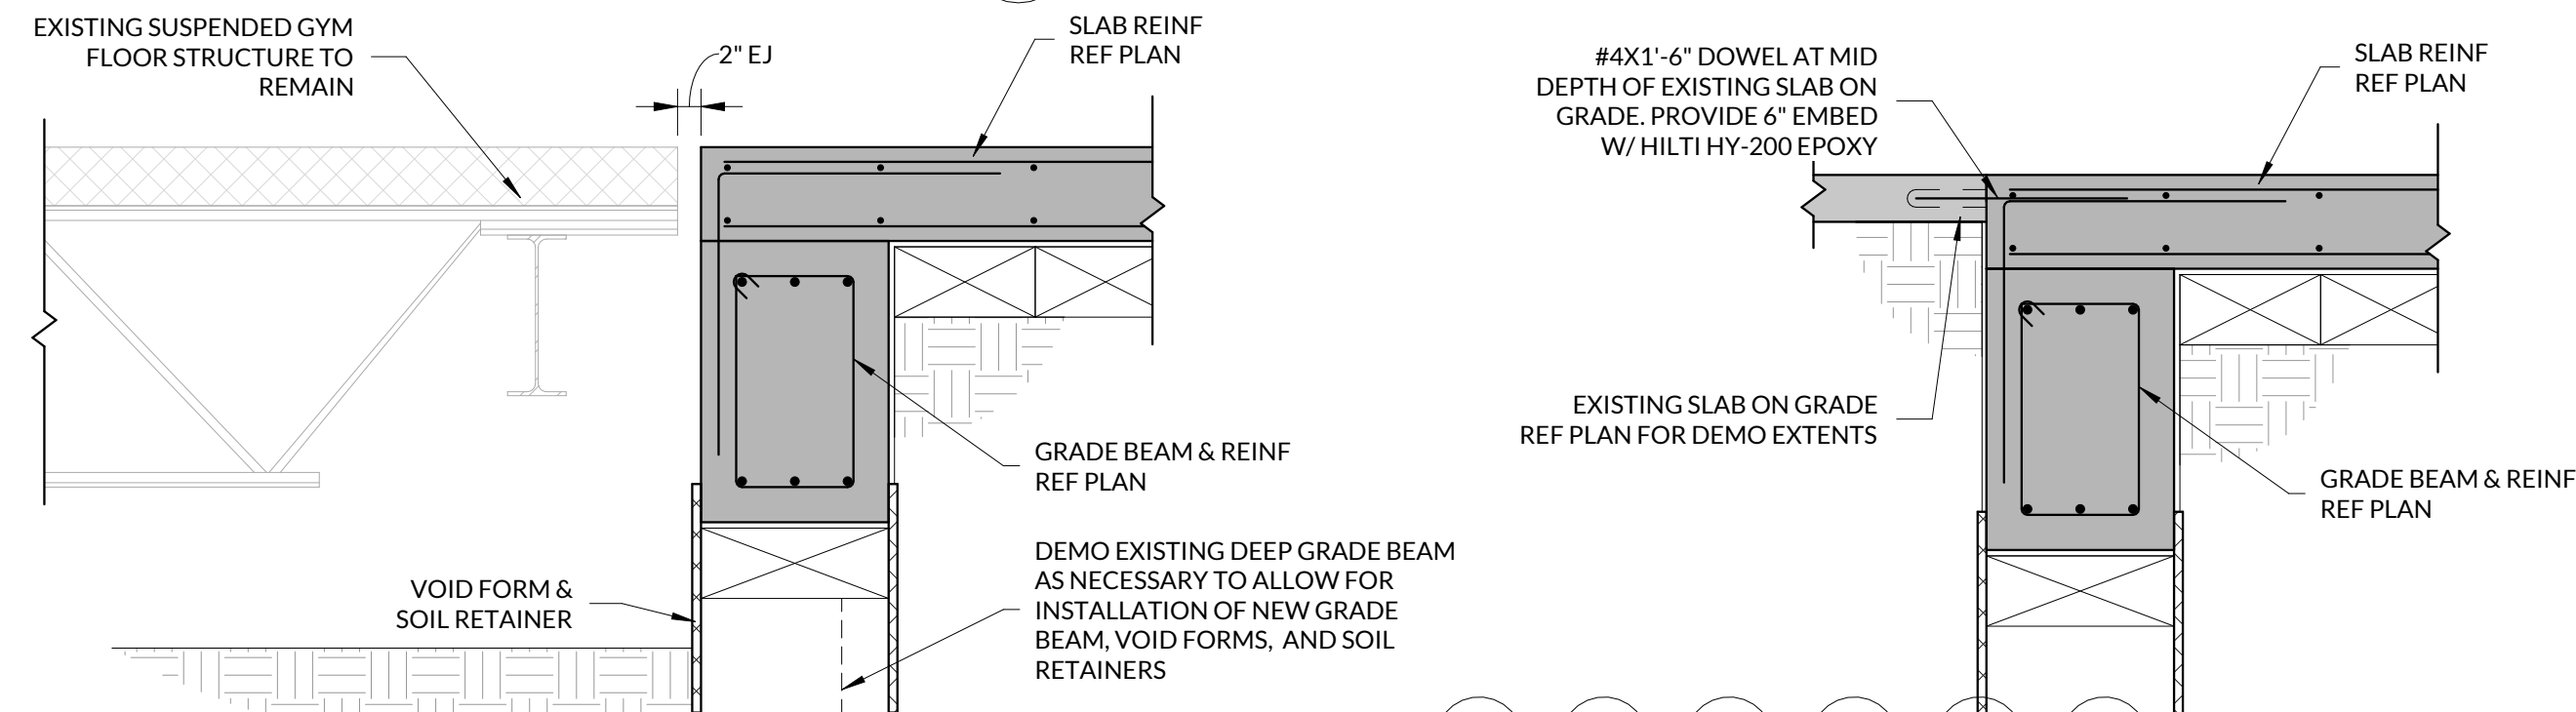


**5 DETAIL AT EXISTING GYM FLOOR**  
SCALE: 3/4" = 1'-0"


**9 DETAIL AT EXISTING**  
SCALE: 3/4" = 1'-0"

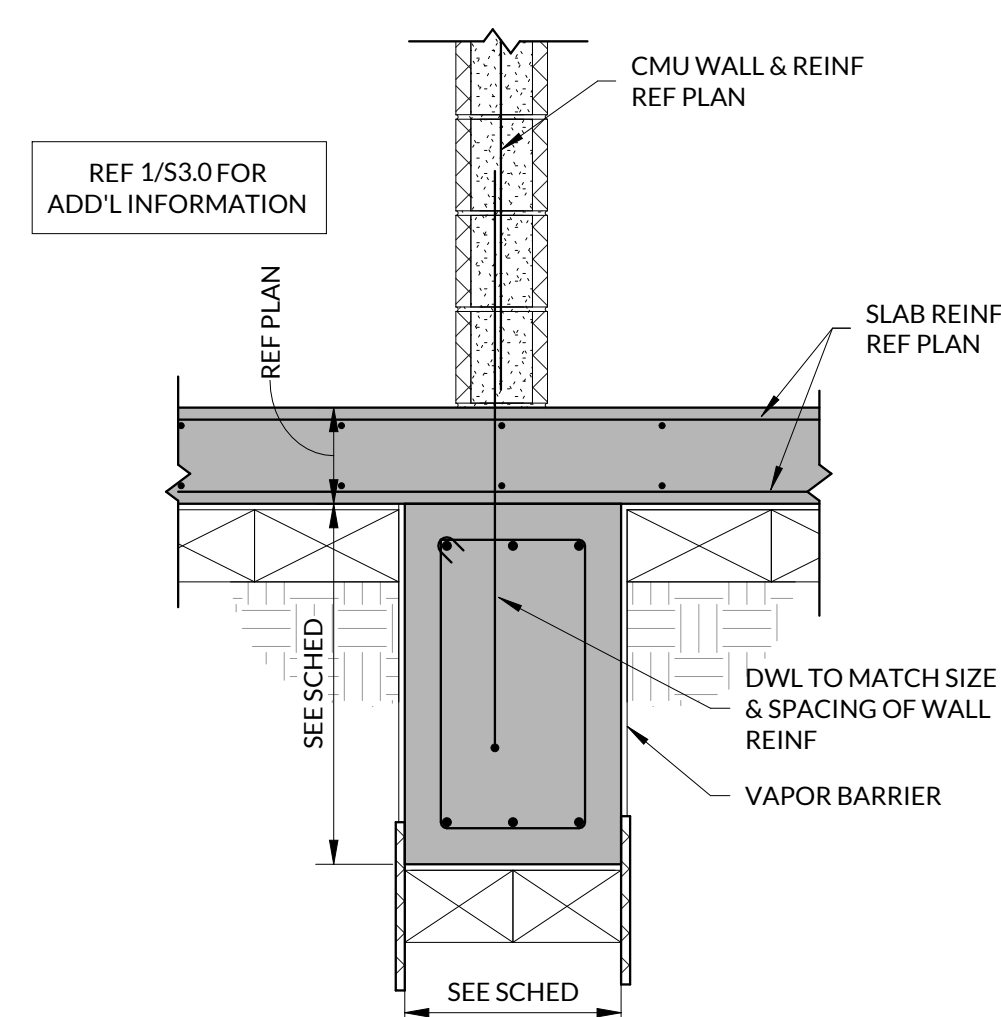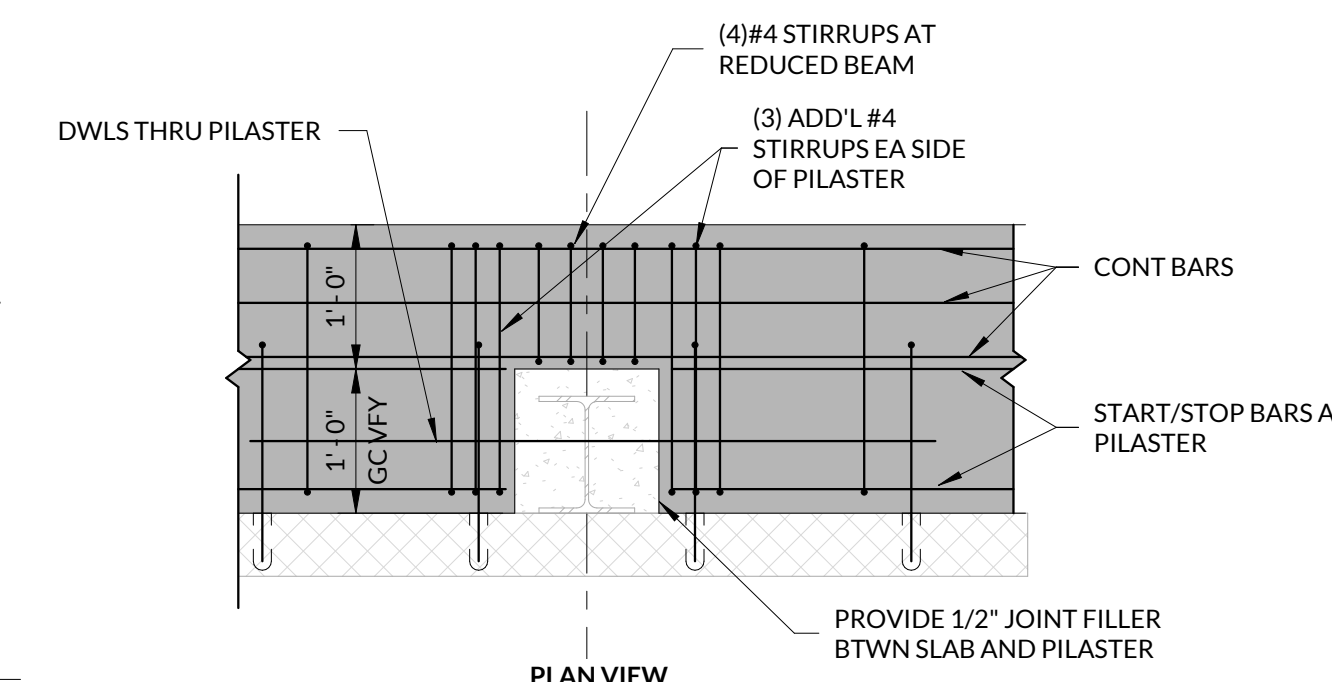

**7 INTERIOR GRADE BEAM DETAIL**  
SCALE: 3/4" = 1'-0"

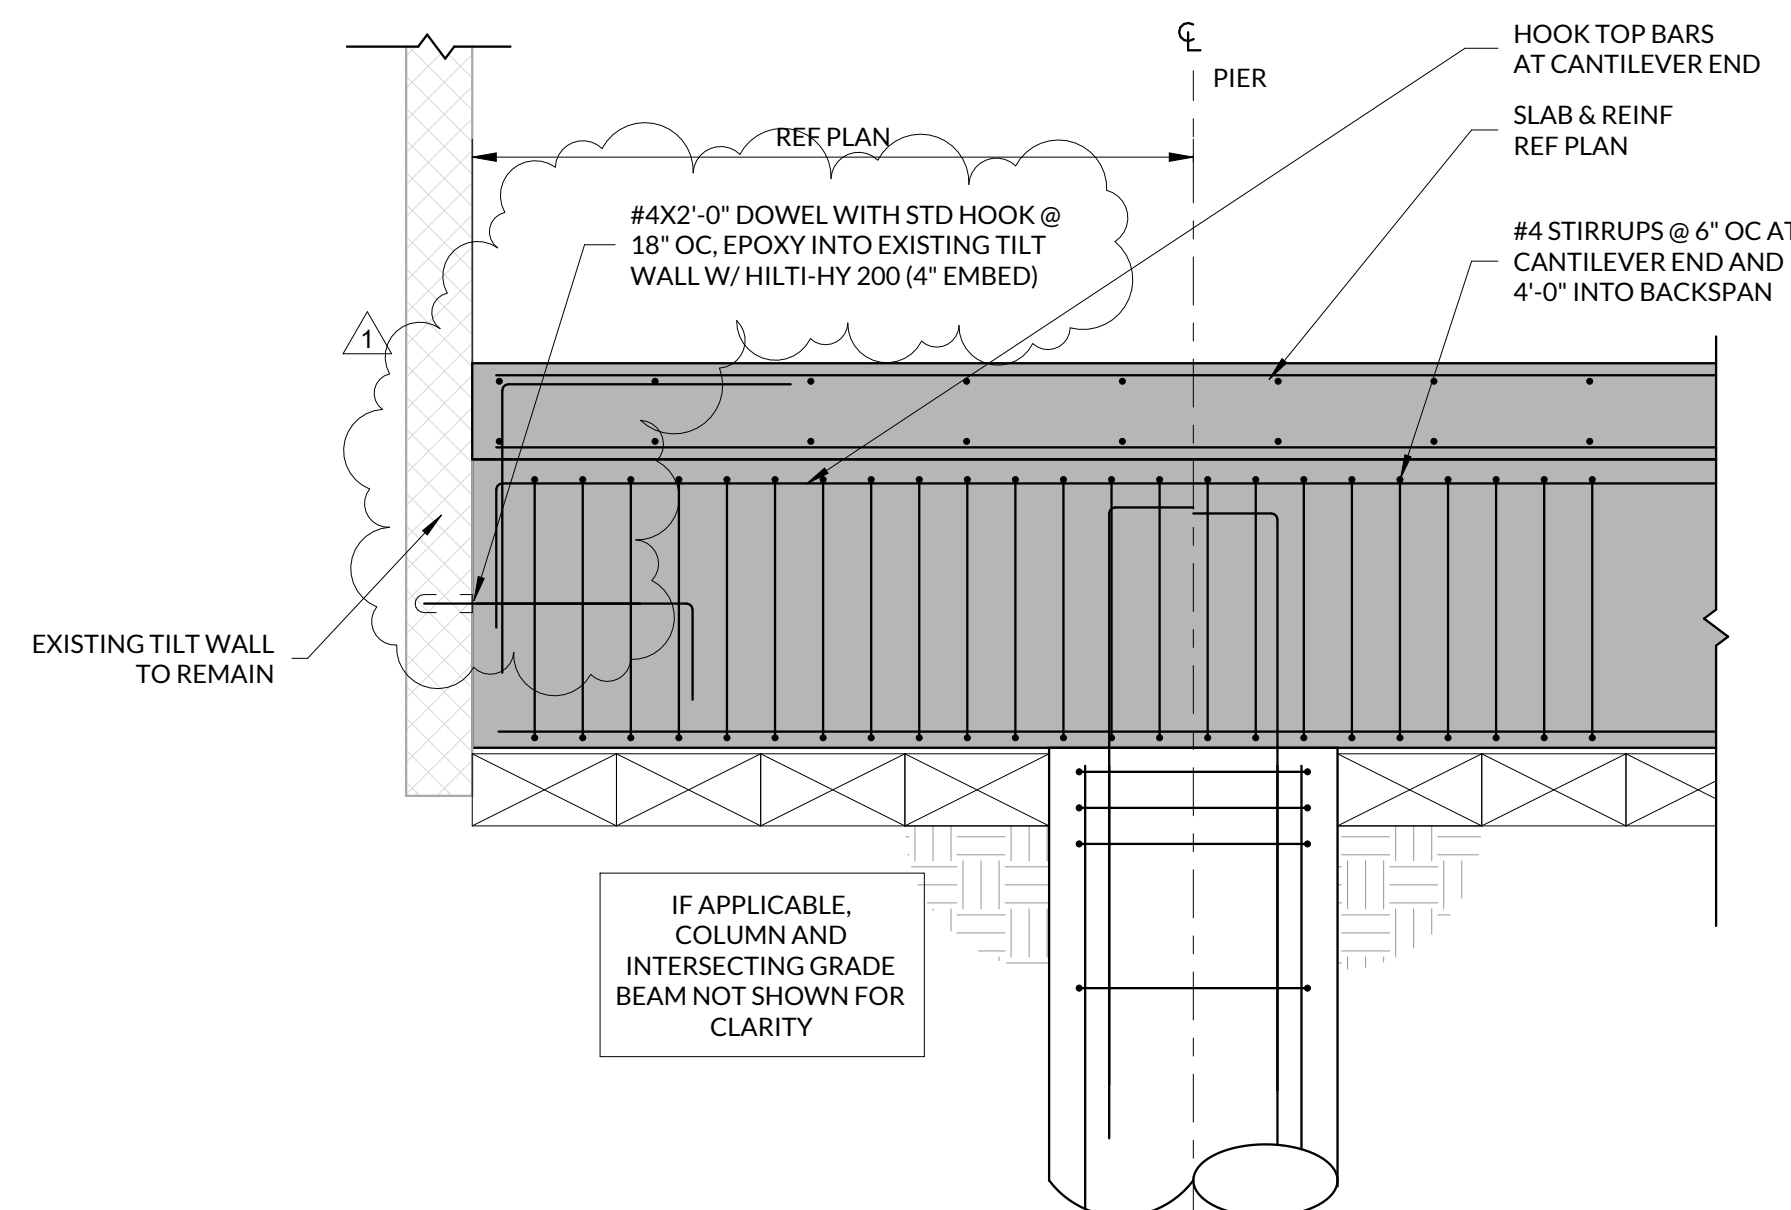

**8 DETAIL AT EXISTING TILT WALL**  
SCALE: 3/4" = 1'-0"

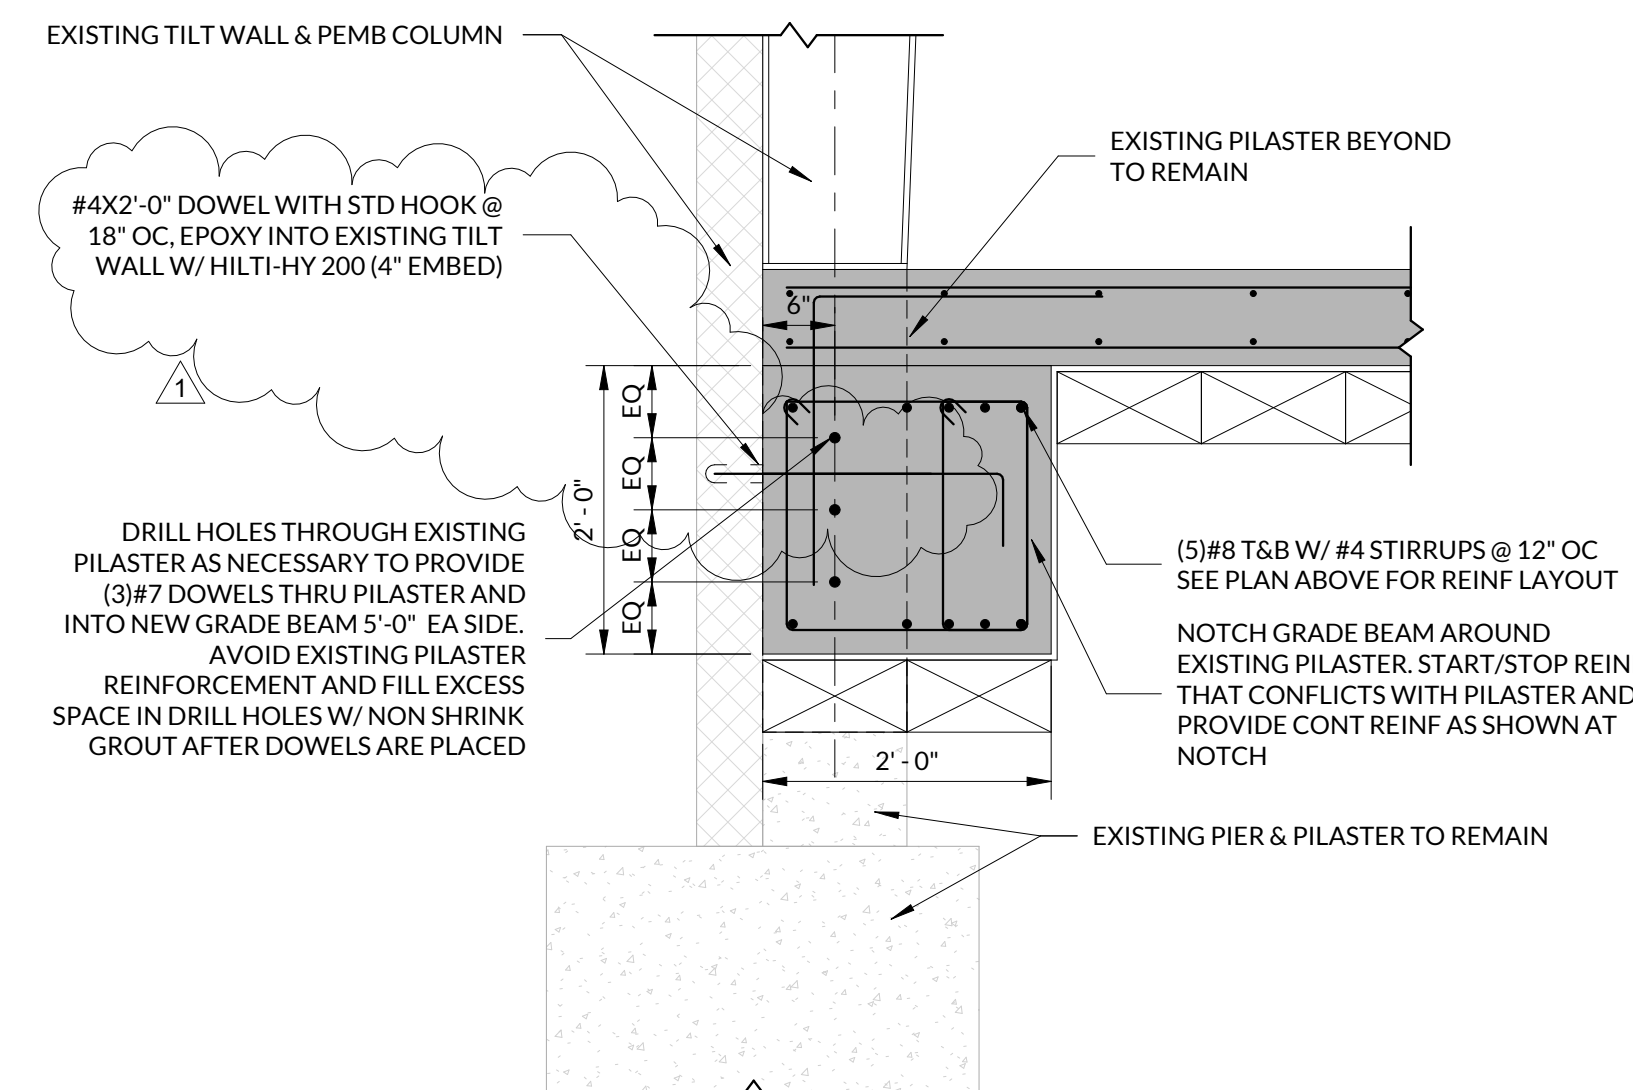


**6 DETAIL AT EXISTING PEMB FRAME**  
SCALE: 3/4" = 1'-0"








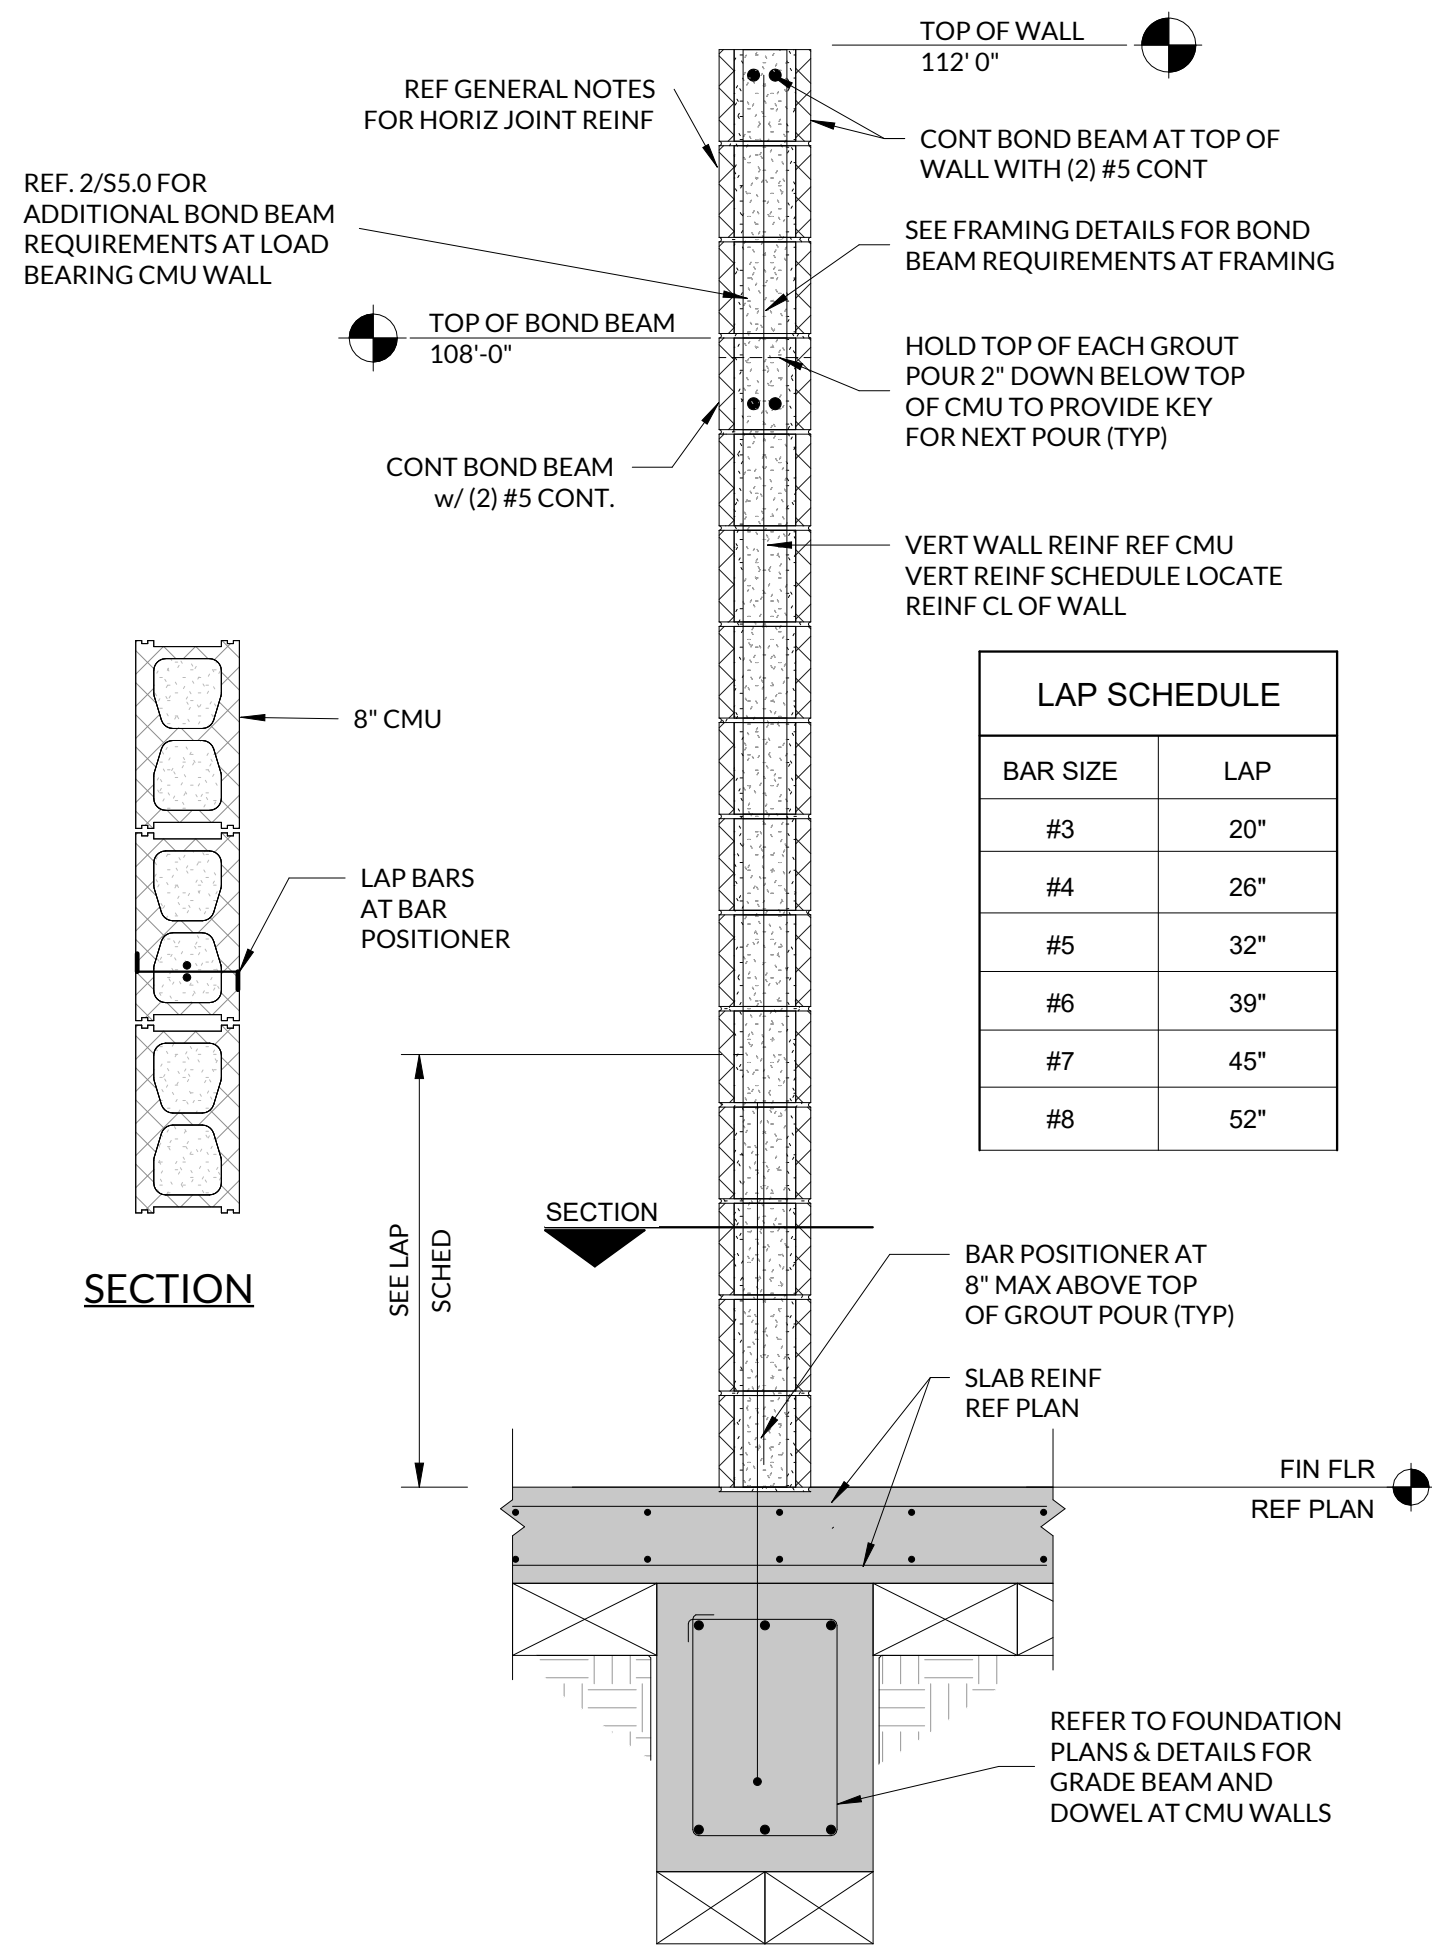


**1 INTERIOR 8" CMU REINFORCEMENT**  
SCALE: 3/4" = 1'-0"

- GENERAL NOTES:**
1. GROUT SOLID ALL CELLS WITH REINFORCING, AND ALL CELLS BELOW GRADE.
  2. ALL MASONRY SHALL BE LAID IN RUNNING (COMMON) BOND.
  3. REF CMU WALL VERT REINF SCHEDULE FOR VERTICAL REINF AND DOWELS.
  4. HORIZONTAL JOINT REINF SHALL BE SPACED AT 16" O.C. FULL HEIGHT OF WALL.

CMU WALL VERTICAL REINFORCING SCHEDULE	
WALL	REINFORCING
8"	1- #5 DOWEL @ 32" O.C. & 1- #5 VERT @ 2'-8" O.C.

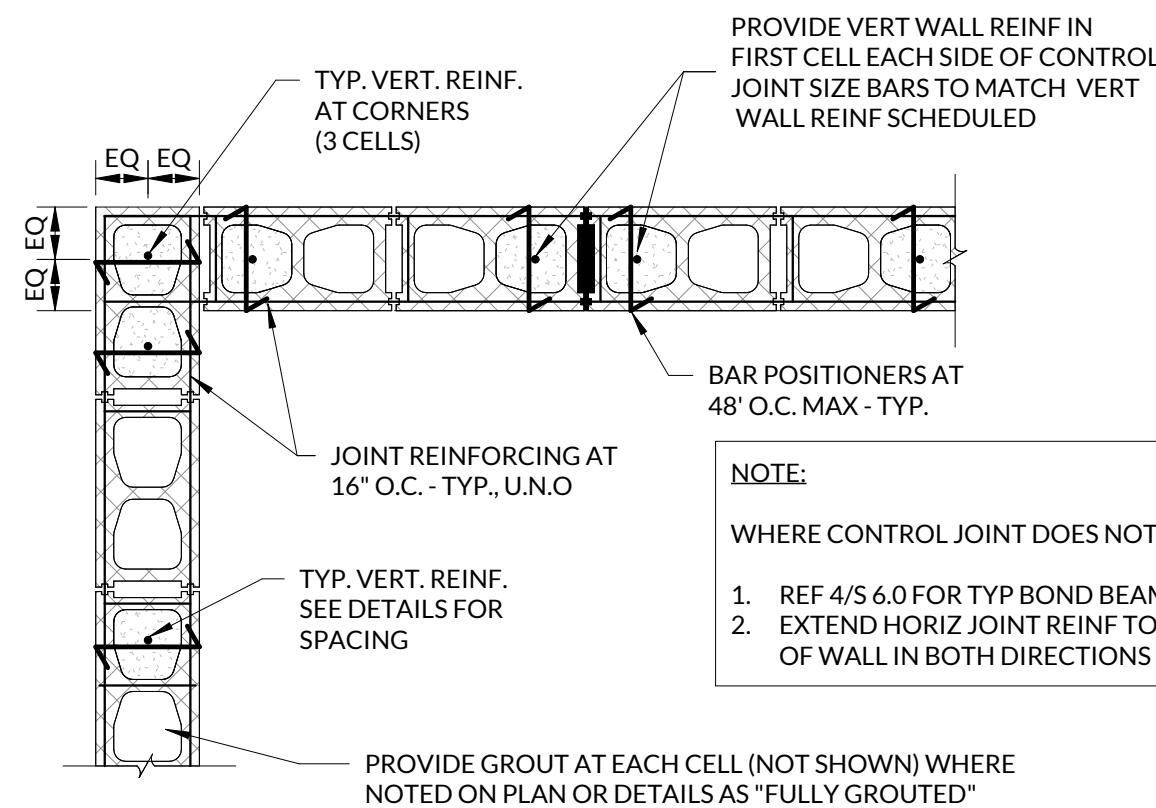


**3 8" TYPICAL CMU CORNER**  
SCALE: 3/4" = 1'-0"

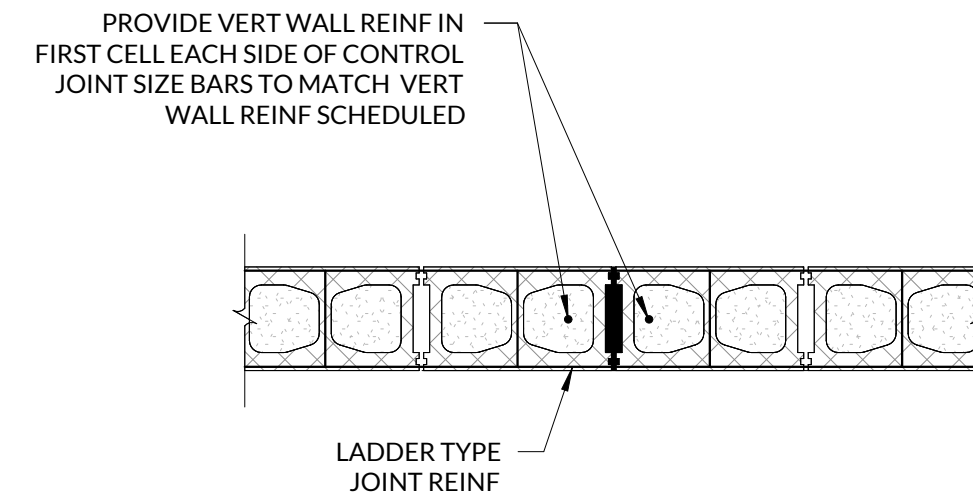


**2 8" CONTROL JOINT**  
SCALE: 3/4" = 1'-0"

- NOTE:**
1. CMU, GROUT, REINF BARS, AND JOINT REINF SHALL BE DISCONTINUOUS AT CONTROL JOINTS EXCEPT AT ROOF AND FLOOR LEVELS AND TOP OF WALLS.
  2. MAXIMUM CONTROL JOINT SPACING SHALL BE 25'-0". COORDINATE WITH CONTROL JOINT LOCATIONS SHOWN BY ARCHITECT.
  3. JOINTS SHALL BE PLACED A MINIMUM OF 2'-0" FROM ANY EDGES OF OPENINGS. THE FIRST JOINT FROM THE CORNER SHALL BE LOCATED AT A DISTANCE OF 1/2 THE HEIGHT OF THE WALL FROM THE CORNER. COORDINATE WITH CONTROL JOINT LOCATIONS SHOWN BY ARCHITECT.

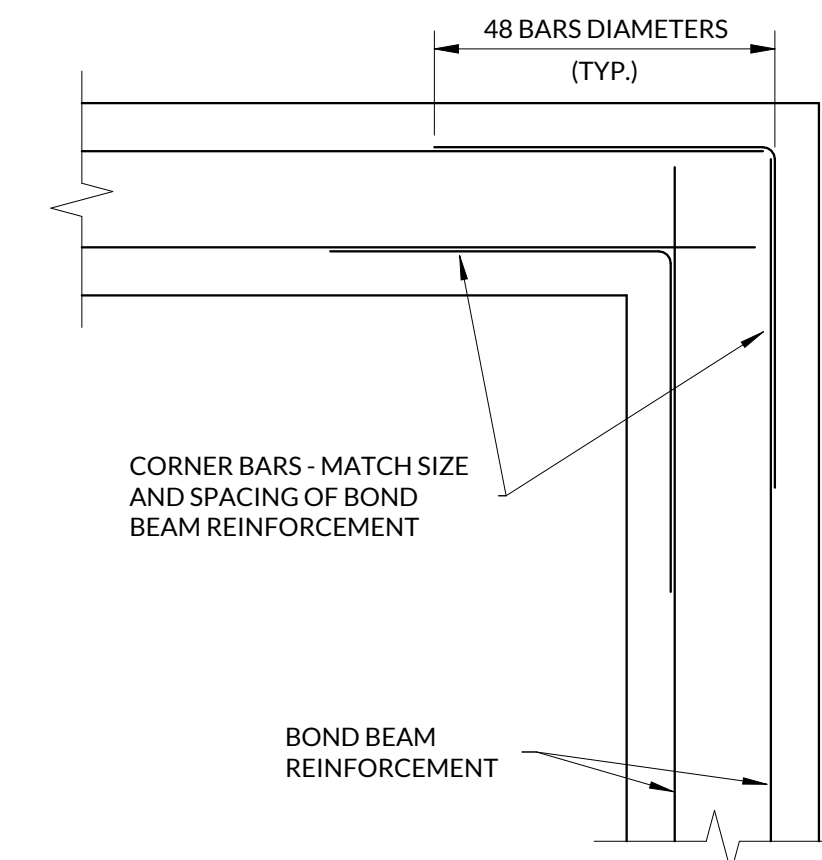

**4 TYPICAL BOND BEAM CORNER DETAIL**  
SCALE: 1" = 1'-0"



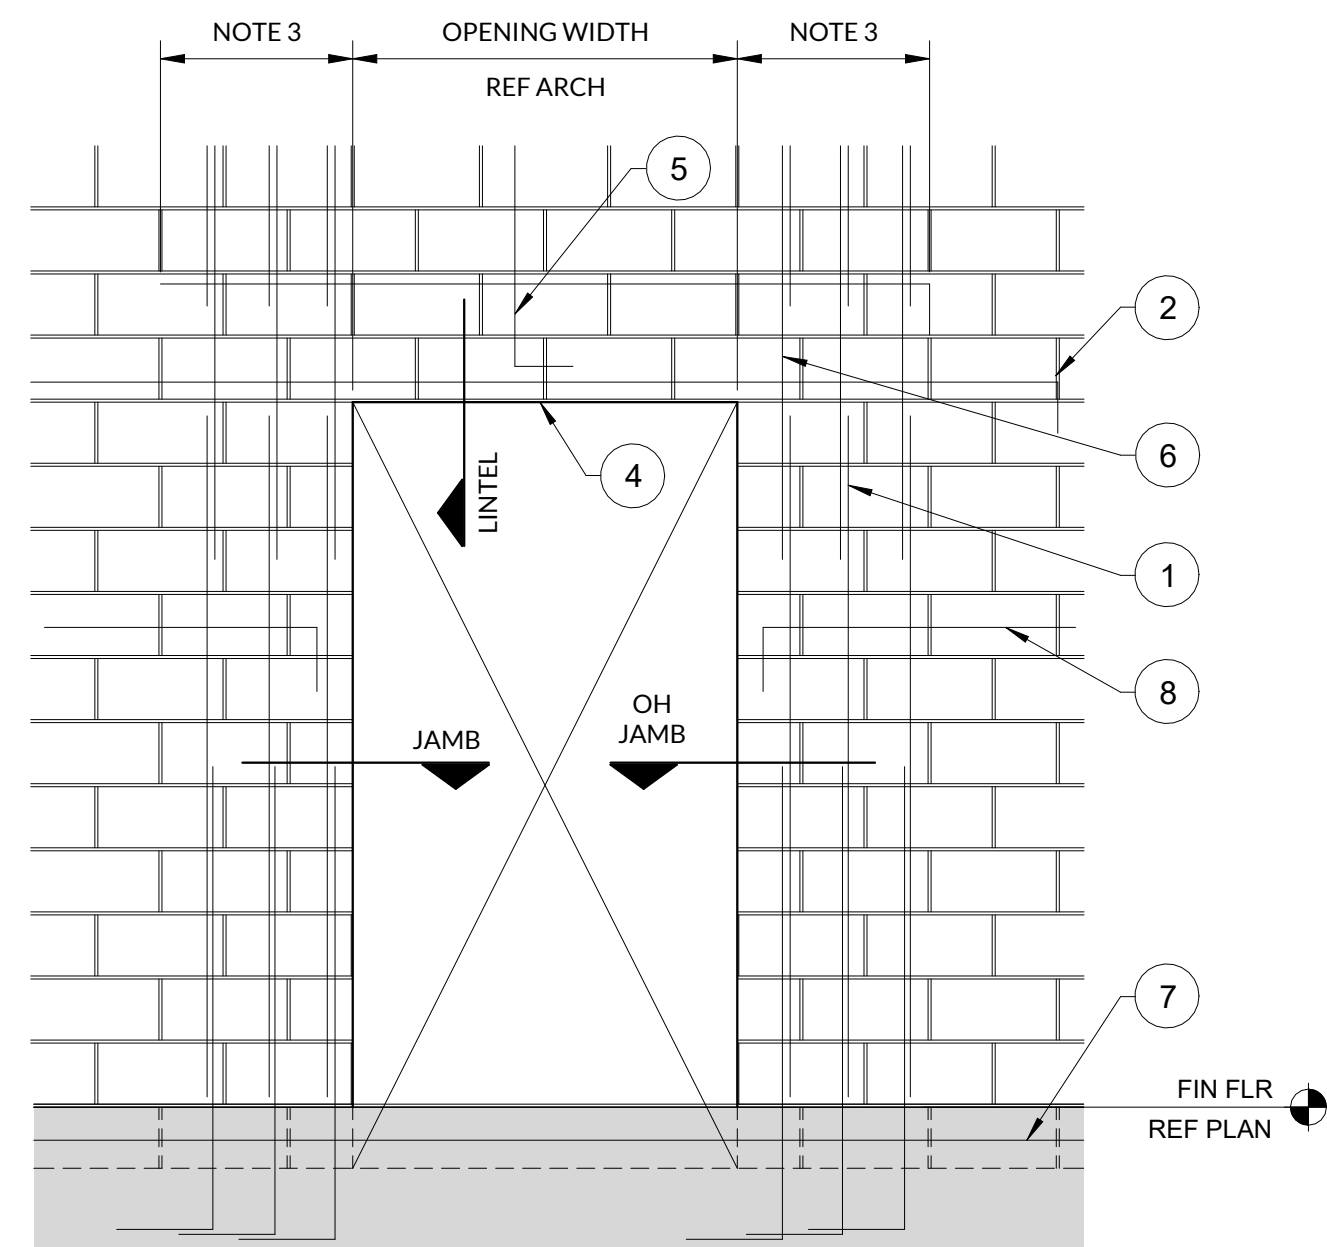


TYPICAL DOOR OPENING

**5 8" TYP MASONRY WALL OPENING DIAGRAM AND SCHEDULE**  
SCALE: 1/2" = 1'-0"

- NOTE:**
1. SPLICES IN VERT REINF REF CMU WALL REINF DIAGRAM.
  2. BOND BEAM REF CMU WALL REINF DIAGRAM.
  3. EXTEND GROUTED LINTEL A MINIMUM OF 2'-0" BEYOND FACE OF OPENING EACH SIDE FOR STRAIGHT LINTEL REINF AND 1'-0" FOR LINTEL REINF WITH STANDARD ACI HOOK.
  4. USE LINTEL BLOCKS ONLY FOR BOTTOM COURSE OF LINTEL BEAMS OVER OPENING.
  5. CONTINUE VERT WALL REINF OVER OPENING. ANCHOR VERT REINF INTO LINTEL BEAM WITH STANDARD ACI 90 DEG HOOK.
  6. ALL VERT BARS AT DOOR JAMBS TO BE FULL HEIGHT.
  7. #5 SILL REINF- SOLID GROUT SILL.
  8. WHERE HORIZONTAL REINF IS TERMINATED BY OPENING OR CONTROL JOINT PROVIDE STANDARD ACI HOOK WITH VERT WALL REINF IN THE END CELL.

CMU OPENING SCHEDULE					
WIDTH (W)	CLEAR SPAN	DEPTH (D)	BOTTOM REINF	TOP REINF	STIRRUPS AND SPACING
8"	UP TO 3'-4"	8"	1- #6	----	----
8"	3'-5" TO 7'-4"	1'-4"	1- #6	1- #6	#3 @ 8" OC
8"	7'-5" TO 12'-8"	2'-8"	2- #6	2- #6	#3 @ 8" OC

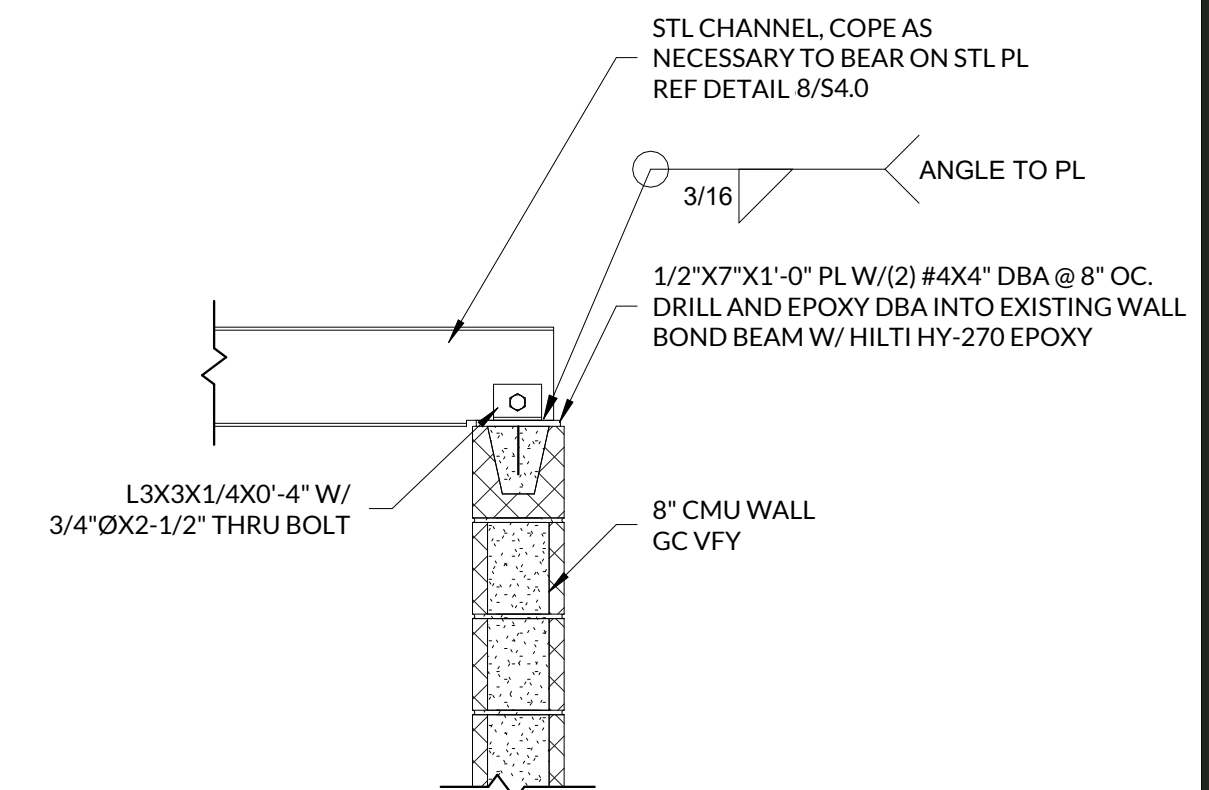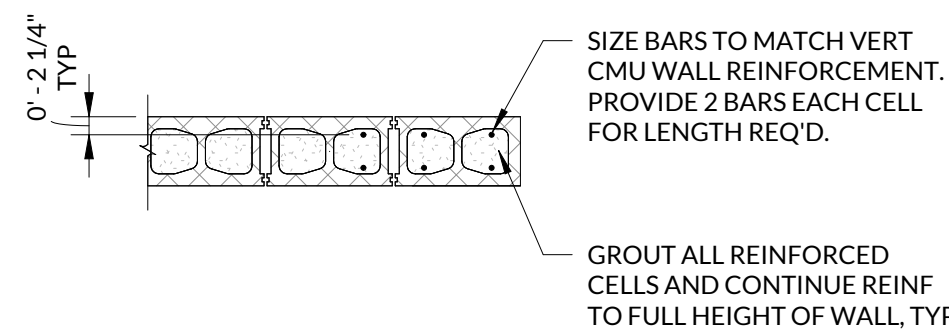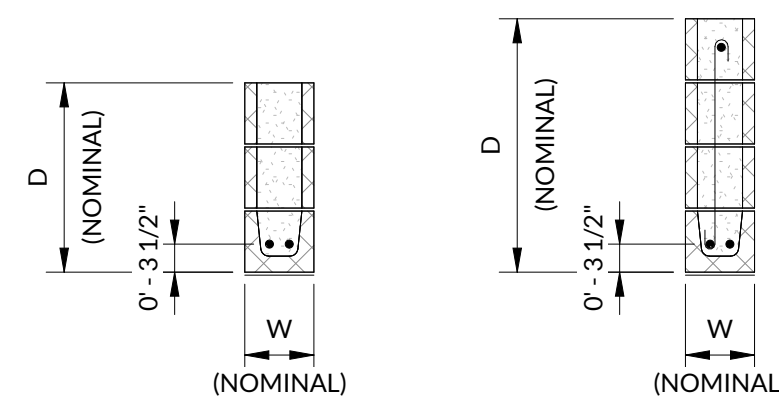

**7 CONNECTION AT EXISTING WALL**  
SCALE: 3/4" = 1'-0"



HAMILTON ISD  
ROCK GYM AND JH GYM RENOVATIONS  
TYPICAL 8 INCH CMU DETAILS

NO.	REVISION	DATE	PROJECT #	SCALE	As indicated
1	ADDENDUM 1	10/29/25	25327	SCALE	As indicated
SEQ.					